

S.S. N° 98.

MIDSHIP SECTION.

STEEL SCREW TRAWLER.

DIMS: 130'0"BP x 23'0" x 13'0" MLD.

TO CLASS 100 A.I. LLOYDS FOR FISHING PURPOSES.

SCALE 1/2" = 1 FOOT.




EQUIPMENT N° 5848.

| | | | |
|-----|--------|------------|------------------|
| 1 | ANCHOR | 7-0-21 | STOCKLESS. |
| 1 | " | 5 1/4 CWTs | EX STOCK |
| 1 | " | 3 | " |
| 105 | FTMS | 1 1/6" | STUD LINK CHAIN. |
| 60 | FTMS | 6" | HAWSER. |
| 60 | FTMS | 5" | HARP. |

NUMERALS

| | |
|------------|---------|
| HALF GIRTH | 20.38 |
| BREADTH | 11.5 |
| DEPTH | 13.5 |
| 1ST N° | 45.38 |
| LENGTH | 128.87 |
| 2ND N° | 5848.12 |

D to 2 9.5
B to 2 5.6

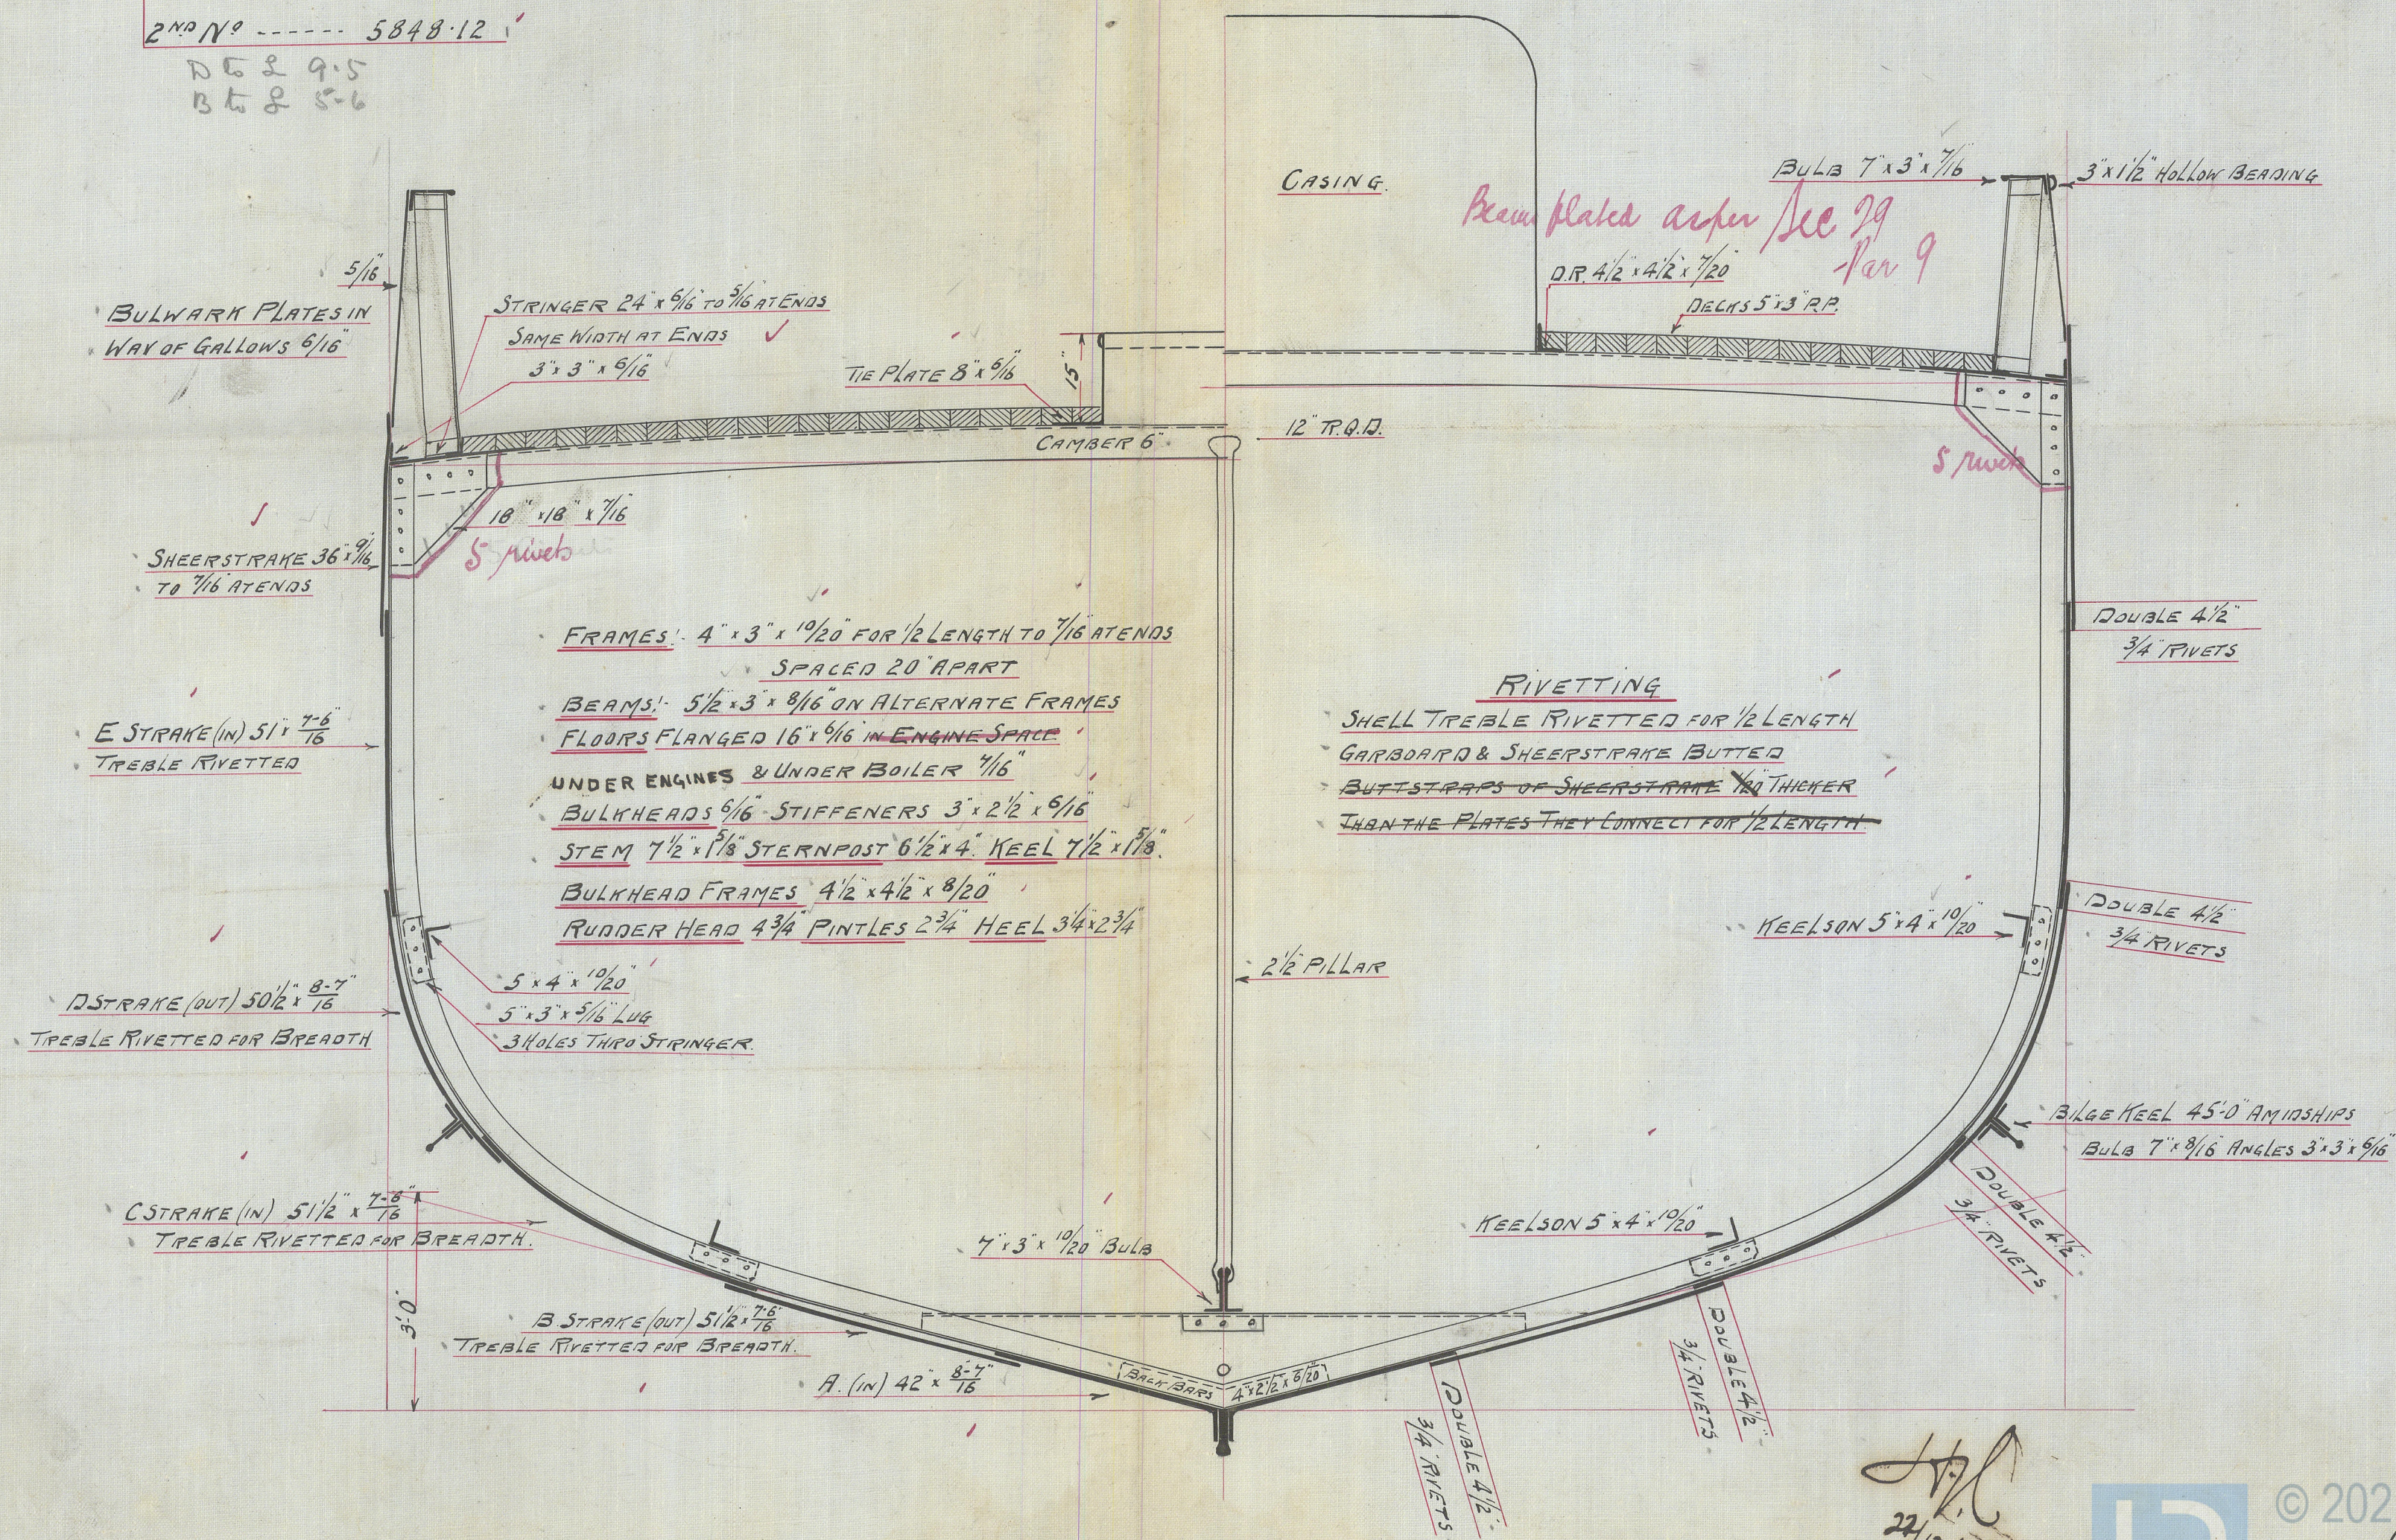

22/12/06



© 2021
Lloyd's Register
Foundation

W817-0028

Escoe S. & P. Co.

No. 98.

Midship Section.

s/s 'Onphesia'

Hull Report No



RETAIN



© 2021

Lloyd's Register
Foundation

W817-0028