


22.12.06

S.S. N° 98.

ELEVATION

DIMS: 130'-0" B.P. x 23'-0" x 13'-0" M.L.D.

Scale 1/4" = 1 Foot

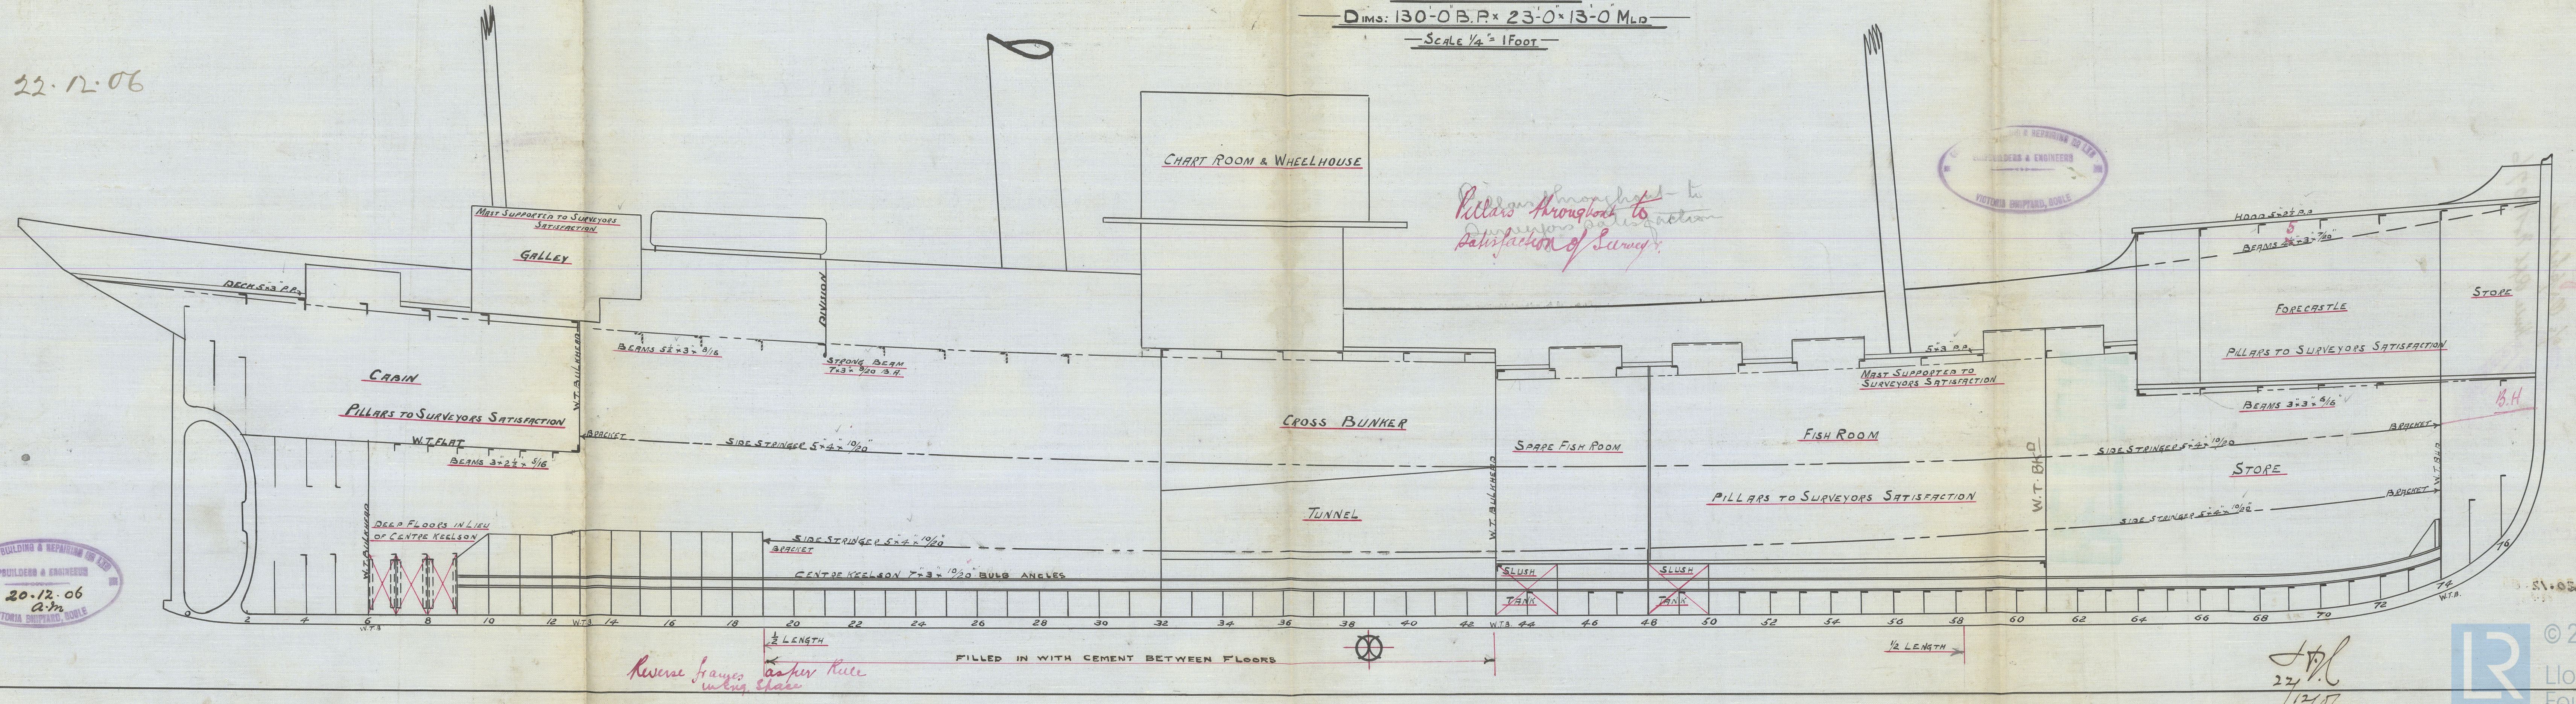

Handwritten notes in red ink: 'Pillars throughout to satisfaction of Survey', 'Pillars to Surveyors Satisfaction', 'DECK 5 x 3 A.P.', 'Mast supported to Surveyors Satisfaction', 'W.T. BULKHEAD', 'BRACKET', 'SLUSH TANK', 'FILLED IN WITH CEMENT BETWEEN FLOORS', and 'Reverse frames as per Rule'.

Handwritten signature and date: J.V.L. 22/12/06

Isaac S. & R. Co.

No 98

Profile.

s/s Orphesia

Mule Rpt No 19076

RETAIN



© 2021

Lloyd's Register
Foundation