


6.5.07

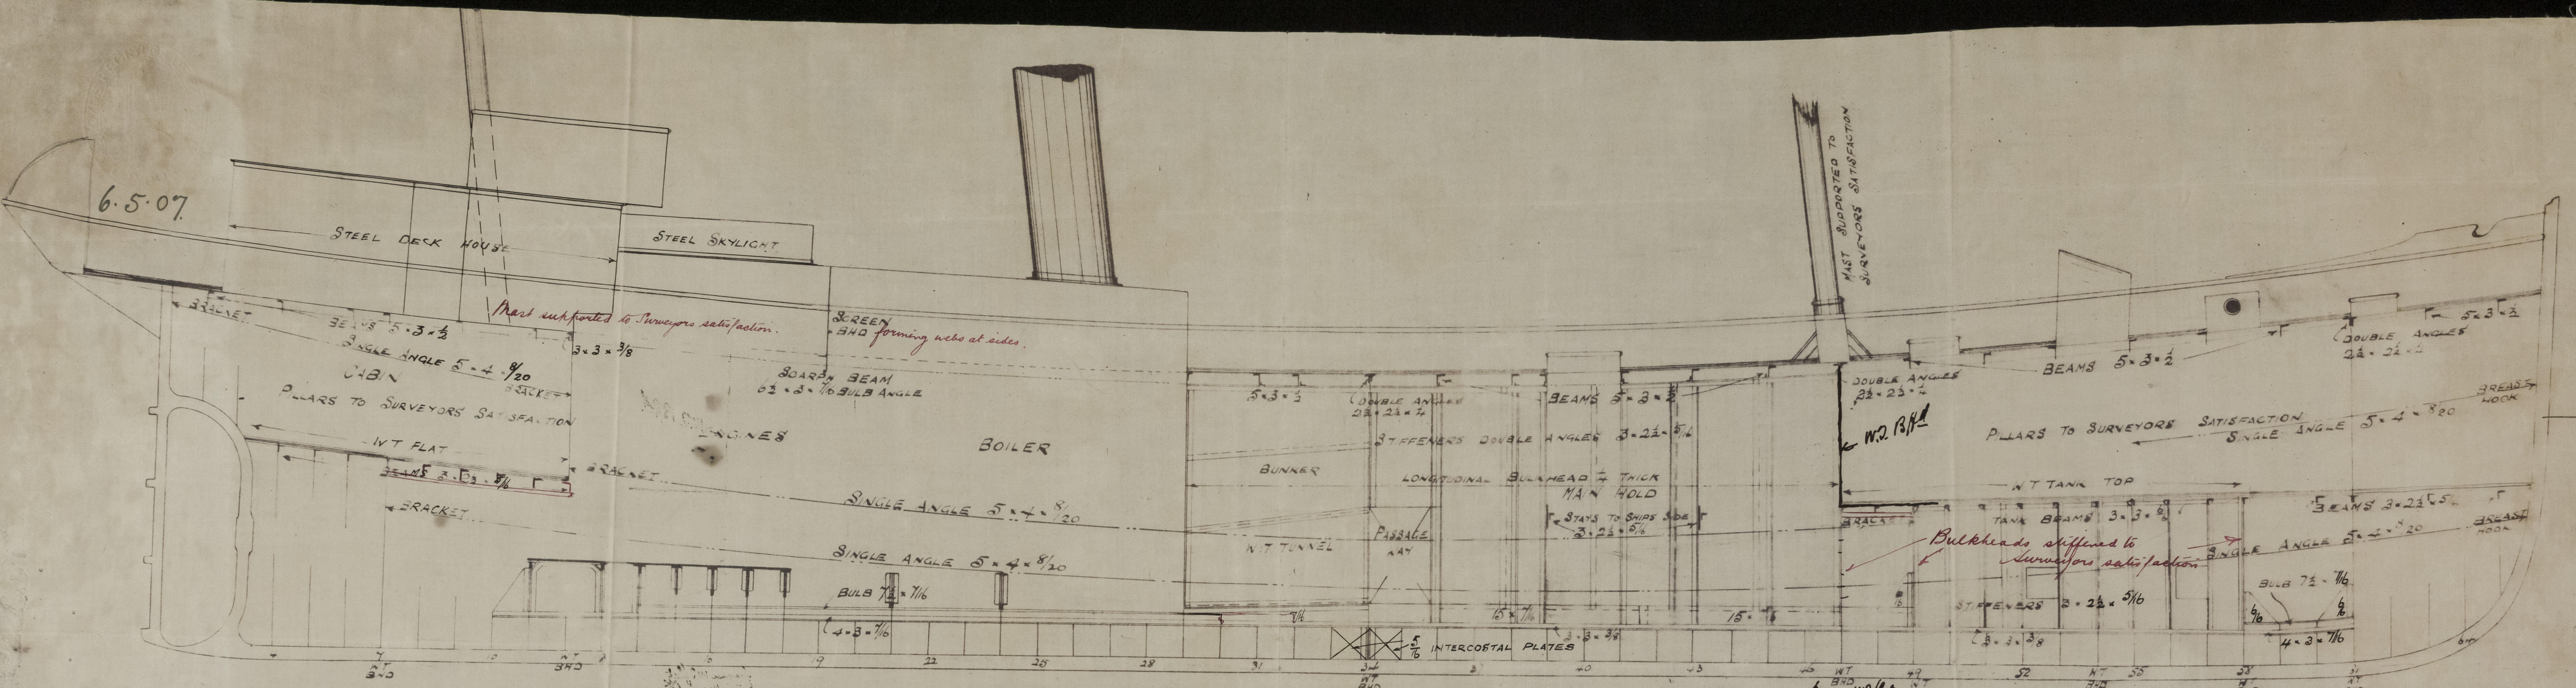


BEAM ARRANGEMENT

PILLARS TO SURVEYORS SATISFACTION
SCALE 1/4" = ONE FOOT

NOS 152-3 & 6

MESSRS COOK, WELTON & GEMMELL
SHIPBUILDERS
BEVERLEY
DATE SUBMITTED MAY 1ST 07
DATE APPROVED

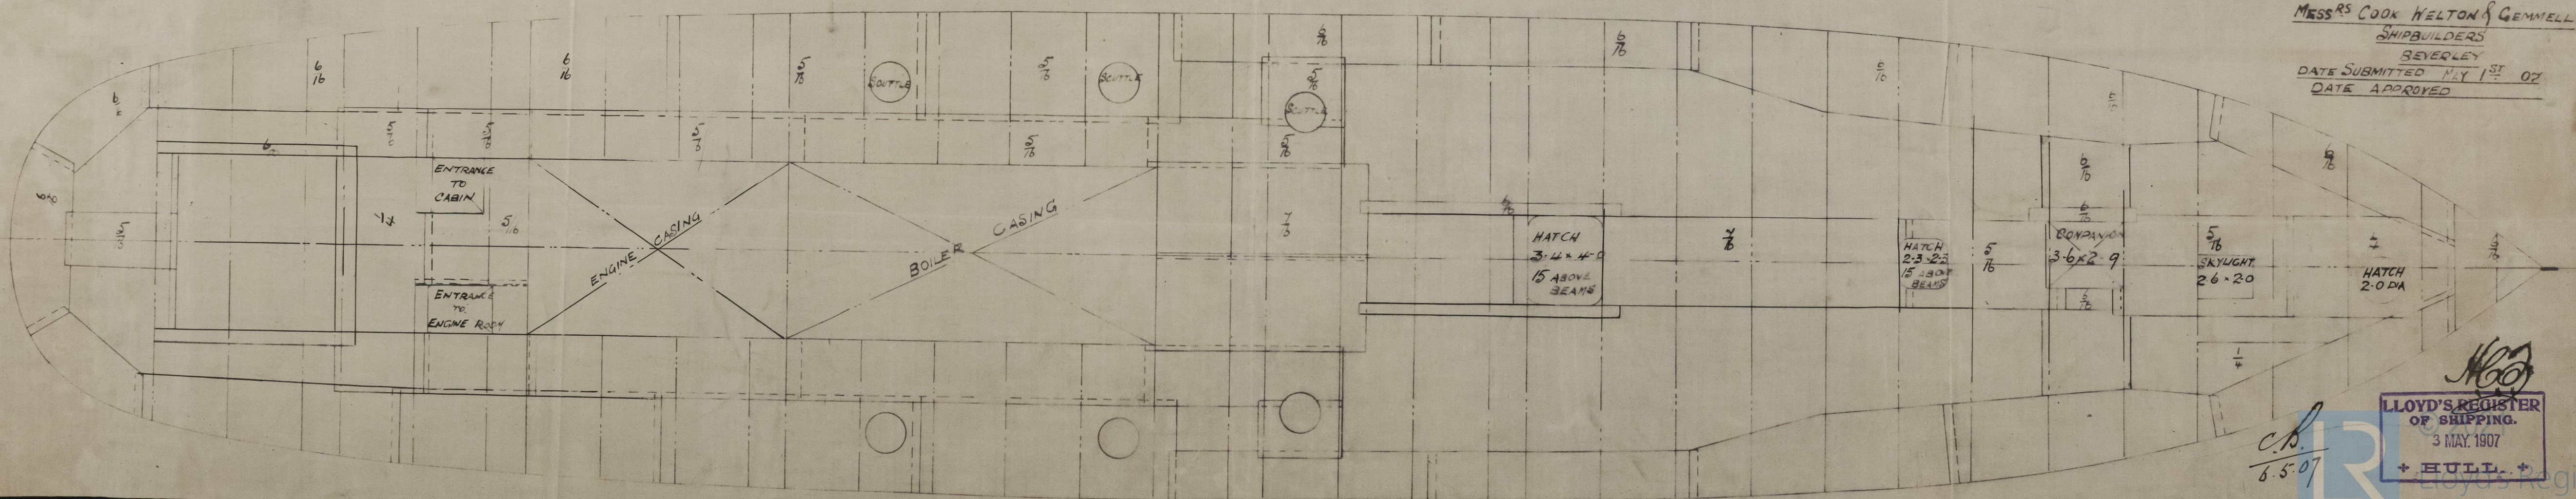


6.5.07

LLOYD'S REGISTER OF SHIPPING.
3 MAY 1907
+ HULL +

W818-029

Profile & Deck Plan -
Cook, Melton & Simmell & Co
No 152 - 153 & 156

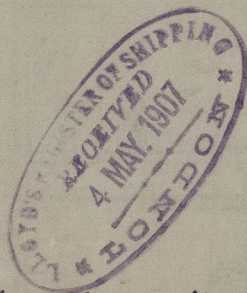

of O'Kellys. Hull Rpt No. 19424

" Jago - - -
" Mopsa - - -

RETAIN



© 2021

Lloyd's Register
Foundation

W818 - 0129