



6.6.12
1.8.12
26.9.12
13.11.12
3.1.13
8.7.13
18.10.13
10.7.14
31.1.14

 

S.S. No. 436. LONGITUDINAL ELEVATION.

745'-0" x 86'-0" x 48'-0" K.T.O.B.

SCALE 1/8" = 1'-0"

 

PLAN OF HOLD.

* To be considered in conjunction with section when detailed plan of after framing is submitted.

* To be considered when detailed plan of framing is submitted.

1/12


Harland & Wolff

No 1736

Profile & Deck plan

S.S. "JUSTICIA"
BEL. 7791.

REMAIN

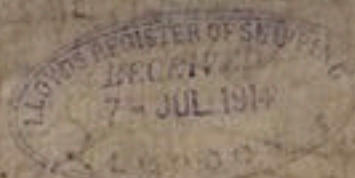

© 2018
Lloyd's Register
Foundation