

Harland & Wolff Ltd

No 436





S.S. Justicia

Bel. 7791.

Amended Midship Section 7791.

S.S. Justicia

Bel. 7791.

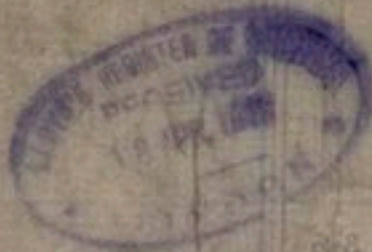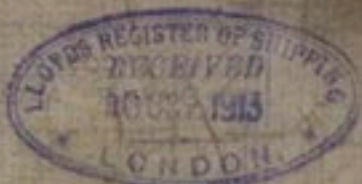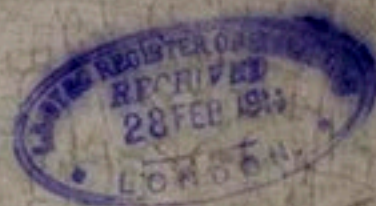 

RETAIN



© 2018
Lloyd's Register
Foundation