


25.2.04
3.3.04
30.3.04

— PROFILE AND DECK PLAN —
— S.S. No. 30. DIMNS 36'0" x 23'0" x 10'92" M.L.D. —
— TO CLASS LLOYDS 100A1 STEEL —
— UNDER TONNAGE COEFFICIENT ABOUT .76 —
SCALE 1/4" INCH = 1' FOOT.

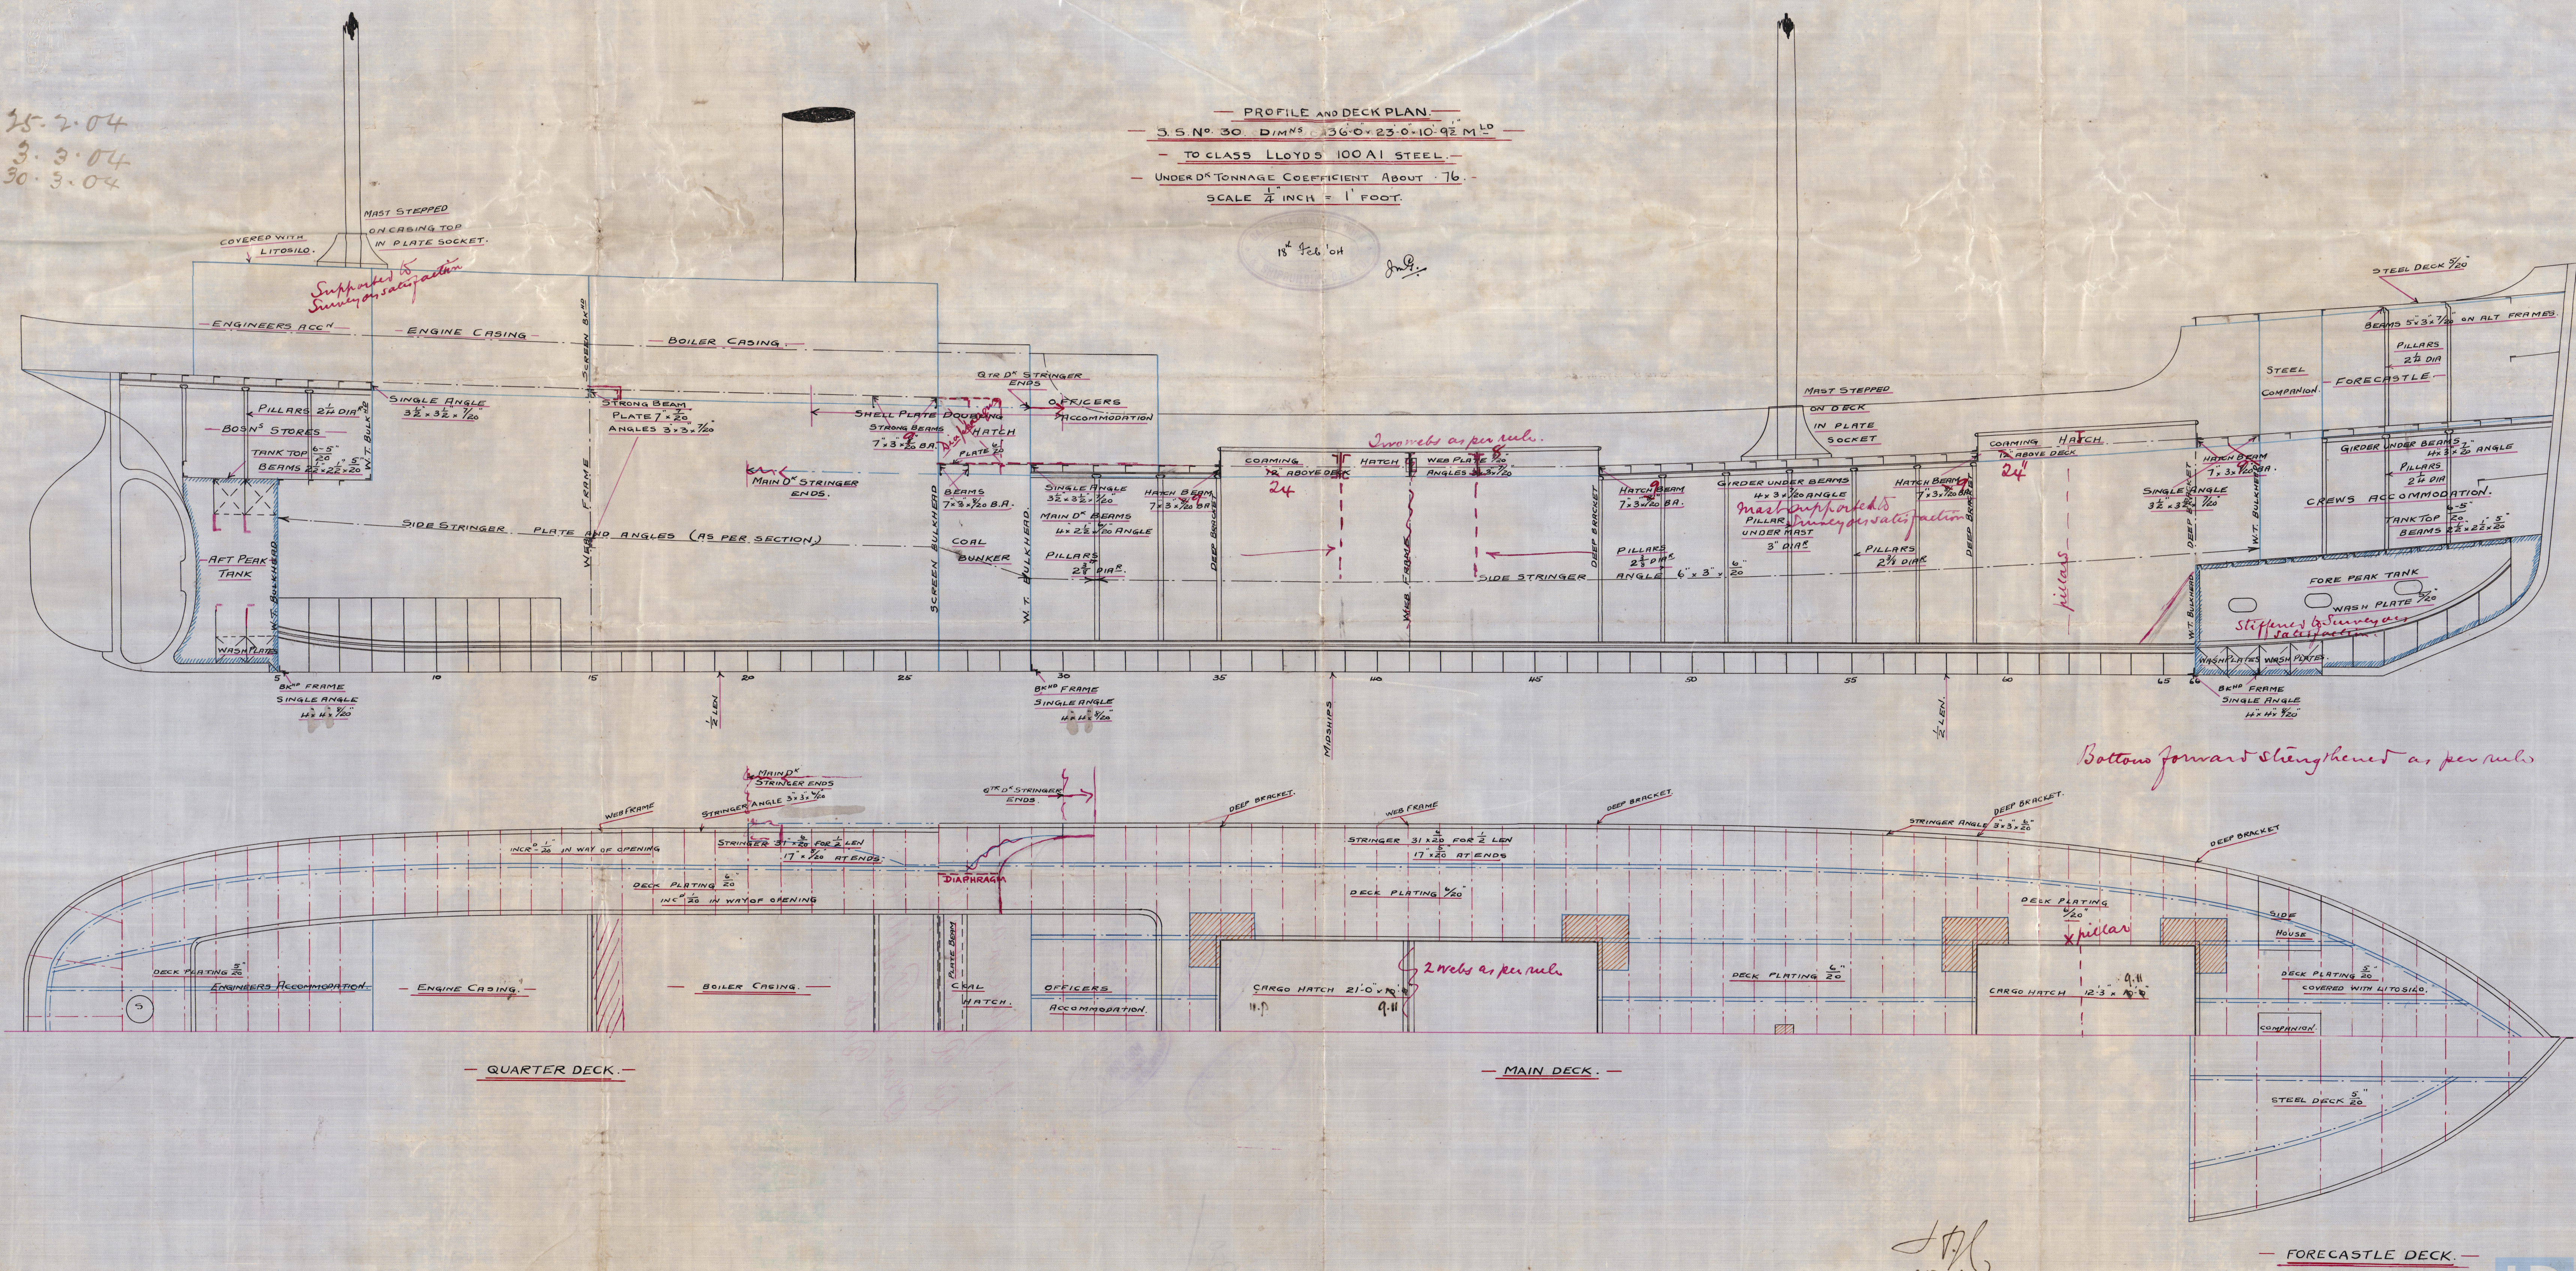

30

S. & Juverna
Liv Rpt. No. 54950
Plan of Profile &
Deck

RETAIN



© 2020

Lloyd's Register
Foundation

W89-0152