


Nº 436.
MIDDLE DECK

Note. Where Tr. T. B.H.s are "stepped", deck plating is in no case to be of less thickness than is req'd for B.H.s in same range.
and no openings to be made in V.T. Plots.

Vertical Lugs on all Beams
Which have no Brackets.

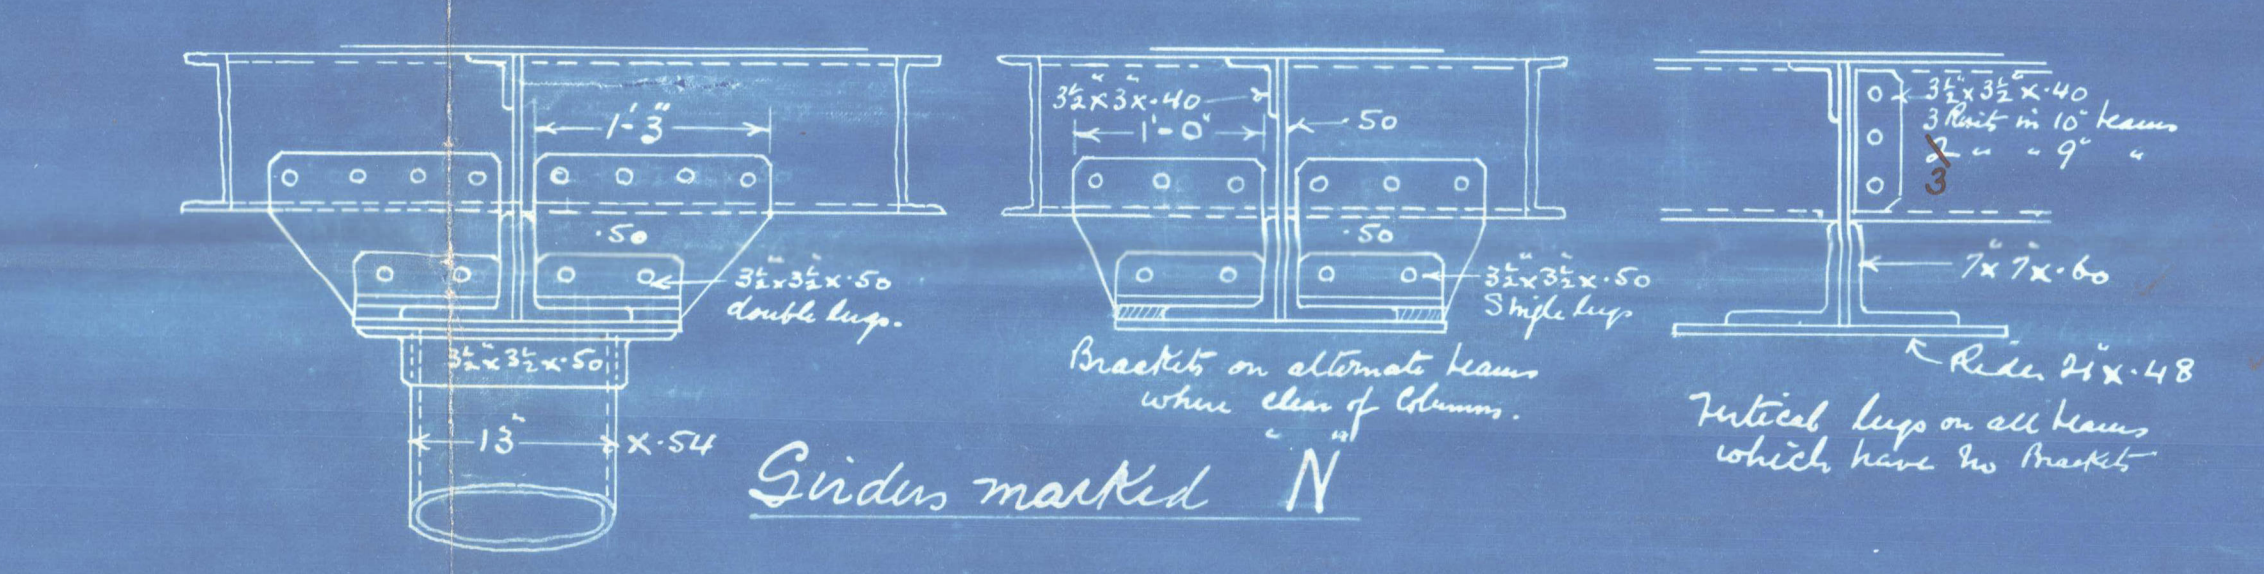


Harland & Wolff Lim

Nº 436

SS. Justicia Bel 7791 Plan
Middle Deck Plan



RETAIN



© 2020

Lloyd's Register
Foundation