
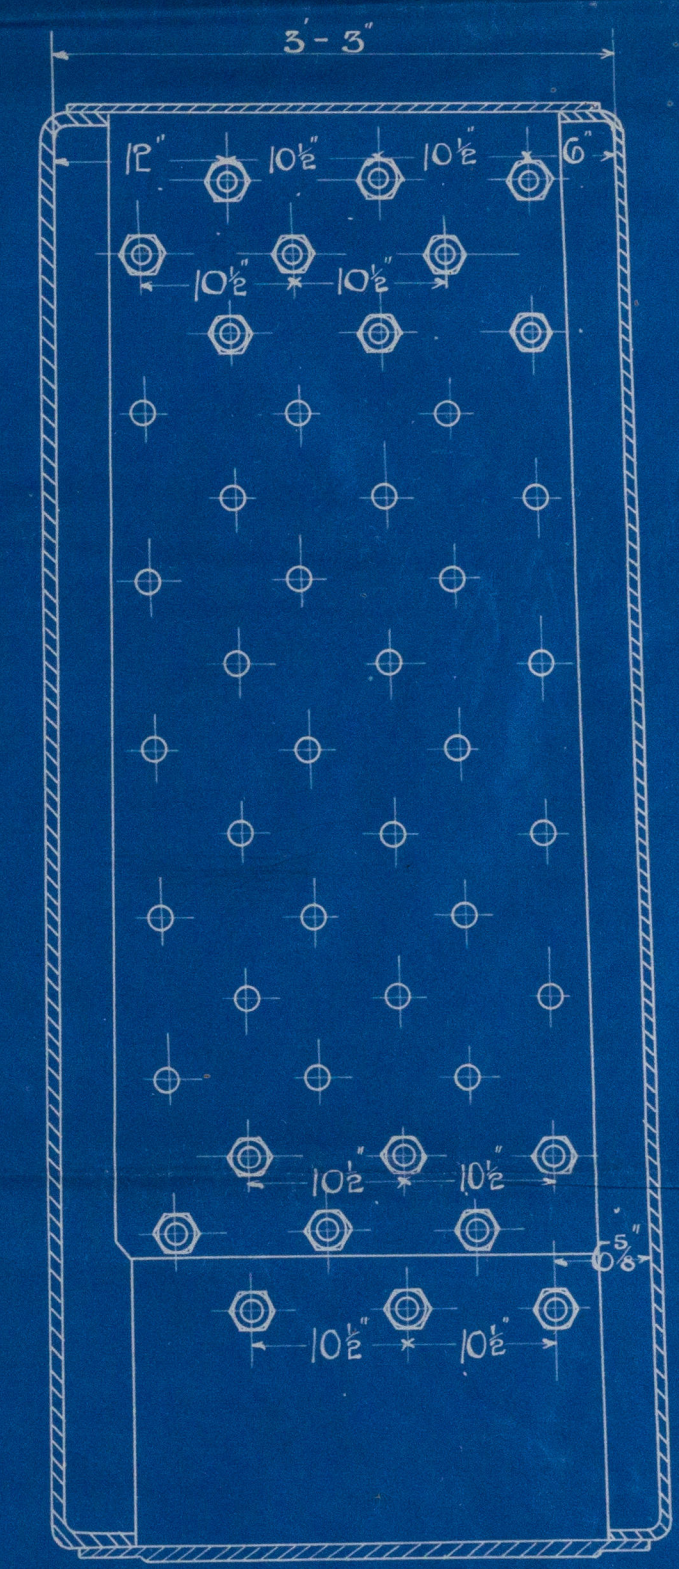


No. 488  
 Date 16/9/10  
 Drawn by J. J. Gray  
 Checked by

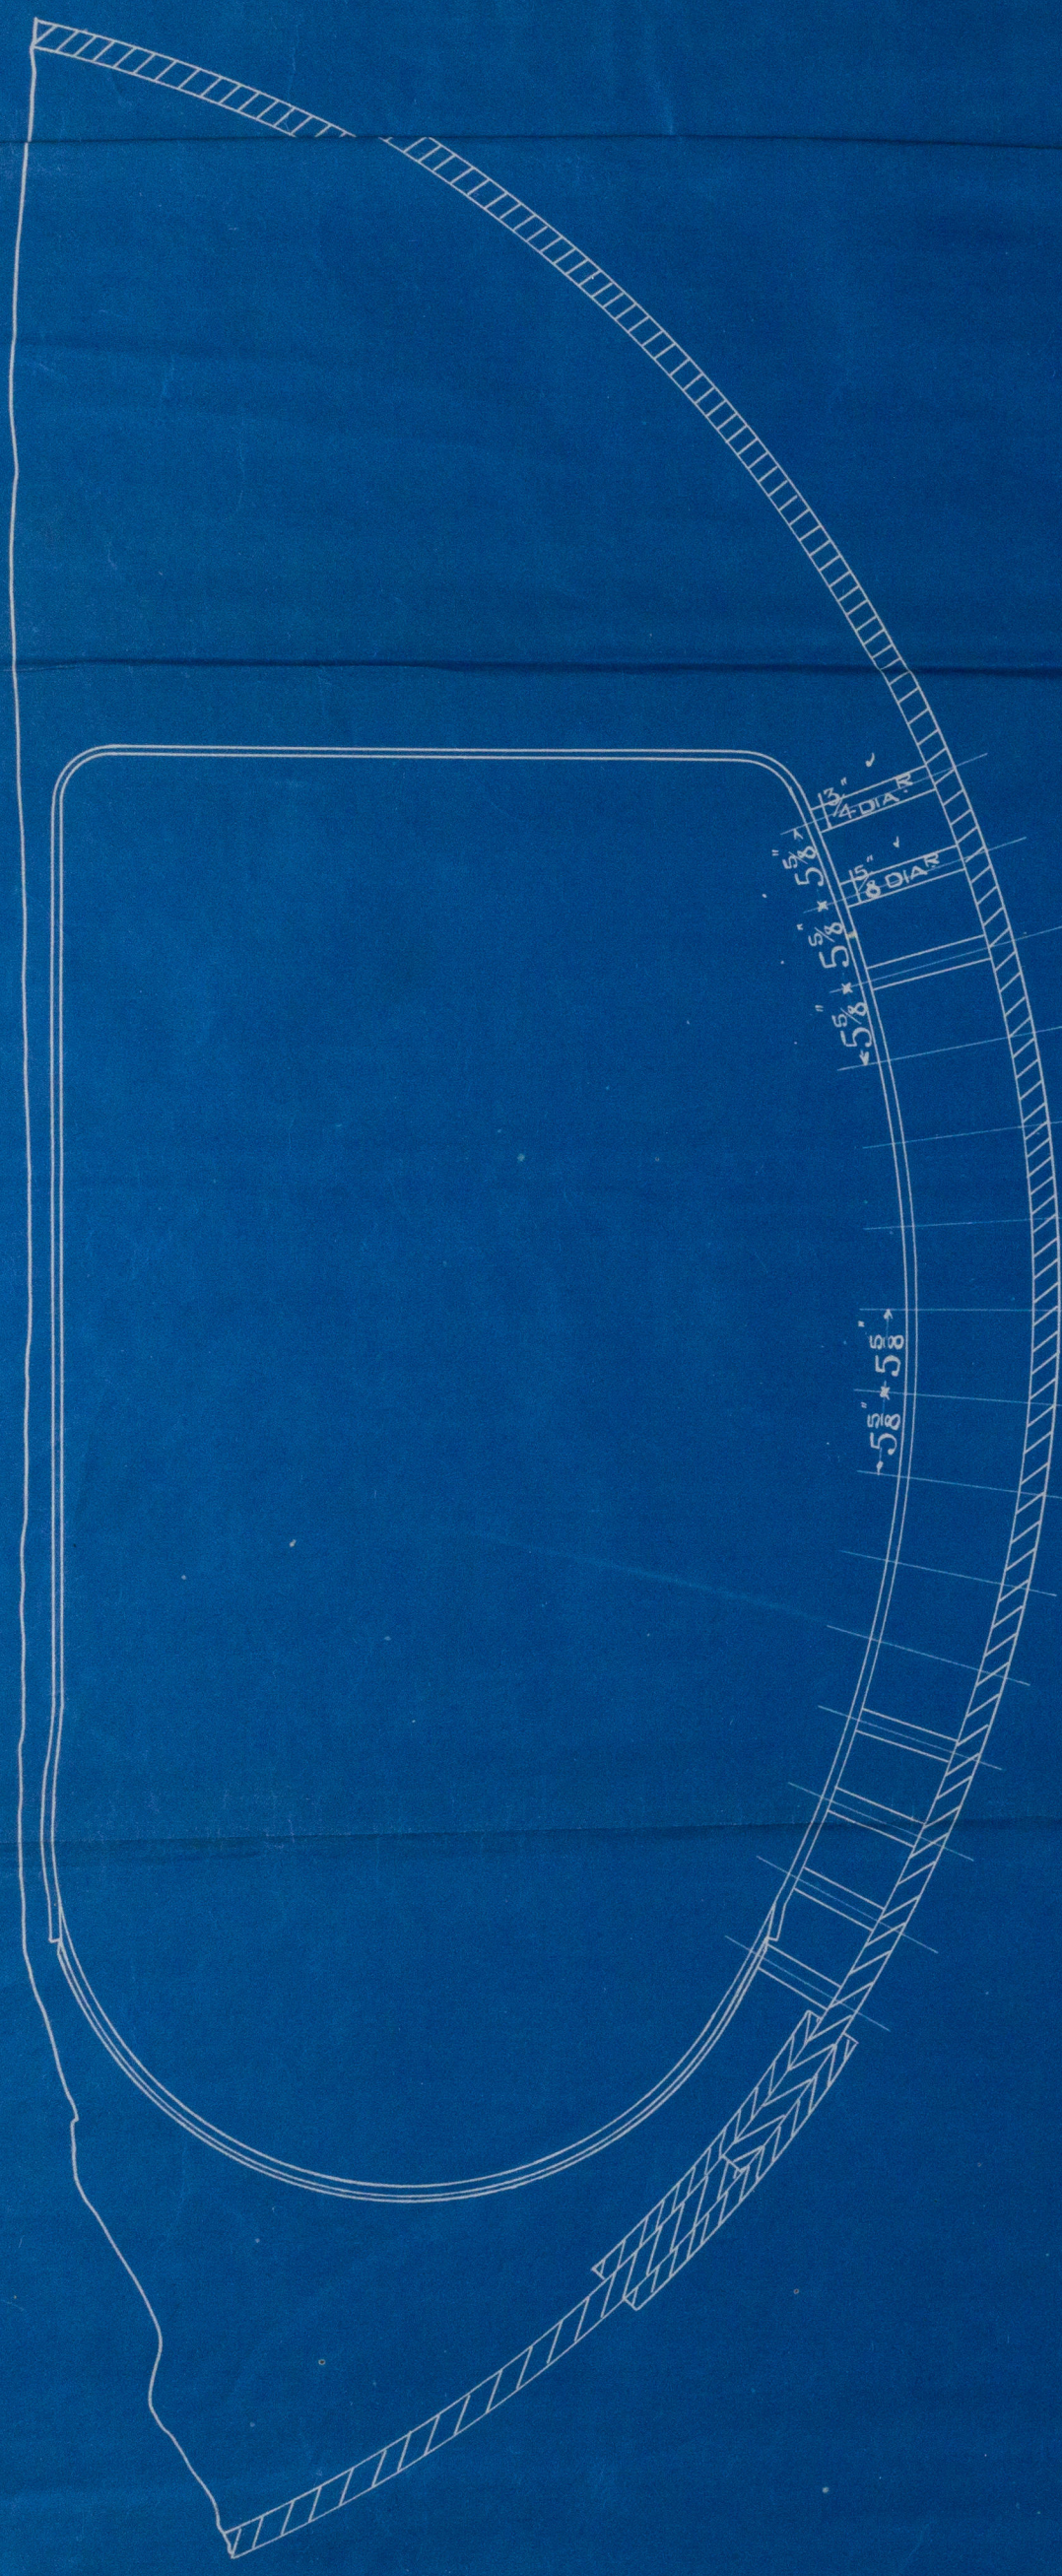


Back of FIREBOX.

Amended Plan of Stays  
 to Wing Chamber Sides.  
**BOILERS FOR T. S. N°488.**

SKETCH OF STAYING WING FIREBOX SIDES.

SCALE 1" = 1 FOOT.

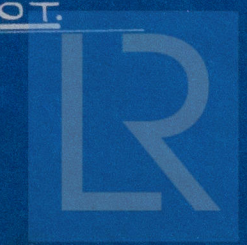

21st  
 Foundation

W82-0721