

W823-0222

Milton Bish

midship section




No. 254-263-264

Nagasaki


8/5. Looli. (No 254) Nag. 1095-

- War Jane. (263) Nag 1154

- War nymph. (264) Nag 1168

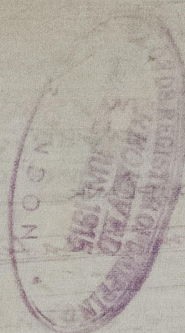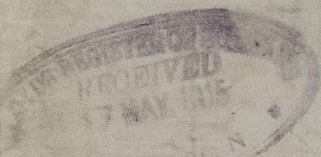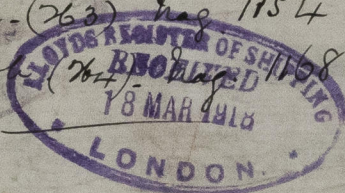

RETAIN

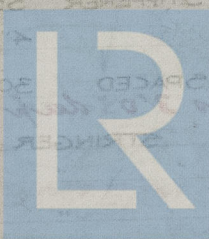

© 2021

Lloyd's Register
Foundation