



"LANGSTAND"
 TROFILE
 No 780
 SMITH'S DOCK CO.

Nº 780.
ELEVATION.
SCALE $\frac{1}{4}$ " = 1 FOOT.

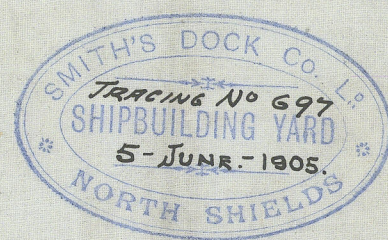

gw

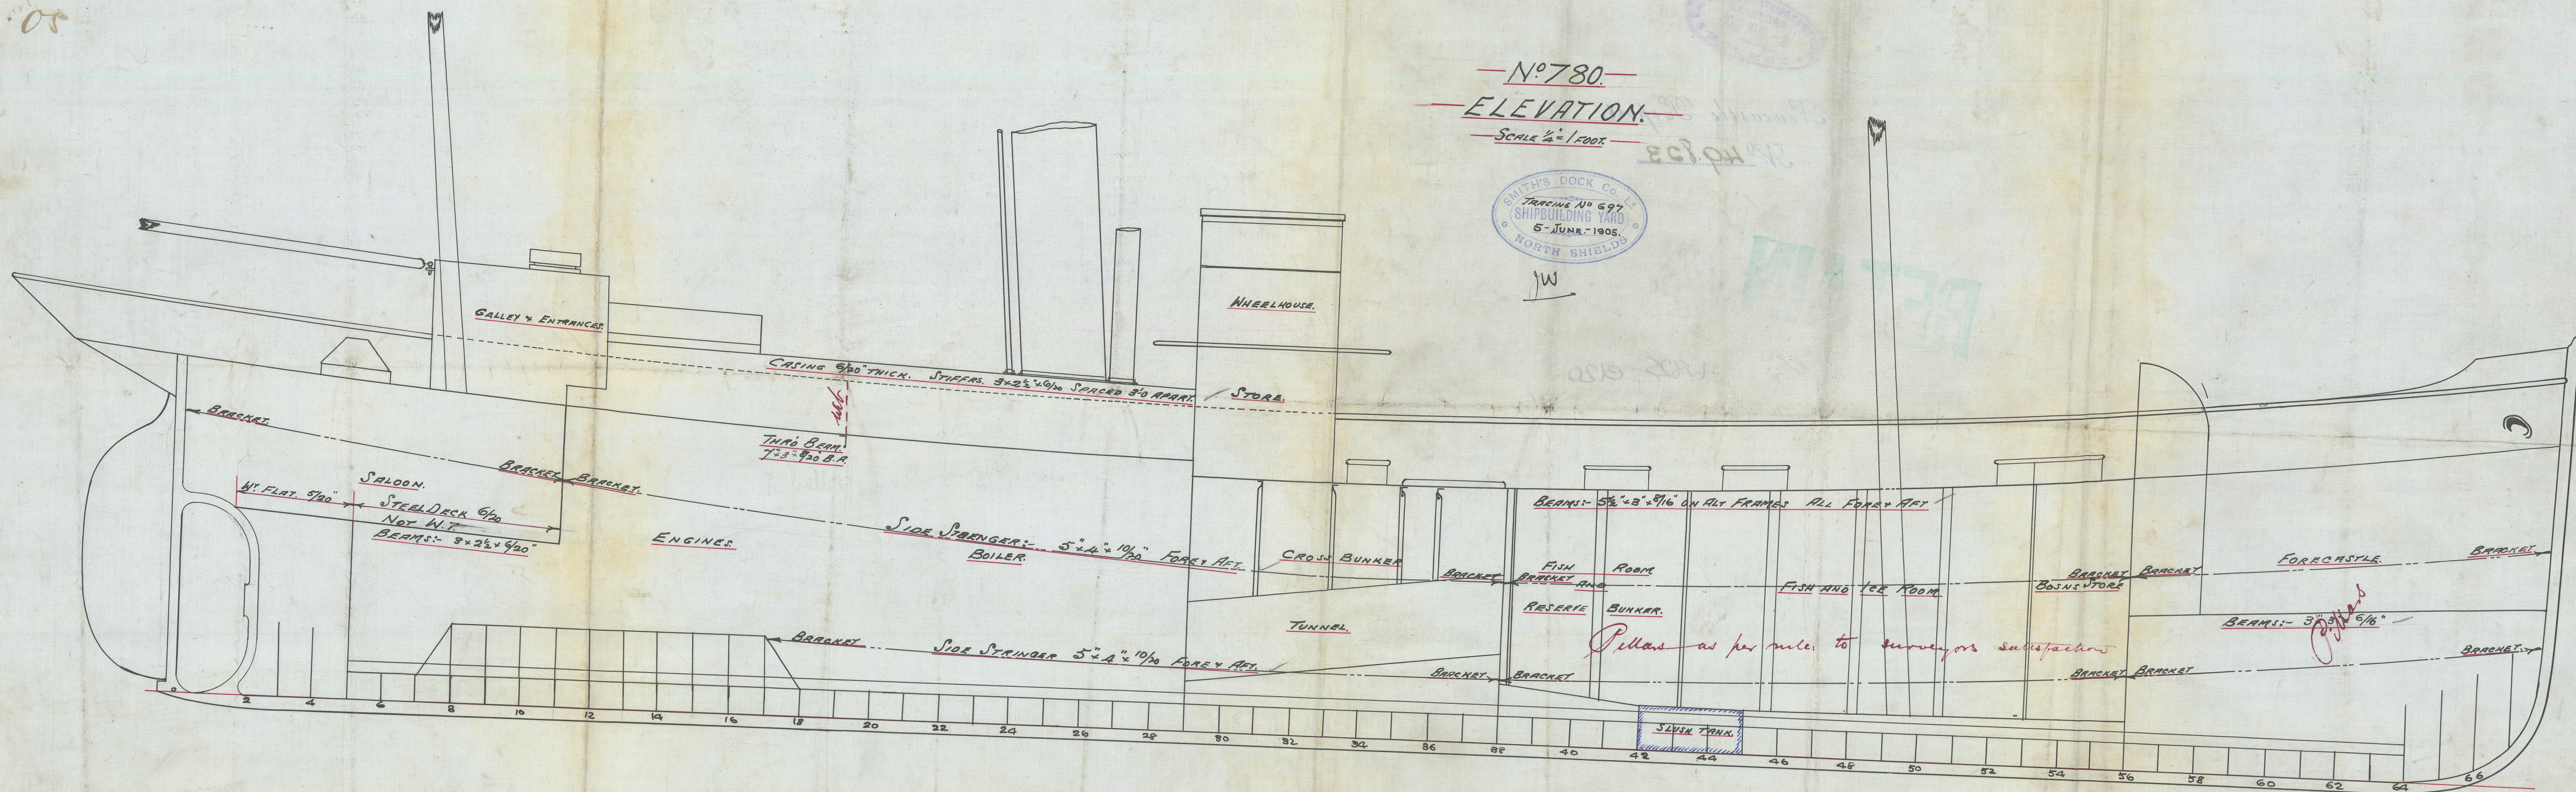


Q. 7.
8. 6. 05.

SMITHS DOCK CO^{LD}.

N^o 780

PROFILE,
"LANGLAND"

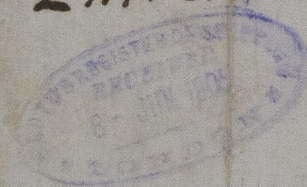


— 0850 V —
— N^o 780 —

Newcastle Paper

— ELEVATION —

N^o 49.823


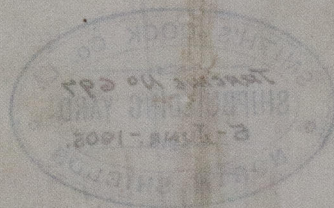

REF IN



© 2020

Lloyd's Register
Foundation

W825-0120