

N^o 780.

MIDSHIP SECTION.

OF A.



STEEL SCREW TRAWLER.

DIM^s 120'-0" x 22'-0" x 12'-10" M.L.O.

SCALE 1/4" = 1 FOOT.

NUMERALS
 1/2 BEAM-----10' 91.
 DEPTH-----13' 30.
 1/2 GIRTH-----19' 45.
 1ST NUMBER-----43' 66.
 LENGTH-----118' 87.
 2ND NUMBER 5189' 46.
 L/B = 5.4. L/D = 8.91.

EQUIPMENT
 1 ANCHOR-----5 1/2 CENTS EX STOCK
 1 "-----4 3/4 " " "
 1 "-----2 1/2 " " "
 90 FMS-----1" STUD. LINK CHAIN.
 60 "-----6" HANSER.
 60 "-----4 1/2" WARR.

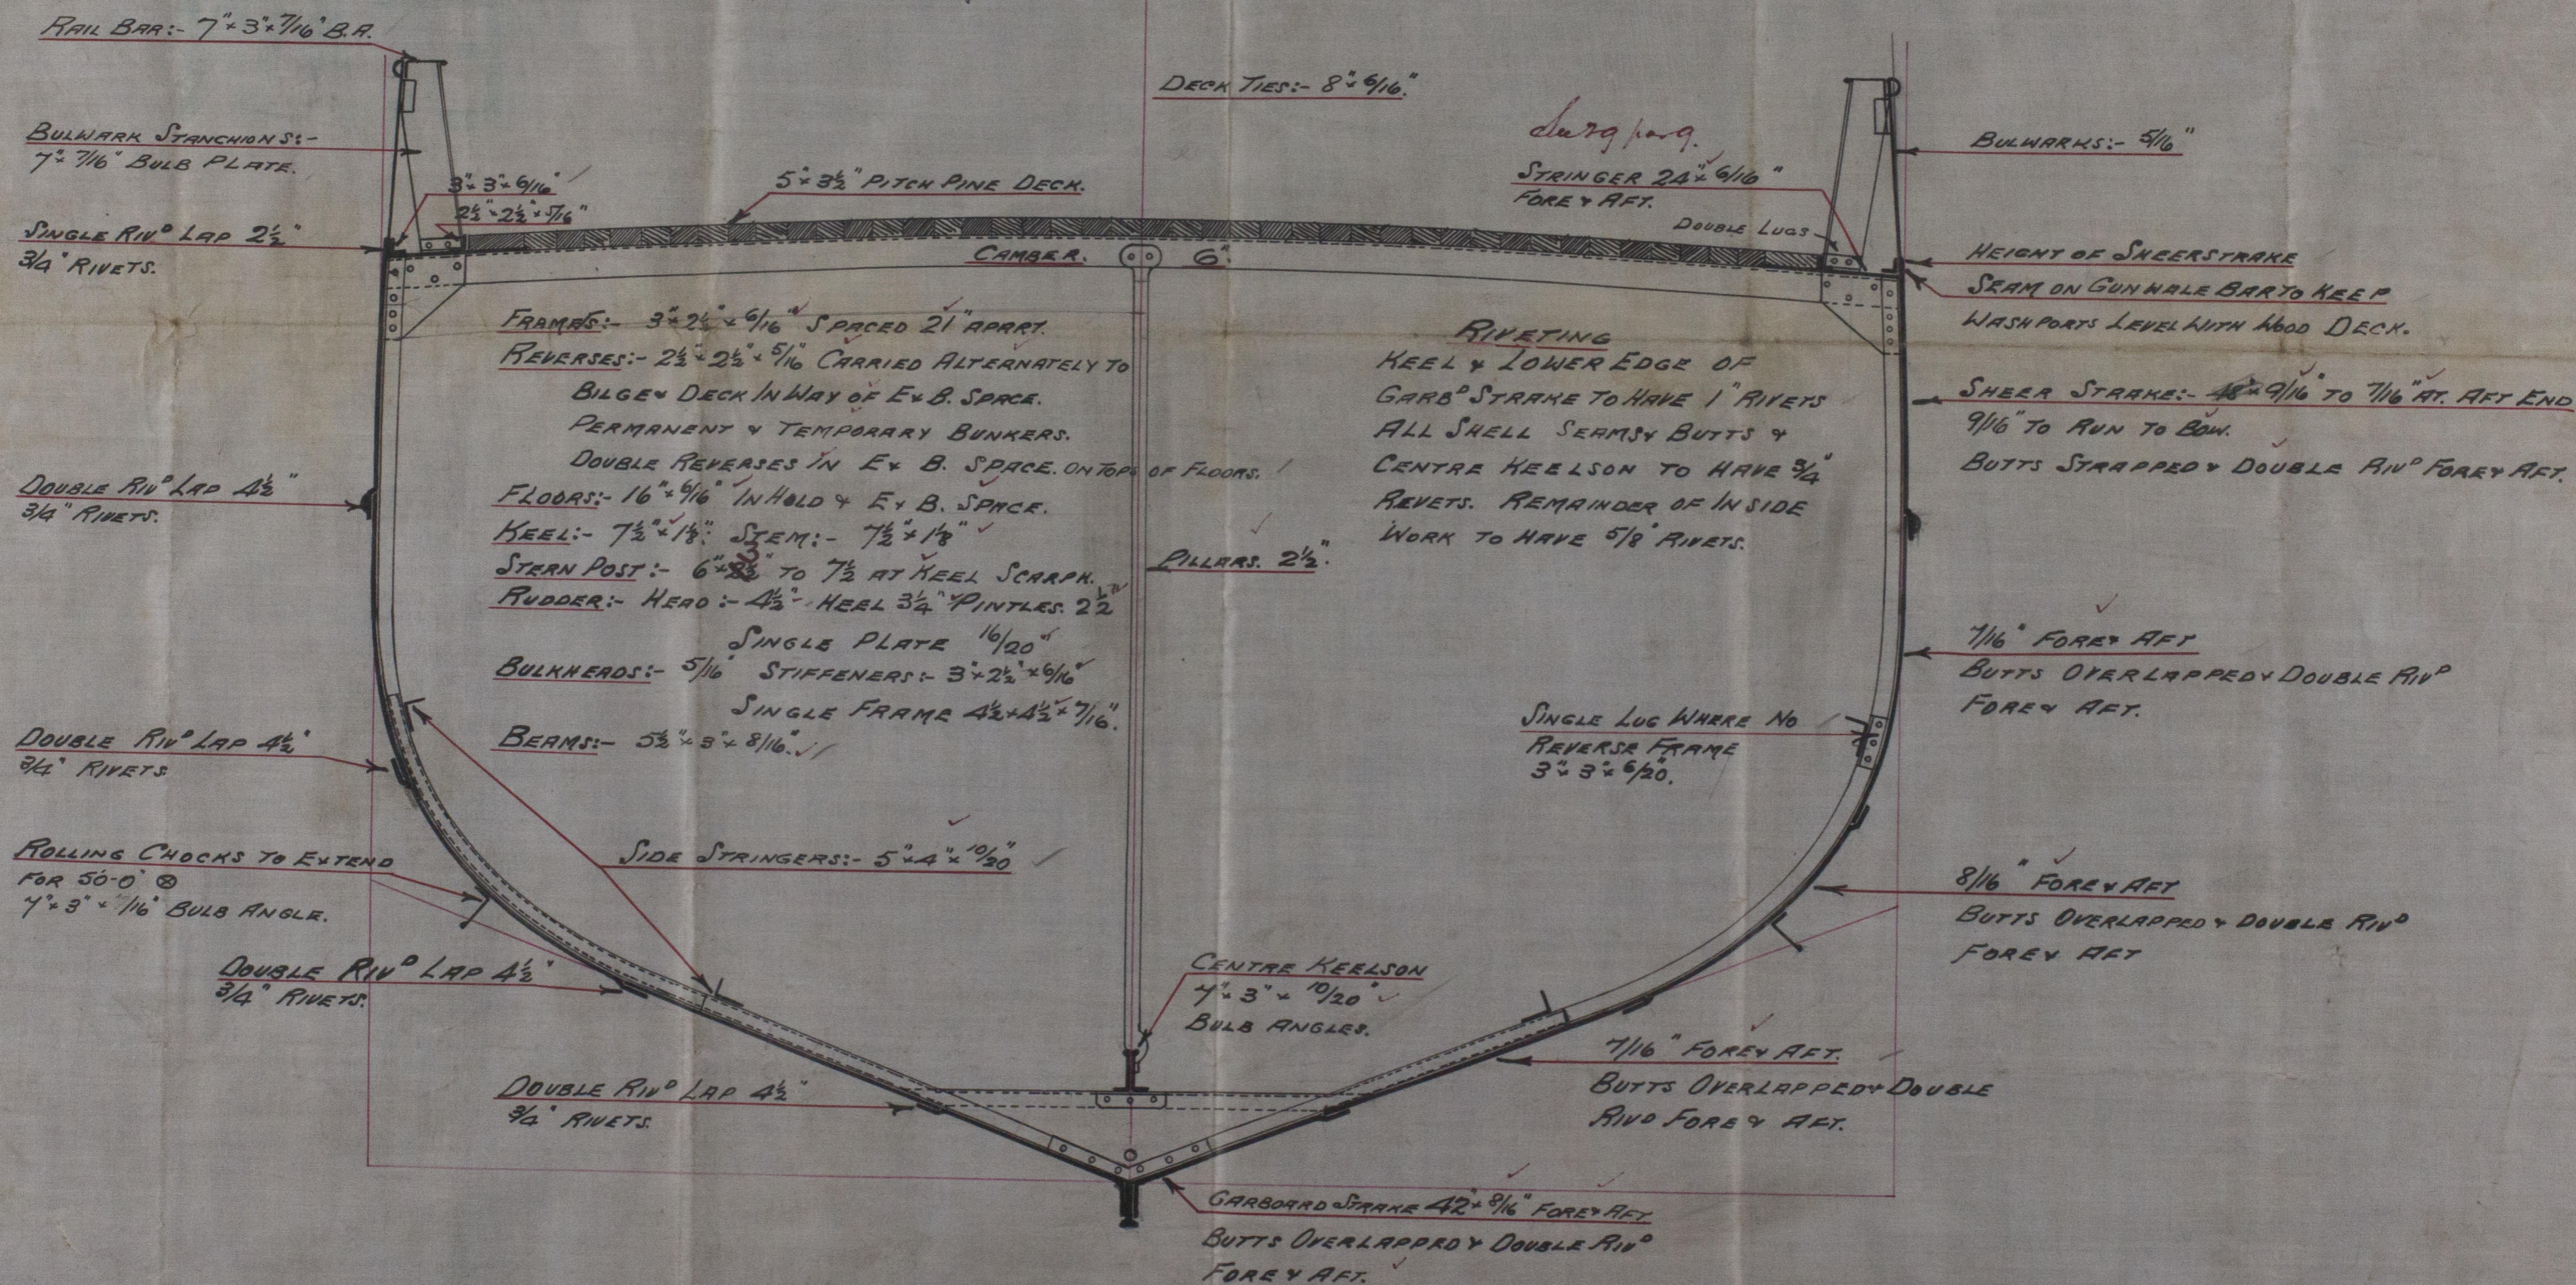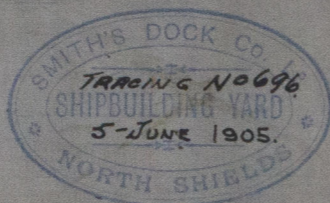

C.F.
 8.6.05

SMITHS DOCK CO L^d

N^o 780

MIDSHIP SECTION.

"LANGLAND"

Newcastle Report

N^o 49823

10.8 = 0. A. 2 - 1/2

© 2020

Lloyd's Register
Foundation