

MIDSHIP SECTION.

STEEL TO CLASS 100 A.I. FOR FISHING PURPOSES.

SCALE $\frac{1}{2} = 1$ FOOT.




- DEPTH = 13.5
 - $\frac{1}{2}$ BREADTH = 11.43
 - $\frac{1}{2}$ GIRTH = 21.25
 - $46.18' = 1^{ST} N^o$
 - $135.46 = \underline{\text{LENGTH}}$
 277 08
 18472
 23090
 13854
 4618 ✓
 - $6255.5428 = 2^{ND} N^o$

$$\frac{L}{B} = 5.92$$

$$\frac{1}{D} = 10.03$$

ONE ANCHOR	6 ¹ / ₄ CWT.	EX. STOCK.
"	5 ³ / ₄	"
"	3 ¹ / ₄	"
120 FATHOMS	1 ¹ / ₈ CABLE.	
60	6 HAWSER.	
60	5 WARP.	

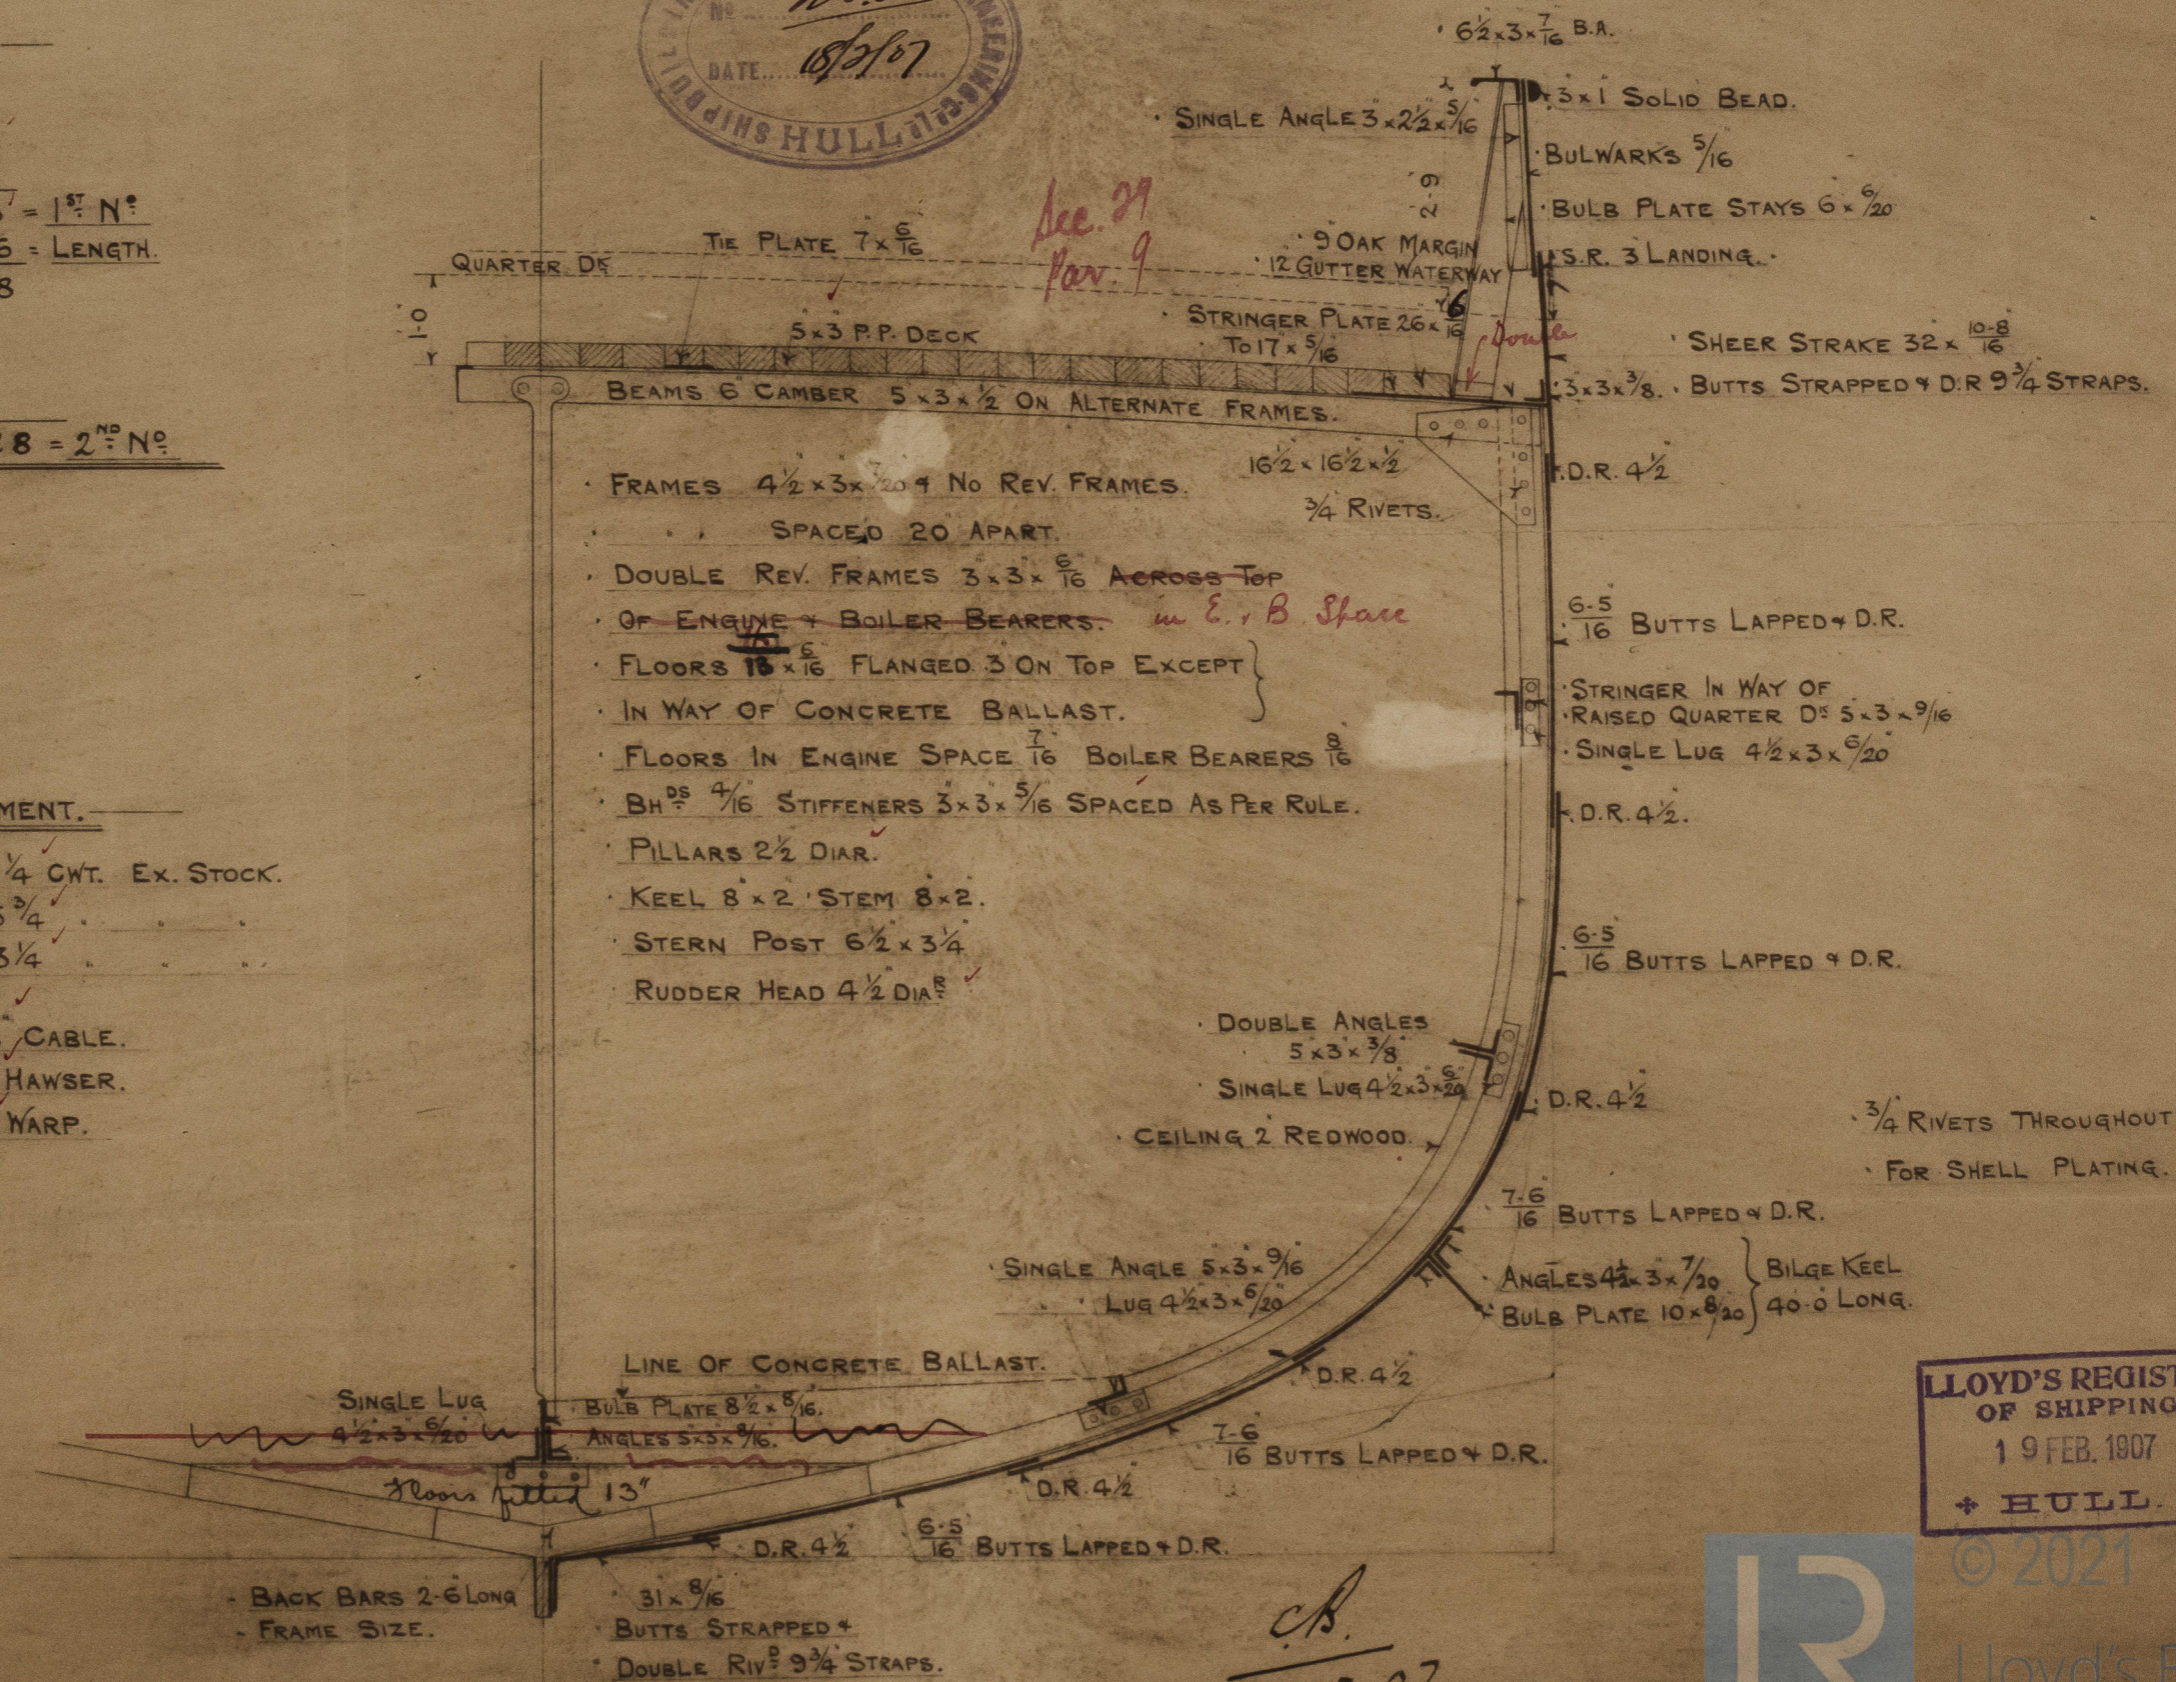

**LLOYD'S REGISTER
OF SHIPPING
19 FEB. 1907
HULL**

© 2021

W826-0029




Earle's Co.

Nº 535

Midships Section

"Lord Roberts"

Full 19398

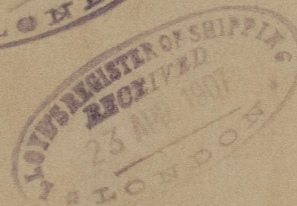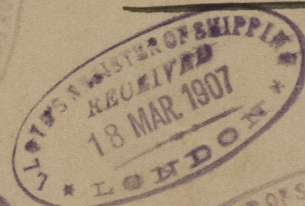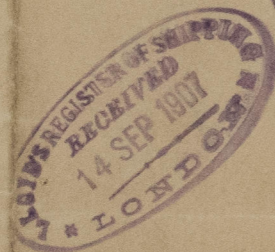

RETAIN

W826-0029



© 2021

Lloyd's Register
Foundation