

20.2.07
5.3.07
12.3.07
18.3.07



N°535 PROFILE & DECK PLAN

DIMENSIONS 136'8" B.P. x 23'0" O.E.N. x 13'0" M.L.

SCALE 1/4" = 1'



*Pillaring to Surveyors
satisfaction throughout*

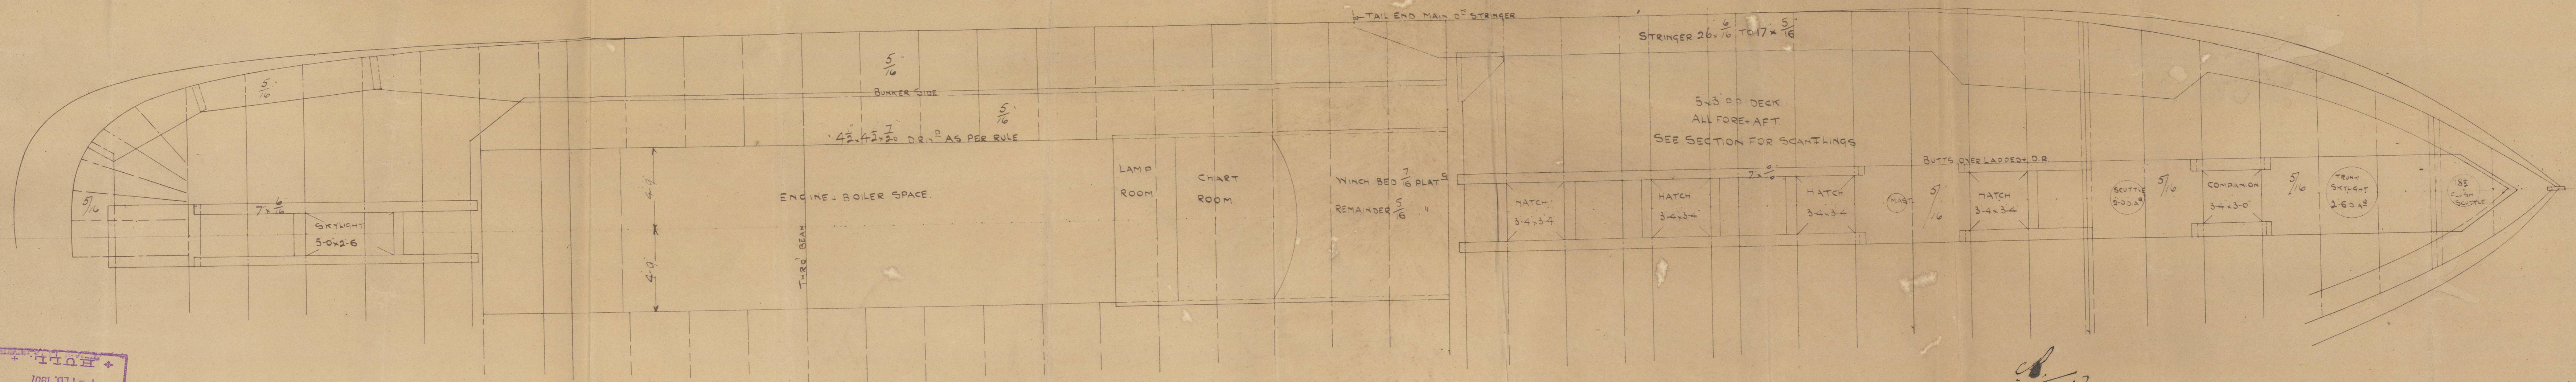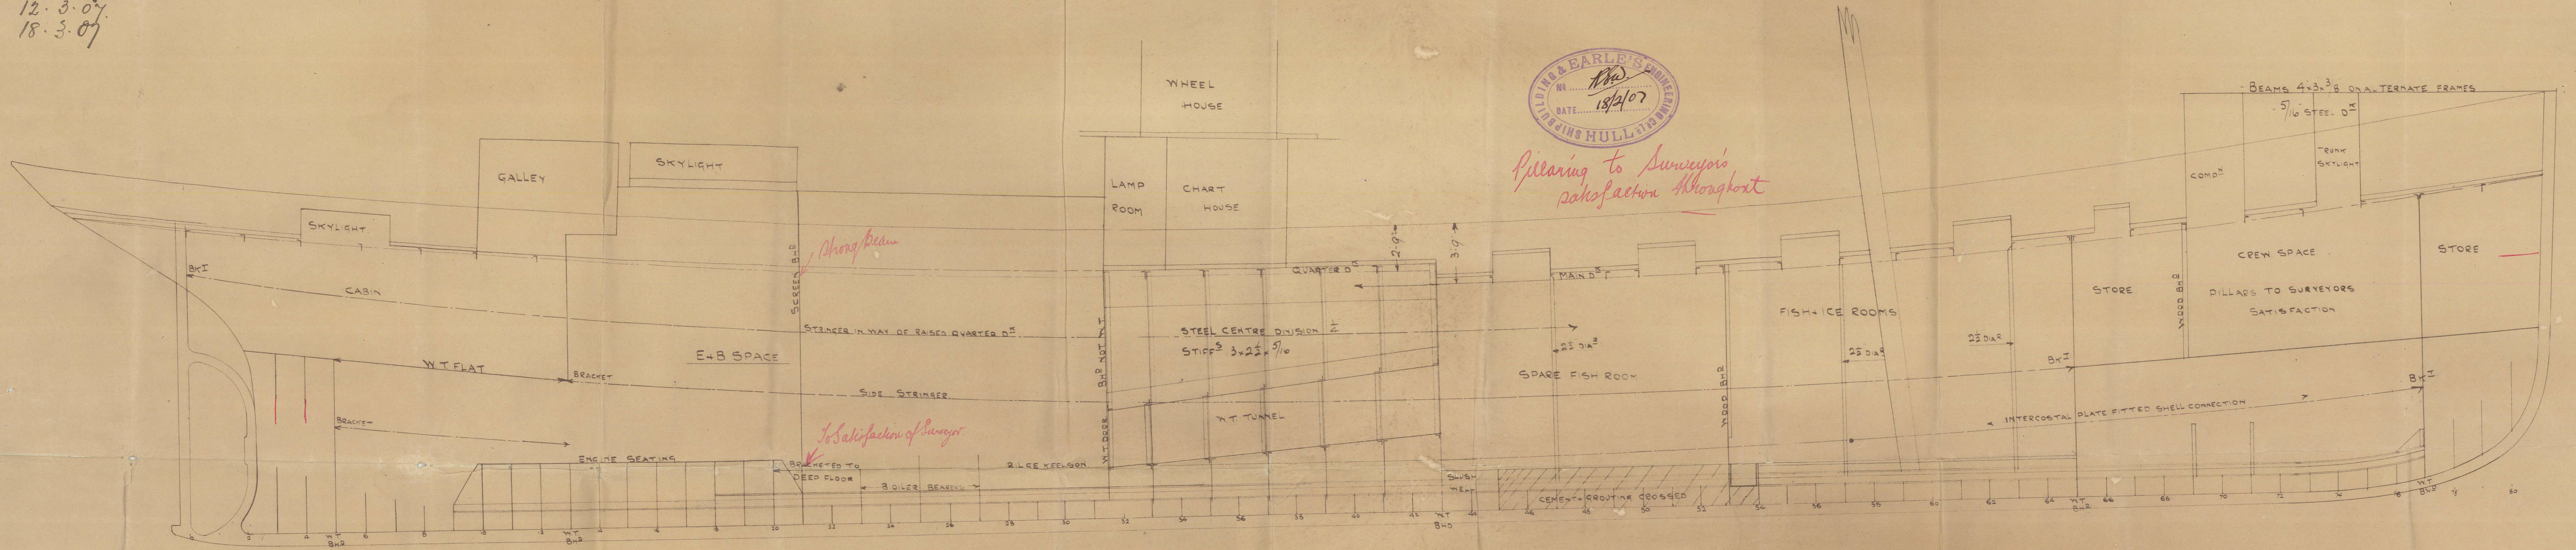

LLOYD'S REGISTER
OF SHIPPING
19 FEB. 1907

20.2.07

LLOYD'S REGISTER
OF SHIPPING
19 FEB. 1907
+ HULL. +

W826-0031

Lloyds No 535



Earle's Co.

No 535.

Profile & Deck Plan.

Lord Roberts

19th MAR 1907

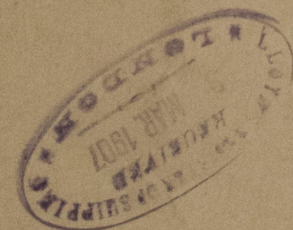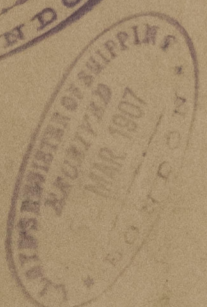

RETAIN

W826-0031



© 2021

Lloyd's Register
Foundation