

11.7.13

# PROFIL & DECK PLAN



N<sup>o</sup>. 576-80-85-6

SCALE 1/4 INCH

DIMS. 136'-8" x 23'-3 EXT. x 13'-0" MLD.

PLAN NO. 3063  
FOR ENCLOSURE TO  
Messrs Lloyd's Surveyors  
Hull  
FROM  
DATE 2/7/13

all work & material  
188,282.000, 172.970  
also to be added  
0-81 x 51-50 x 22.281

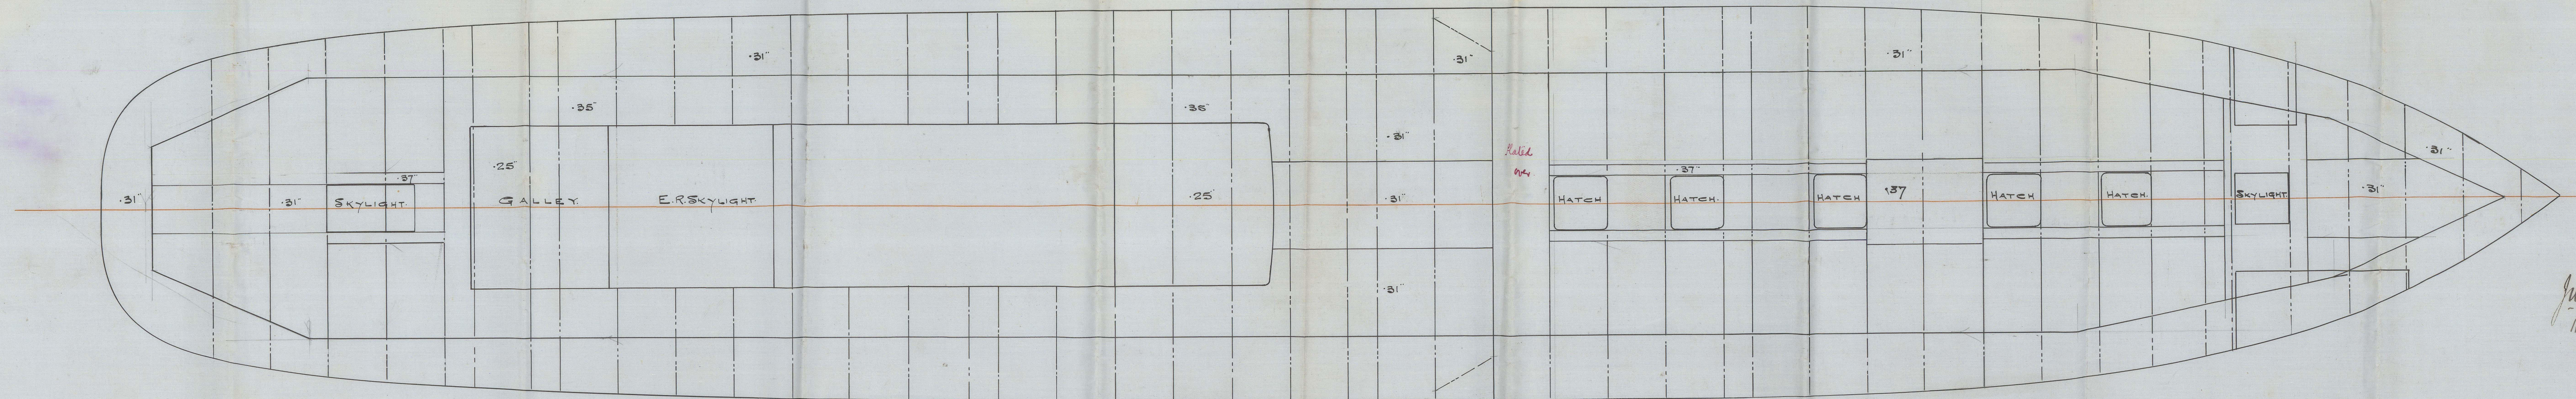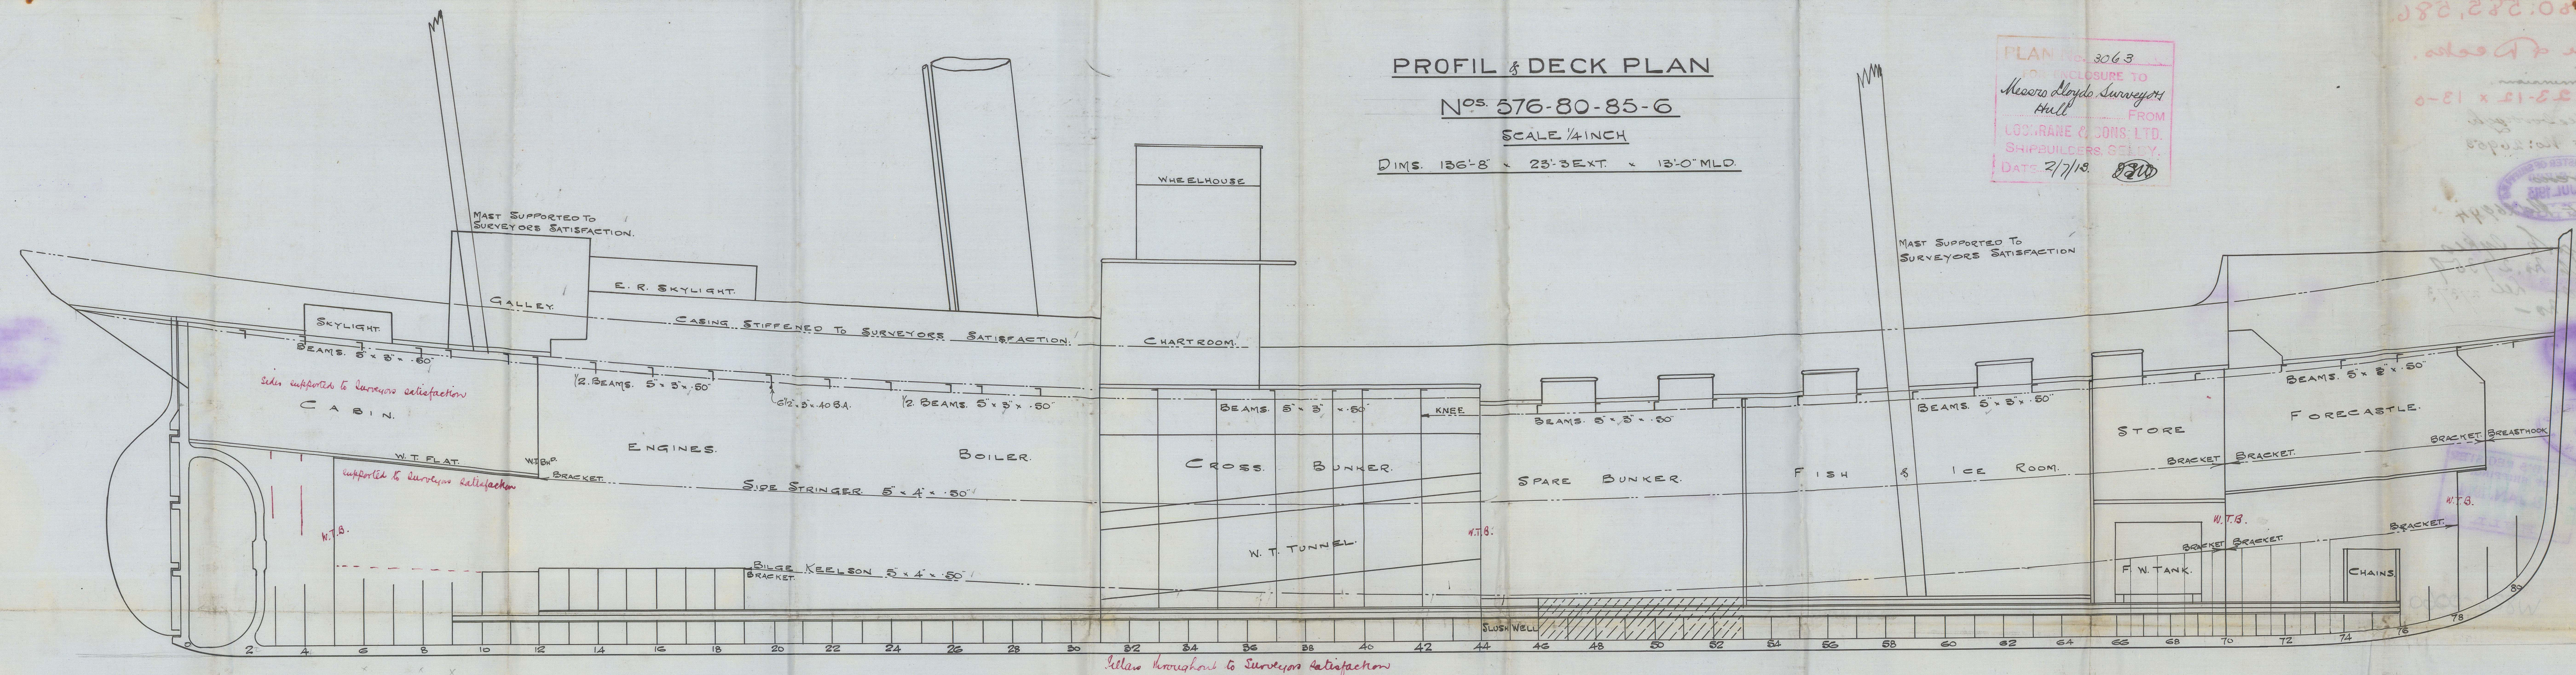

W826-0060



Cochrane & Sons. Ltd.  
Nos 576, 580, 585, 586.


Profile & Decks.

<sup>Dimensions.</sup>  
136.66 x 23.12 x 13-0

Lord Londesborough

Hull Rpt No: 26953

J. L. R. *Levens*

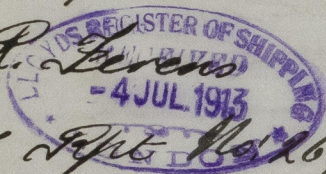




Hull Rpt No 26944

of Sir Mark Sykes

Hull Rpt No. 27359

of Doctor Lee 27373

Hull Rpt No -

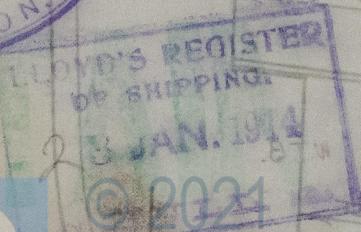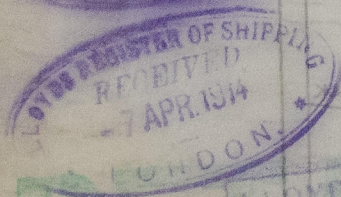 

Lloyd's Register  
Foundation

W826-0060