

11.7.13
 10-51 x 51-25 x 51-25
 10-51 x 51-25 x 51-25
 10-51 x 51-25 x 51-25

MIDSHIP SECTION STEEL SCREW TRAWLERS


Nos 576-80-5-6

DIMENSIONS: 136'-8" B.P. x 23'-3" EXT x 13'-0" MLD

SCALE 1/2" INCH.

TO CLASS 100 A.I. STEAM TRAWLER
 DECK PLATED OVER IN WAY OF MACHINERY
 CASING AS PREVIOUSLY APPROVED

PLAN No. 3064
 FOR ENCLOSURE TO
 Messrs Lloyd's Surveyors,
 Hull FROM
 COCHRANE & SONS, LTD.
 SHIPBUILDERS, SELBY.
 DATE 2/7/13.

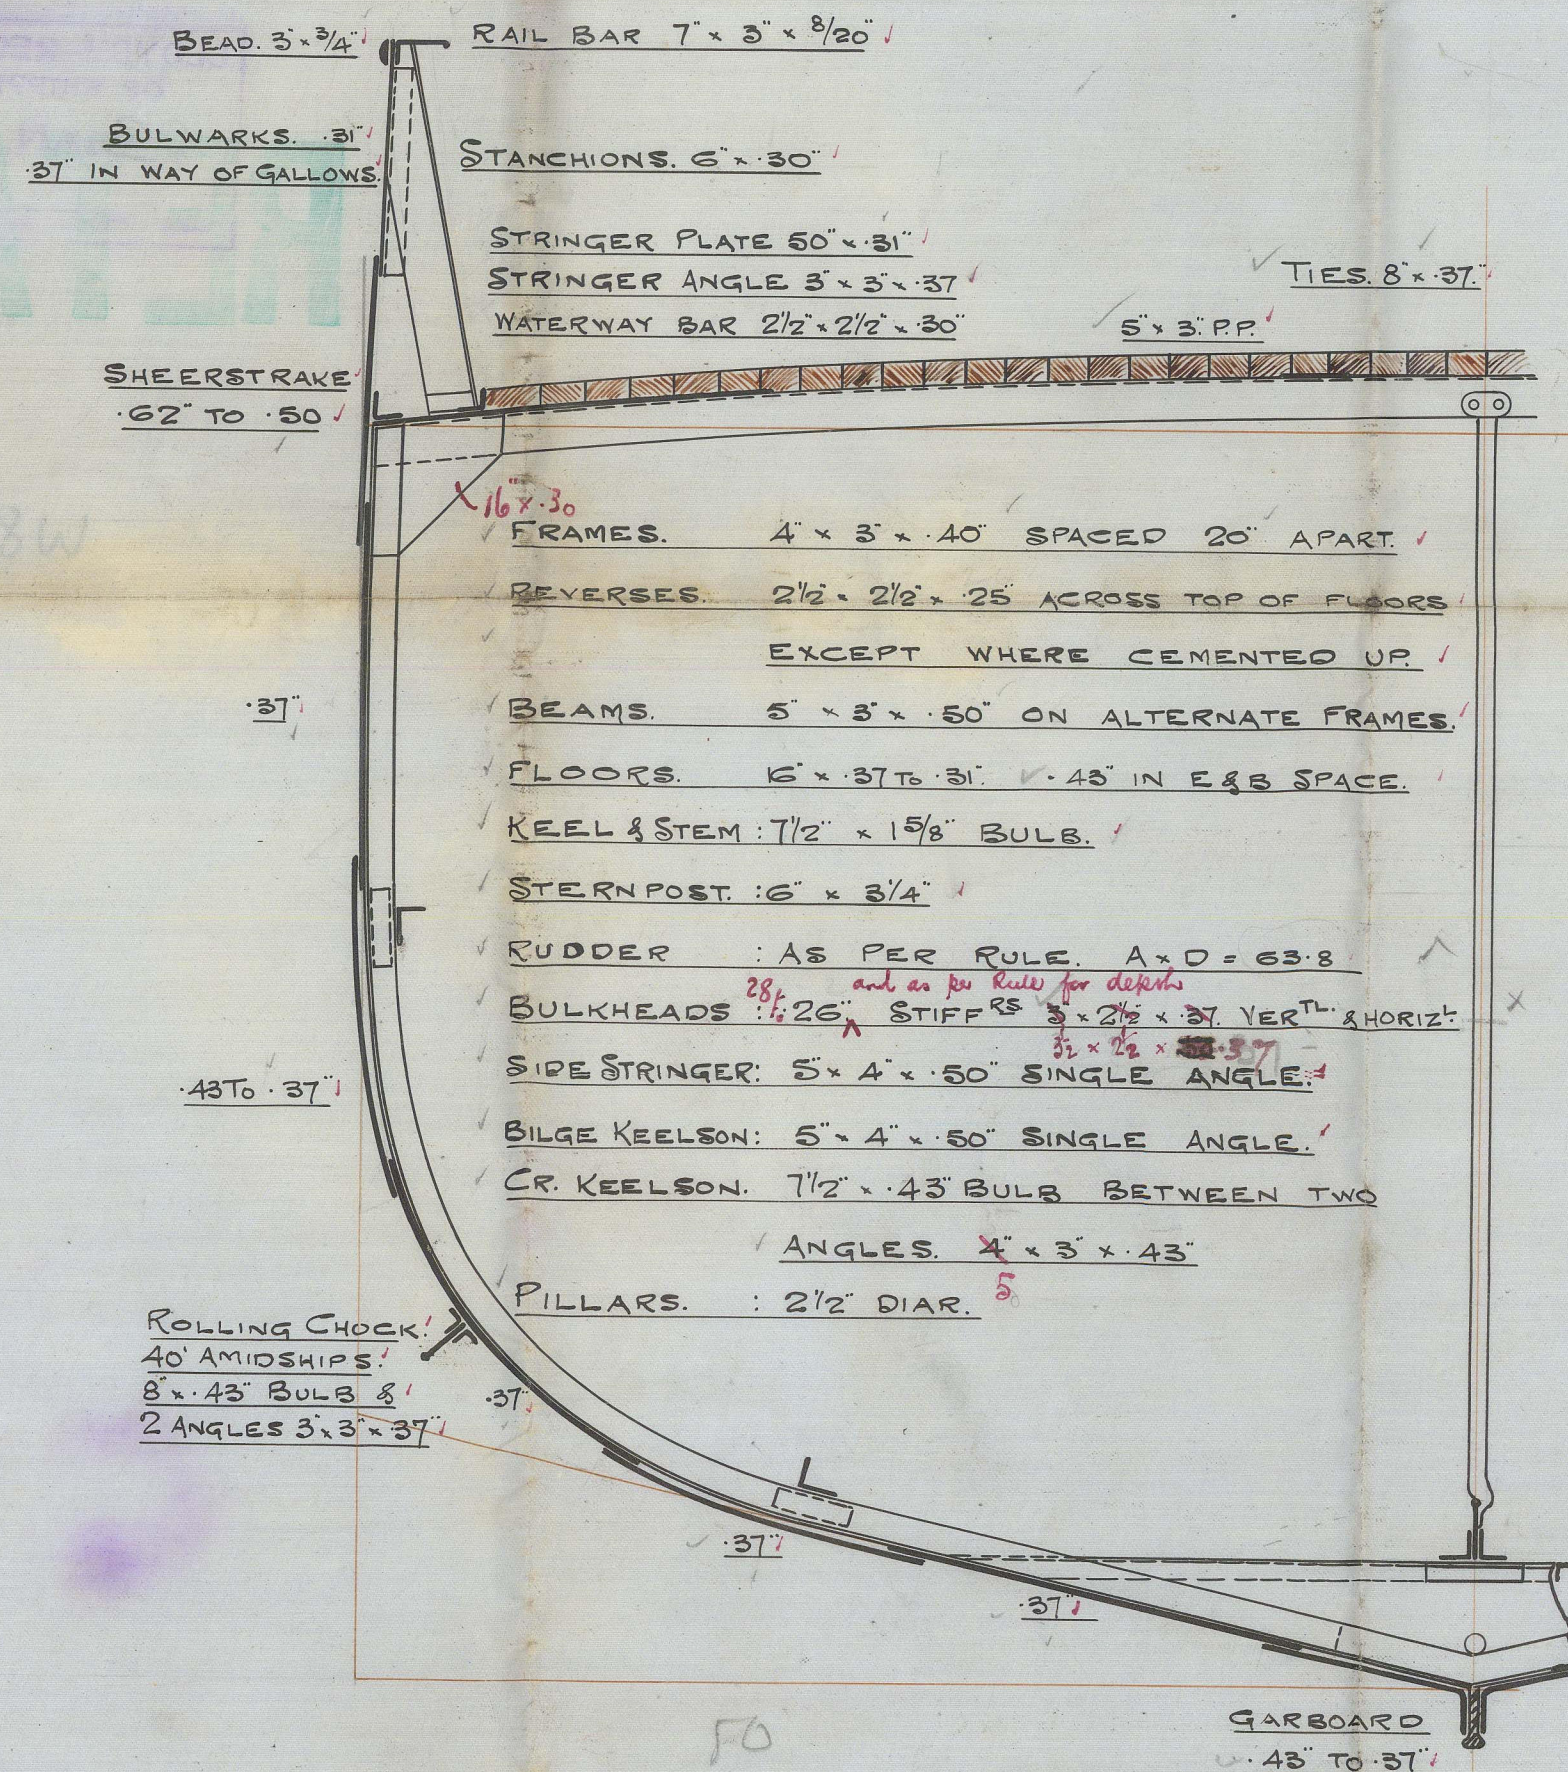

NUMERALS

B + D = 36.12
 L (B + D) = 4936.15

PROPORTIONS

L/D = 10.51
 L/B = 5.91

EQUIPMENT

1 ANCHOR 6 CWTs EX STOCK
 1 5/2
 1 3
 120 FATHOMS 1/8" STUDLINK CABLE
 60 6" HAWSER
 60 5" WARP

RIVETING

BUTTS OF SHELL PLATING OVERLAPPED AND
 DOUBLE RIVETED, EXCEPT GARBOARD & SHEERSTRAKE
 WHICH ARE TO BE STRAPPED & DOUBLE RIVETED
 LANDINGS DOUBLE RIVETED
 BULWARKS STRAPPED & SINGLE RIVETED

50
 36
 14

11.7.13

W826-0061

Cochrane & Sons.
Nos 576, 580, 585, 586.
Midship Section.

^{Diminution}
136.66 x 23-12 x 13-0.

to Lord Londesborough

Hull Rpt No. 26953.

J. T. R. Ferens






Hull Report No. 26994

Sir Mark Sykes

Hull Rpt No. 27359

Doctor Lee

Hull Rpt No. 27373.

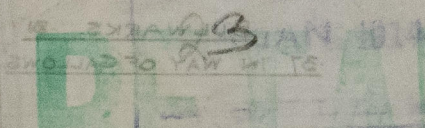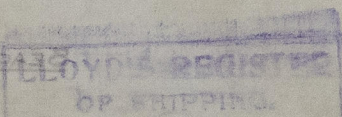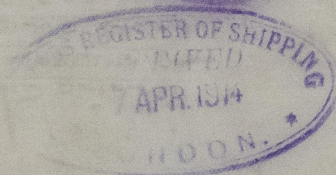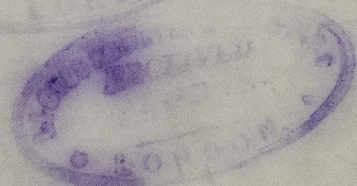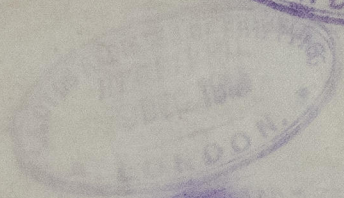

© 2021

Lloyd's Register
Foundation
W826-0061