


SCALE $\frac{1}{8}$ INCH = ONE FOOT.

THE DUBLIN DOCKYARD CO.
Drawing Office
Reg No. 917.....
25. 3. 04
NORTH WALL, DUBLIN

29.3.04
2.5.04

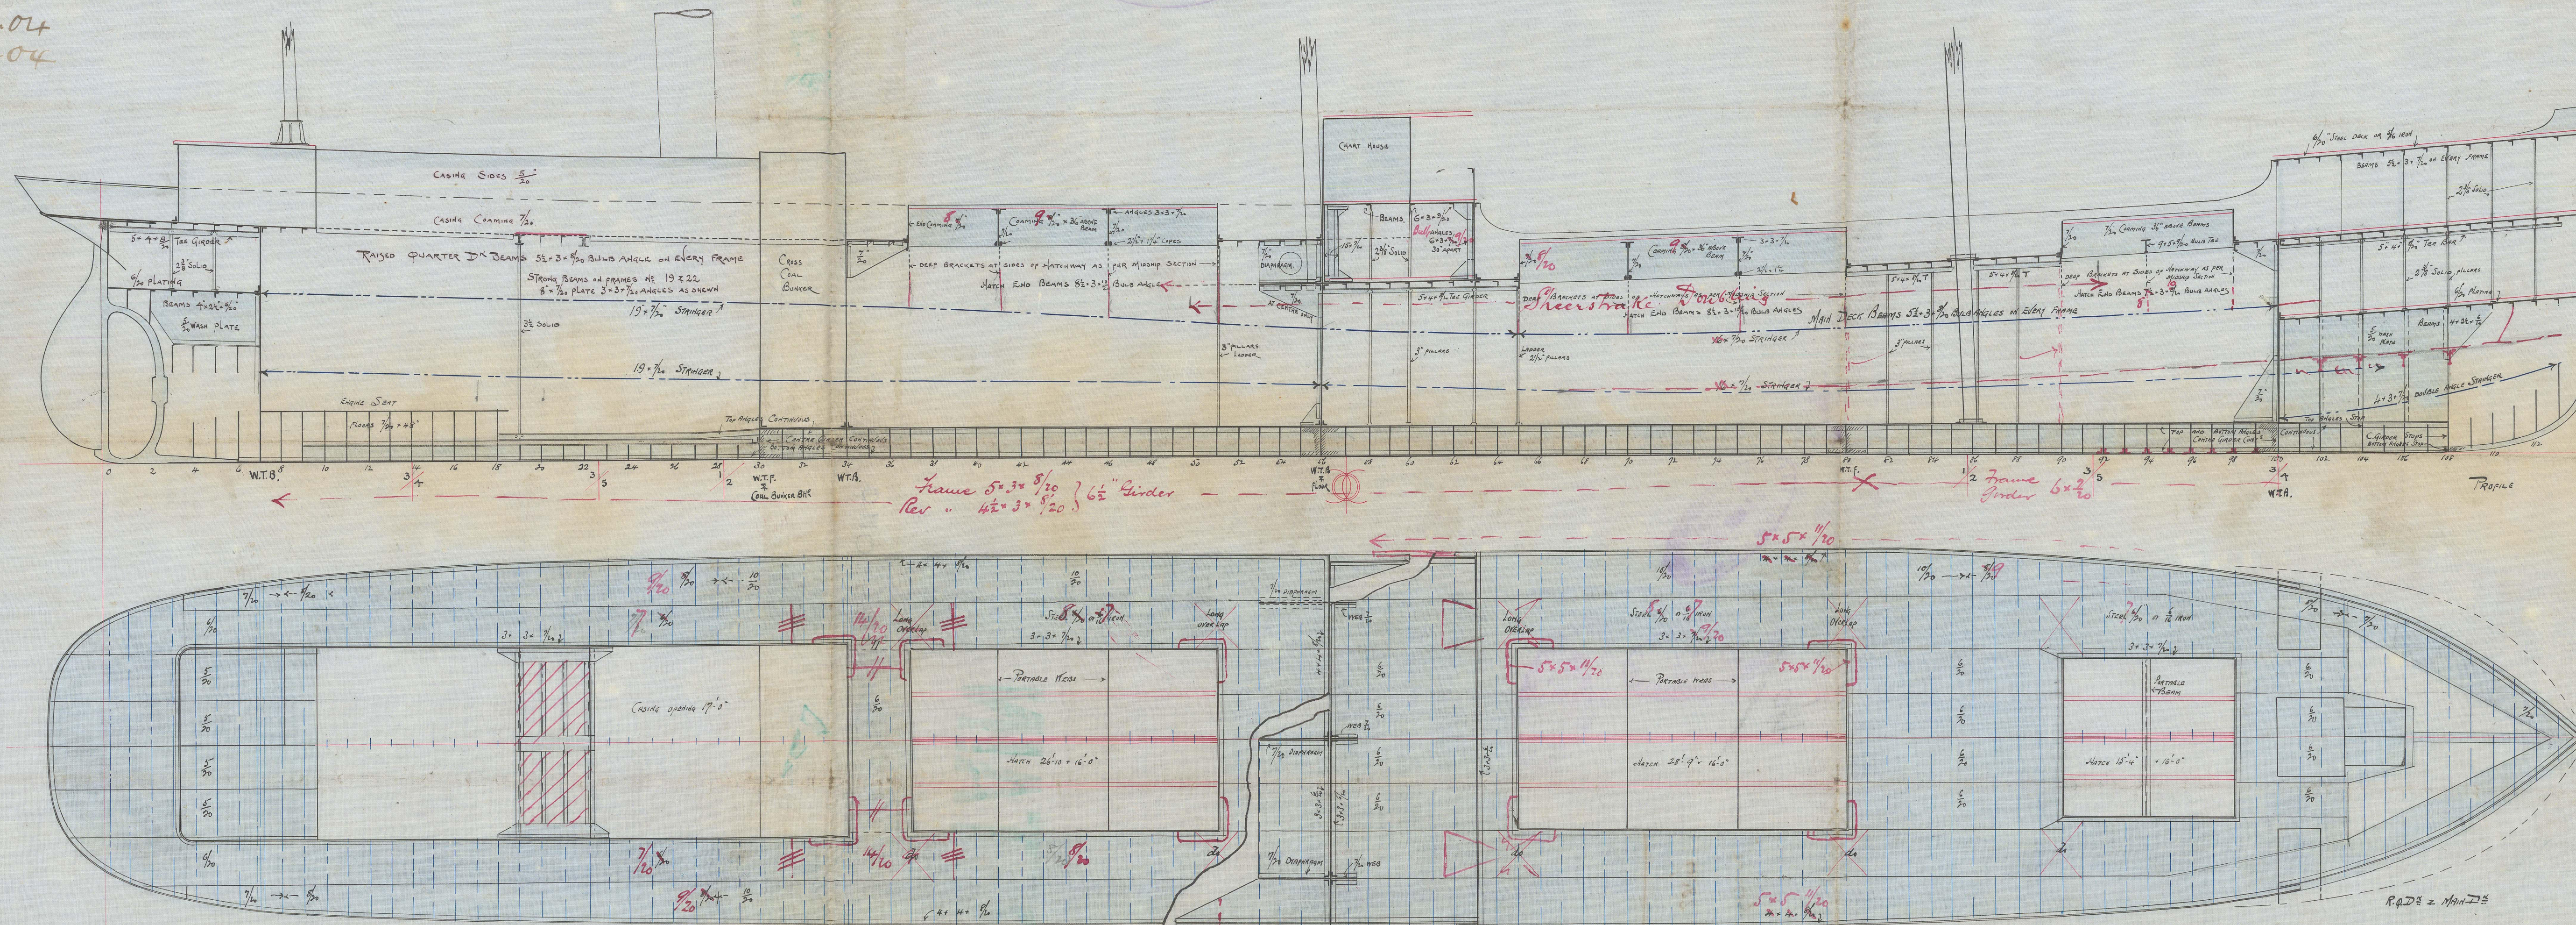

J. P. K.
29/3/04

Dublin Dk
ss. Lillebonne
No 46 sub. 2337

46



© 2021

Lloyd's Register

W826-0110