


2.8.04

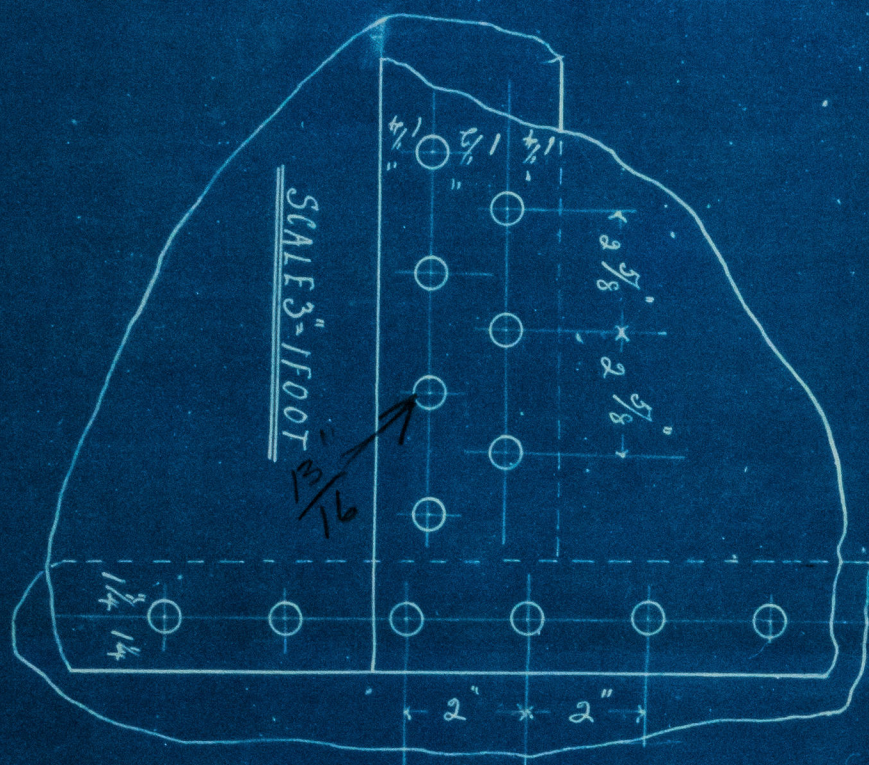

Shell 27 tons.

**STEEL VERTICAL BOILER**

10'-6" HIGH 6'-0" DIA



W. P. 75 LBS

SCALE 1"=1'00"

For Ross & Duncan's No. 992

Specification

Shell	3/8" Thick
Inner Shell	5/16"
Uptake	1/2"
Firebox	1 1/2"
Crown	5/8"
Cross Guts	3/8"

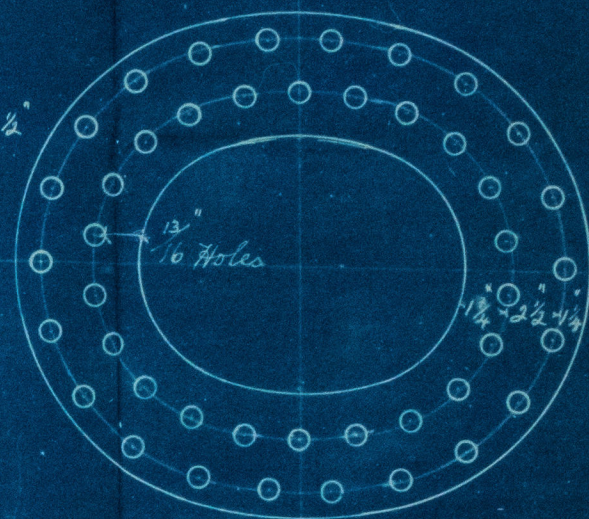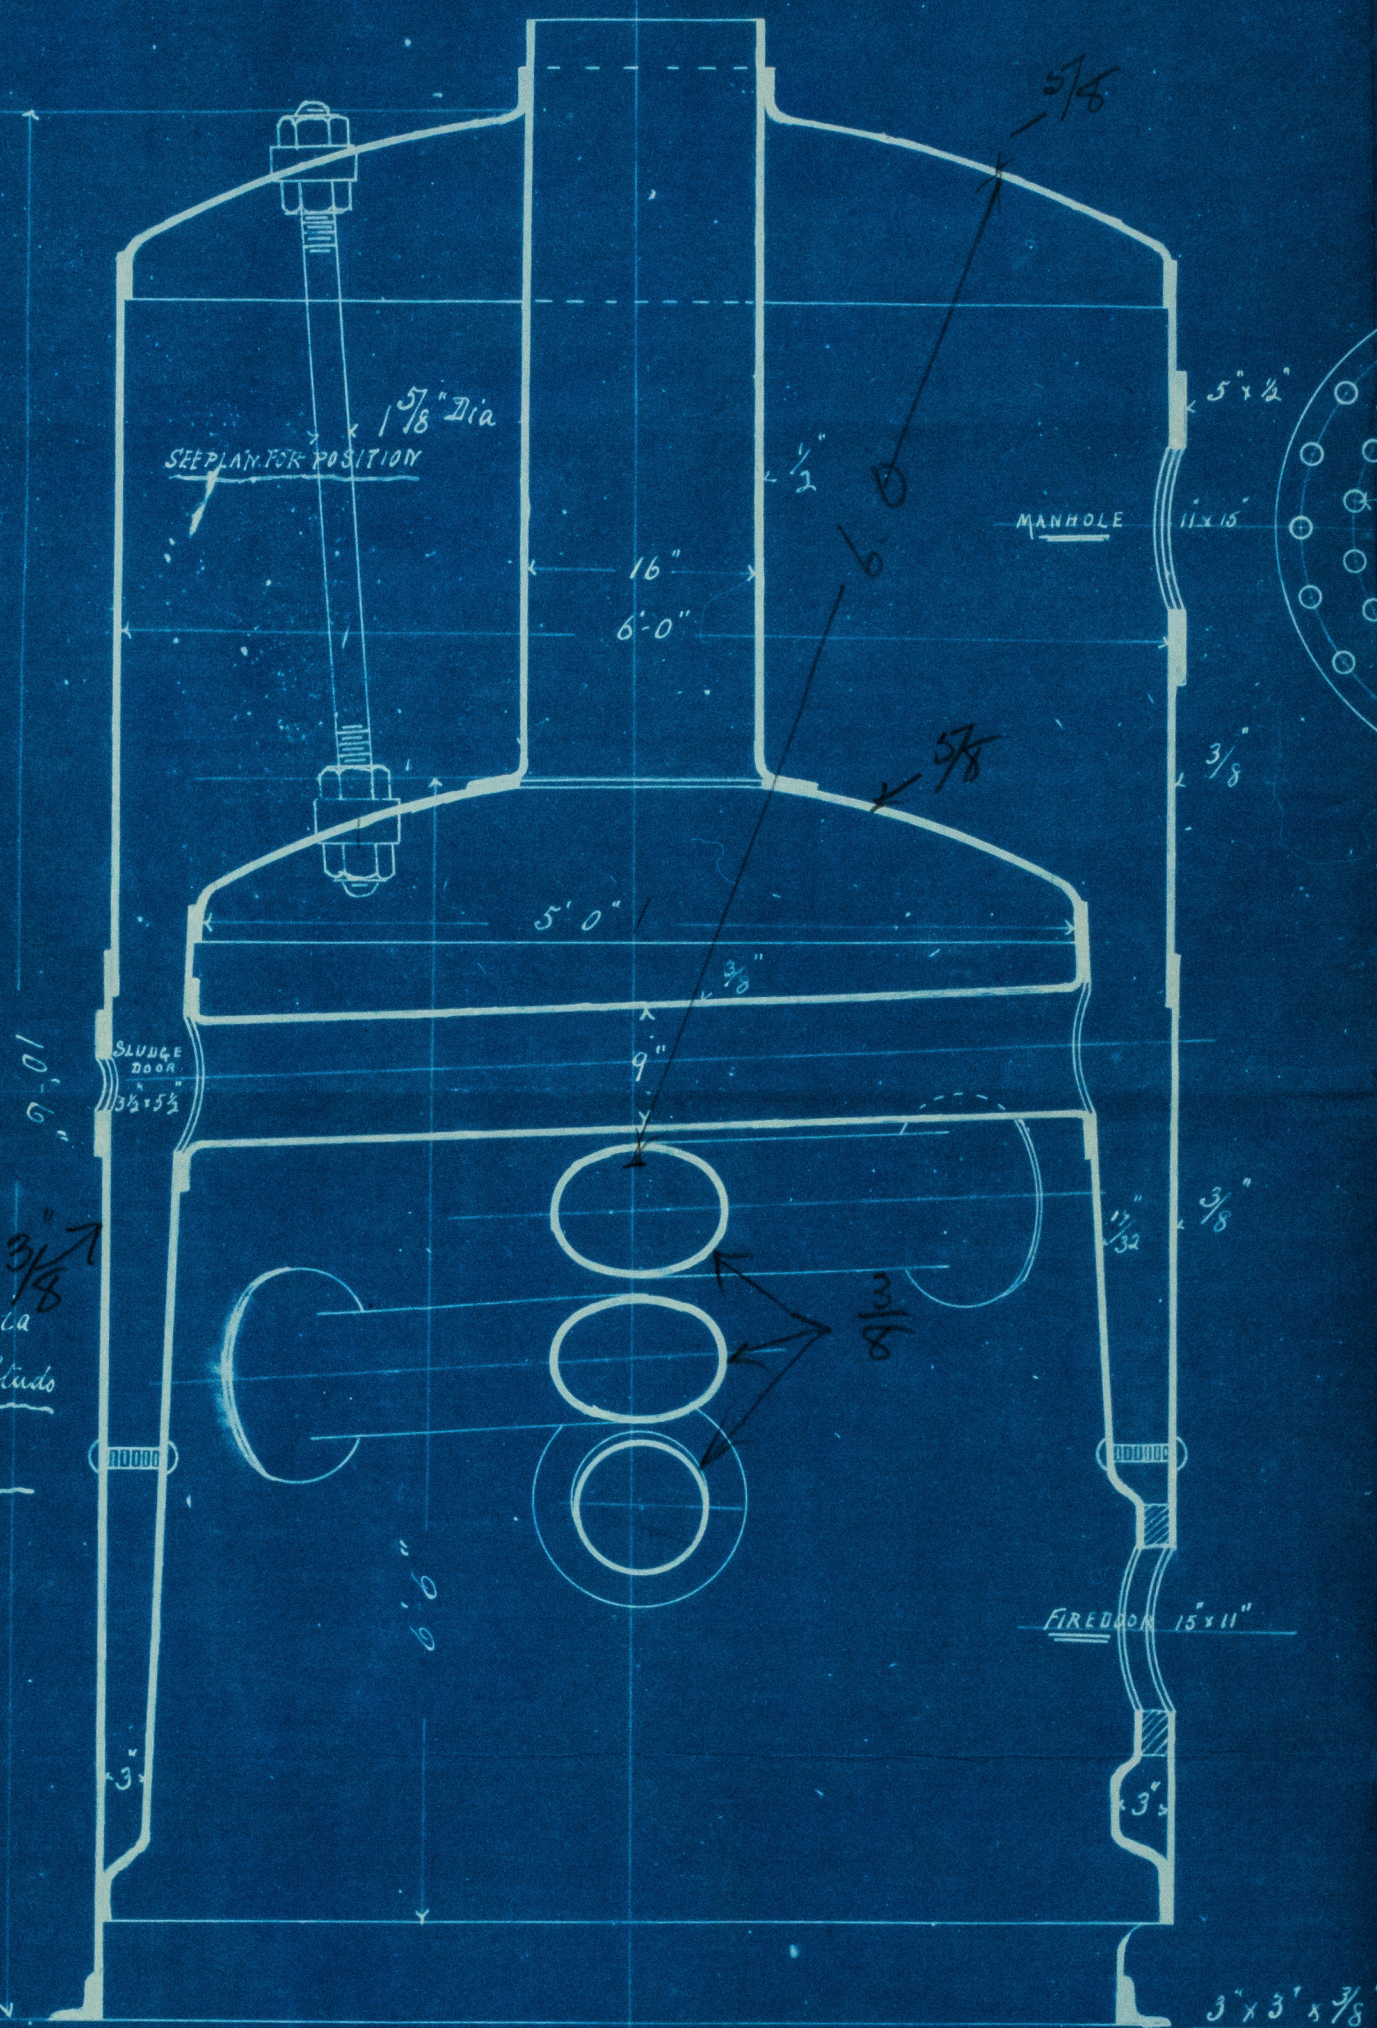

BOTTOM SEAM  
MUD HOLE

MUD HOLE  
TUBE HOLE

MANHOLE  
TUBE HOLE  
FIRE DOOR

TOP SEAM  
MUD HOLE

TUBE HOLE


TUBE HOLE  
MUD HOLE



W826-0111



Plan boiler by  
J. Marshall & Co  
for Ross & Parsons 992

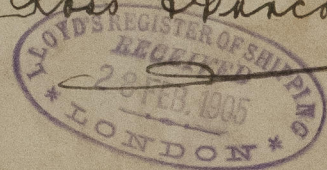

"S/S Tille boune"  
Glasgow n<sup>o</sup> 22552  
Dec. 2337.



© 2021

Lloyd's Register  
Foundation

W826-0111