



18.4.10.  
22.4.10.  
22.10.10

— PROFILE & DECK PLAN S.S. N°213 —

— SCALE 1/8" = 1 FOOT. —

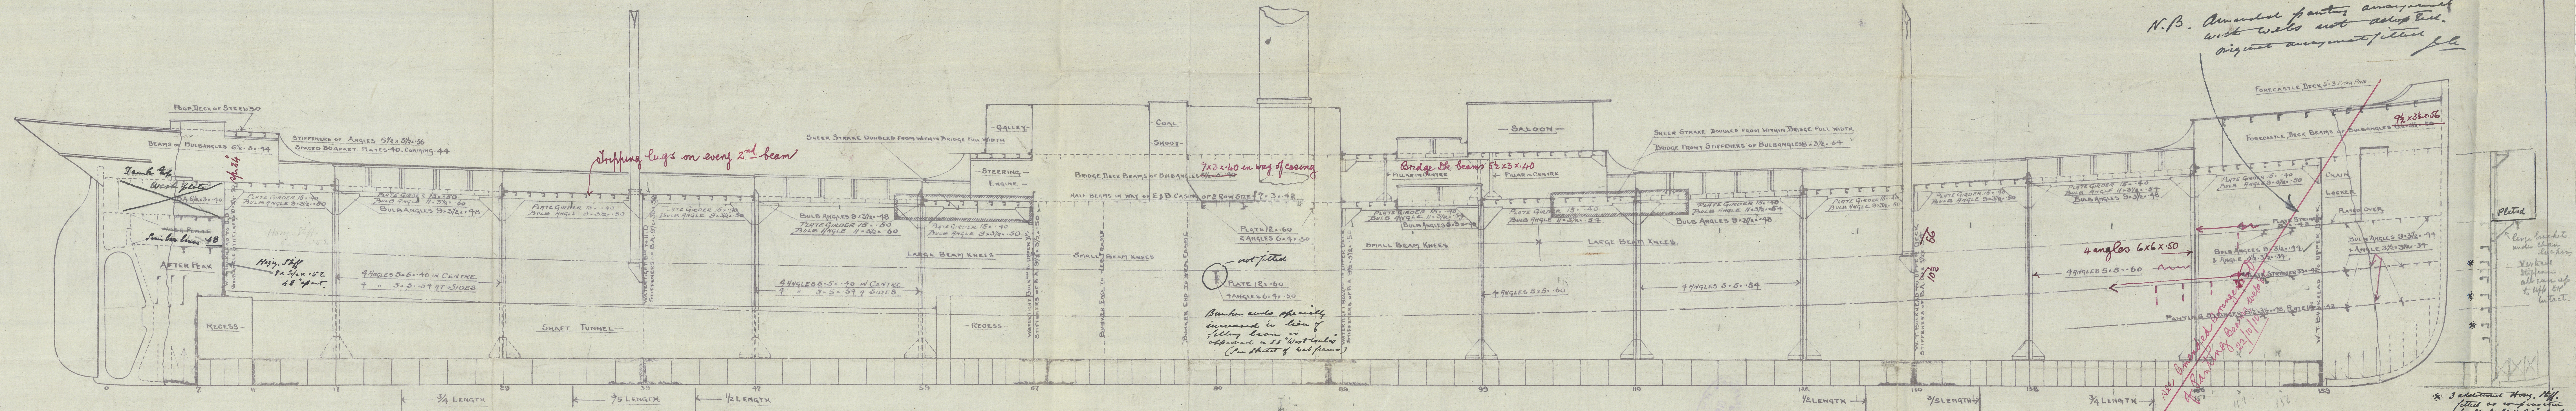

— PLAN OF BRIDGE DECK. —

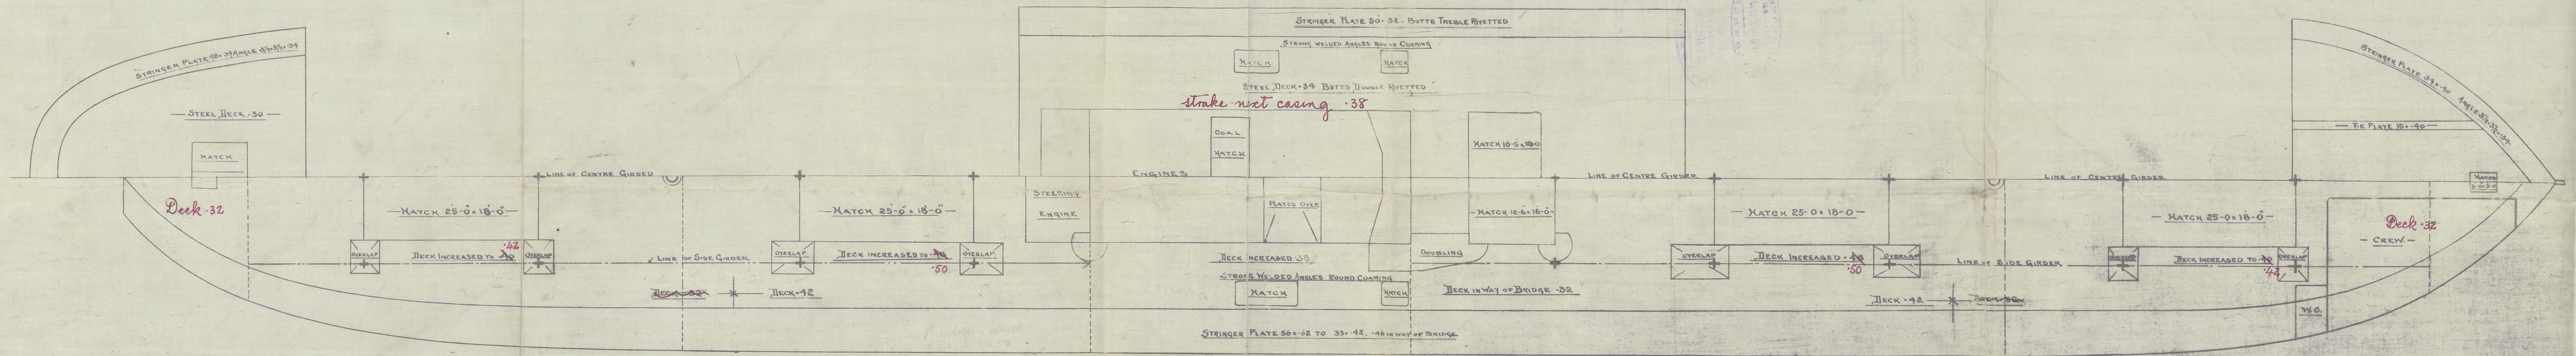

— PLAN OF UPPER DECK. —

C.F.  
18/4/10

BATRAM & SONS  
SHIPBUILDERS

UNDERLAND 2020





Lloyd's Register  
Foundation



PROFILE

Bartram & Sons

No 213

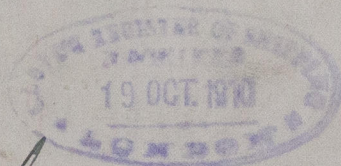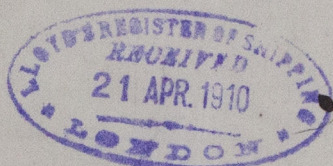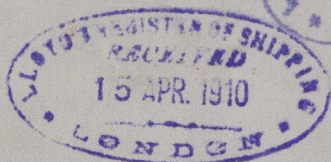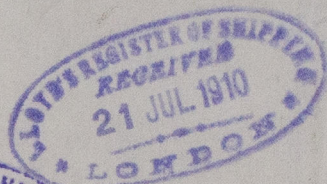

<sup>4</sup>  
Lexie


<sup>9</sup>  
Slack Rpt. 24754



© 2020

Lloyd's Register  
Foundation



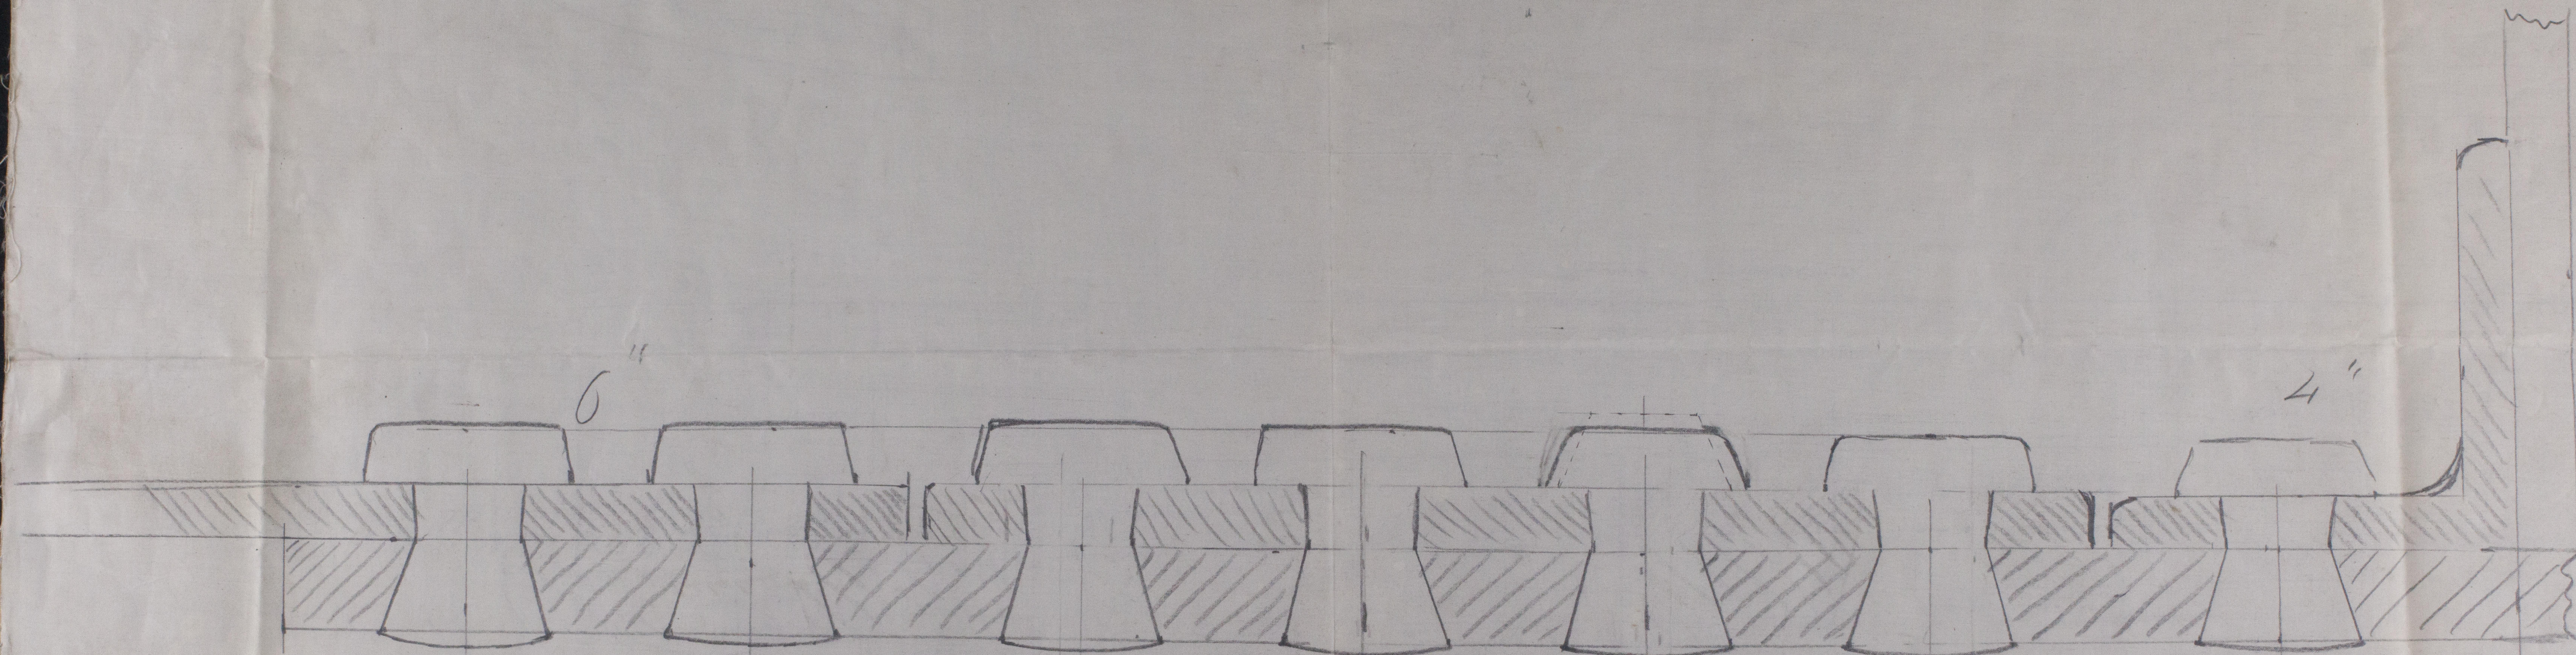

$$\begin{array}{r} 3) 8 \text{ (2.6)} \\ \underline{6} \\ 2 \\ 12 \end{array}$$

