


FOR MESS^{RS} BARTRAM & SONS SHIP N^o 213

TUBE PLATES 28

TOTAL	650
-------	-----

1 OFF THIS SCALE 1 = 1 F.T 15:4:10

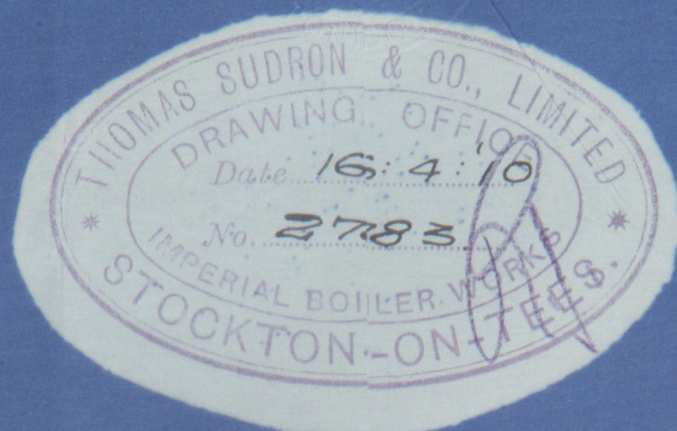

RIVET - 76.79

TENSILE STRENGTH OF SHELL PLATE 29 TO 33 TONS

SHELL PLATE $\frac{1}{2}$ " TH. RIV. HOLES $\frac{13}{16}$ " DIA \times $\frac{7}{16}$ " HCH

CIRC: SEAMS SING: RIV⁰ RIV: HOLES $\frac{13}{16}$ DIA $\times 2\frac{1}{8}$ PCH

2" DIA STEEL STAY SCREWED
8 THDS EFF. AREA = 2.66
WASHER 6" DIA. x 1/2" TH.

STAYS IN BACKS TO BE NUTTED BOTH ENDS

Messrs J. Sudron & Co.


Boiler No 2730

for

Messrs Bartram & Sons

S.S. No 213

Working Press 80 lbs.

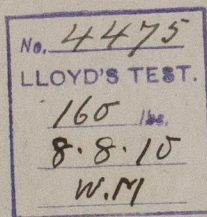

Indt Report
no 6408

J^r Leslie

Std. Rpt. 247574

Donkey boiler

RETAI



© 2020

Lloyd's Register
Foundation

W827-0060