

20.1.12
22.3.12 (11530.536)

PLAN No. 1743
FOR ENCLOSURE TO
Messrs. Lloyd's Surveyors
Hull FROM
COCHRANE & SONS,
SHIPBUILDERS, SELBY.
DATE 11/7/12.

MIDSHIP SECTION

STEEL SCREW TRAWLERS

N^o 524-589


DIM^s LEN 133'-4" x 23'-5" E x 12'-9" DEPTH MOULDED

SCALE $\frac{1}{2}$ " = ONE FOOT

Messrs Lloyd's Surveyors
Hull

Jan. 17. 1912 RK

TO CLASS 100 A1 FOR FISHING PURPOSES DECK PLATED OVER IN WAY OF
MACHINERY SPACE ENGINE & BOILER CASING AS PREVIOUSLY APPROVED

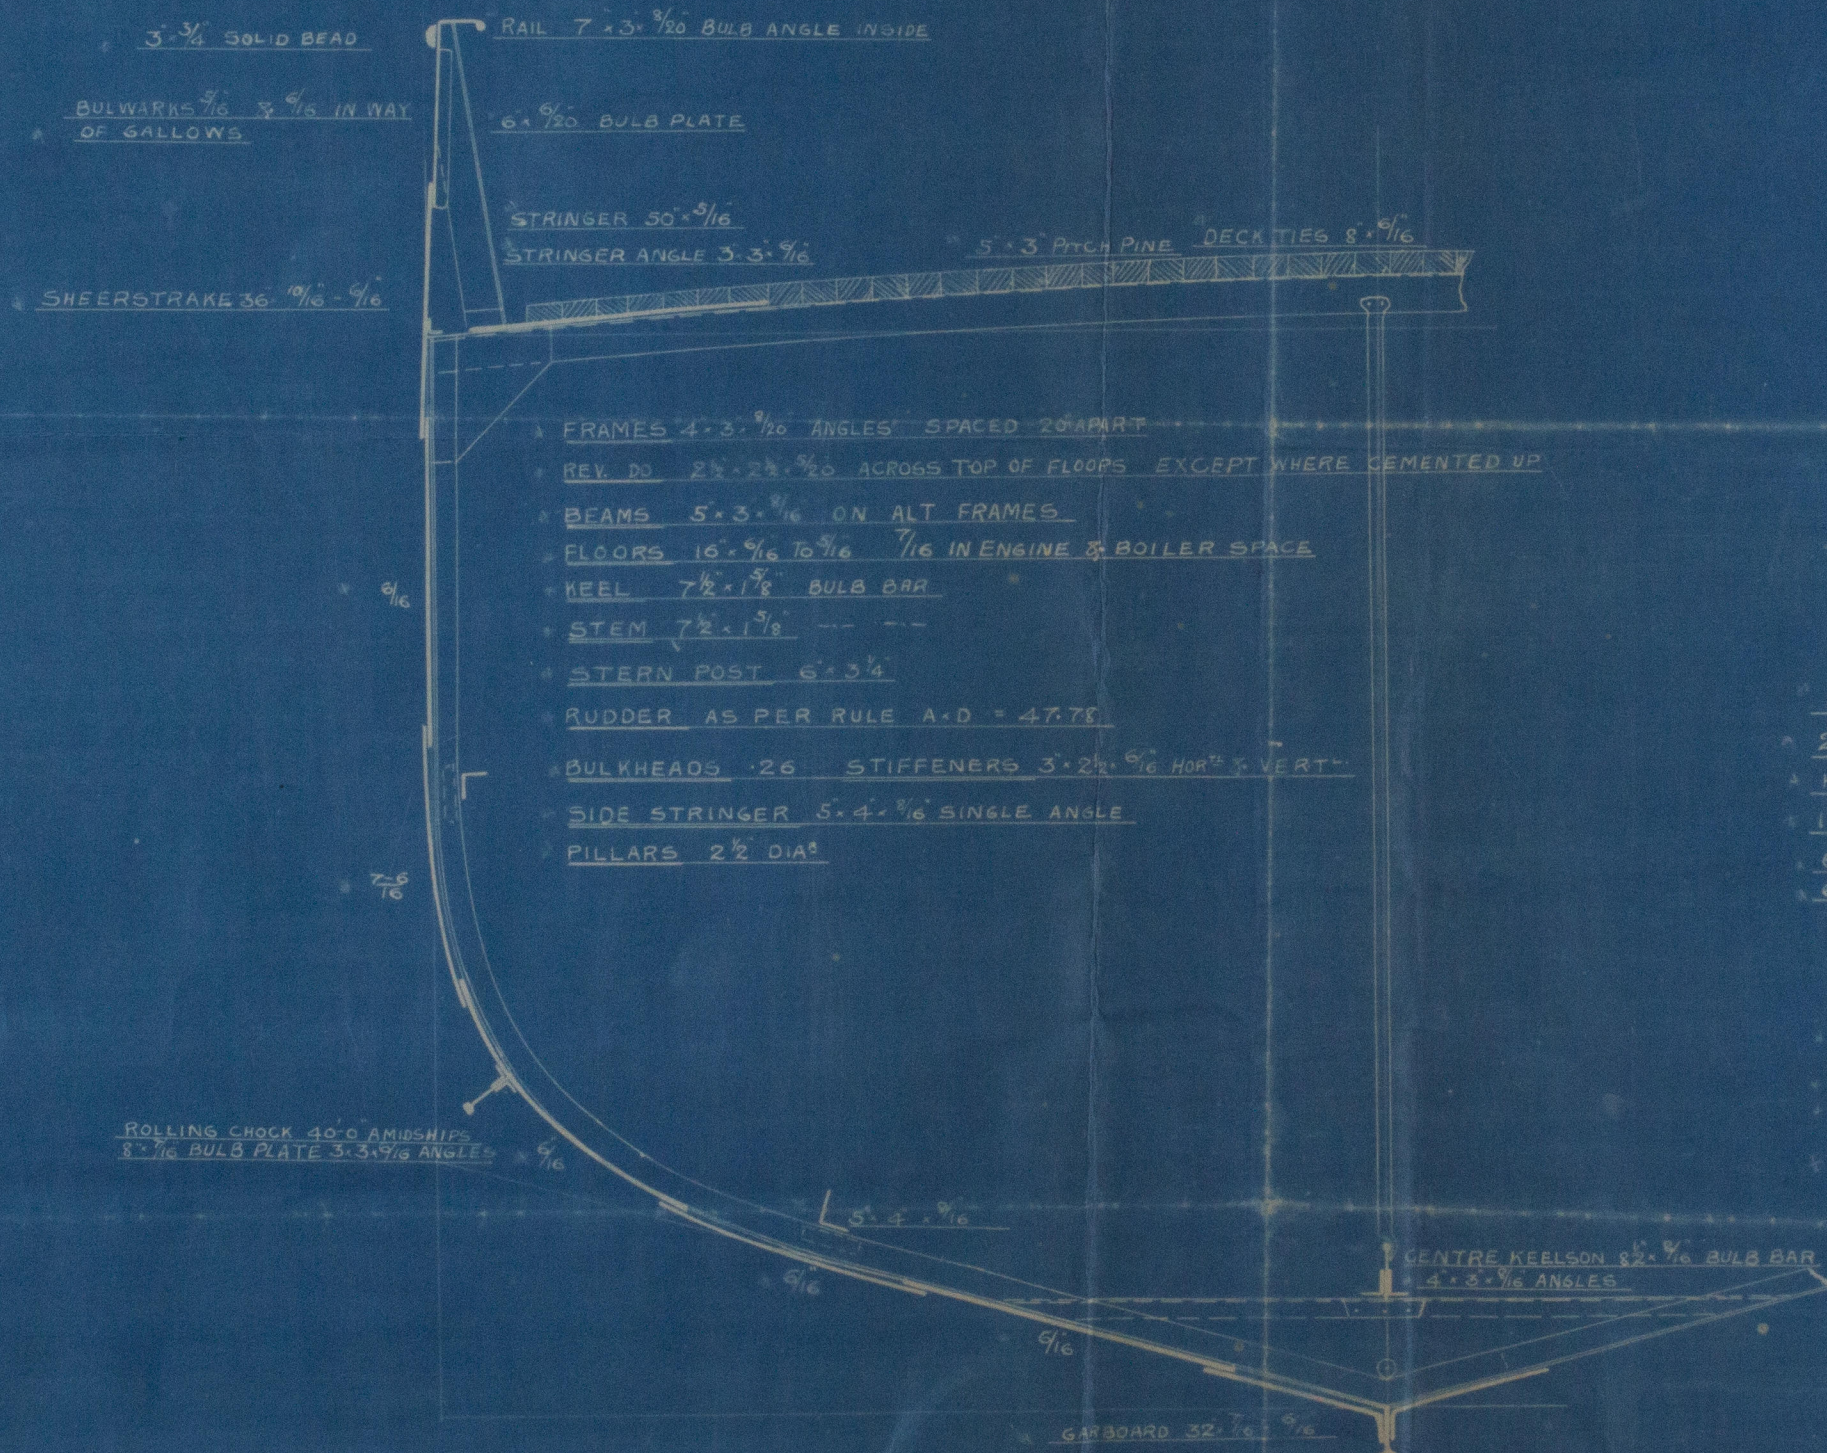

NUMERALS

B + D = 35.63
L(B + D) = 4750.55

PROPORTIONS

B/D = 10.35
B/L = 5.85

EQUIPMENT

1 st BOWER ANCHOR	5 1/4 CWTs EX STOCK
2 nd --	5 1/4 --
KEDGE	3 --
105 FATHOMS	1 1/16 CABLE
60 --	6" HAWSER
60 --	5" WARP

RIVETING

- BUTTS OF SHELL PLATING LAPPED & DOUBLE RIVETED
- EXCEPT GARBOARD & SHEERSTRAKE WHICH ARE TO BE
- STRAPPED & DOUBLE RIVETED, LANDINGS DOUBLE RIVETED
- BULWARKS SINGLE RIVETED

filled
7-1-12
6-2-17

W. J. P. 11530.536
230.232.032
160.25.11.25.2.032
Cochrane & Sons



Lloyd's Register
Foundation
W827-0104

Cochrane & Pons

N^o. 525 Same as

N^o. 524-5-9 and 530-5-6

Duplicate

Midship Midship.

1/2 Lord Carrington

Hull Report No: 25511.



© 2020

Lloyd's Register
Foundation

W829-0104