

10-1-12
3-12 (11' 4" 30' 103' 10")

PLAN No. 1744
FOR ENCLOSURE TO
FROM
OCHRAINE & SONS,
SHIPBUILDERS, SELBY,
DATE 11/7/12

PROFILE & DECK PLAN

STEEL SCREW TRAWLERS


No. 524-589

DIMNS LEN 133' 4" 23' 0" x 12' 9" DEPTH MOULDED

SCALE 1" = ONE FOOT

James Lloyd, Surveyor
Gull

Jan 17 1912 K.R.

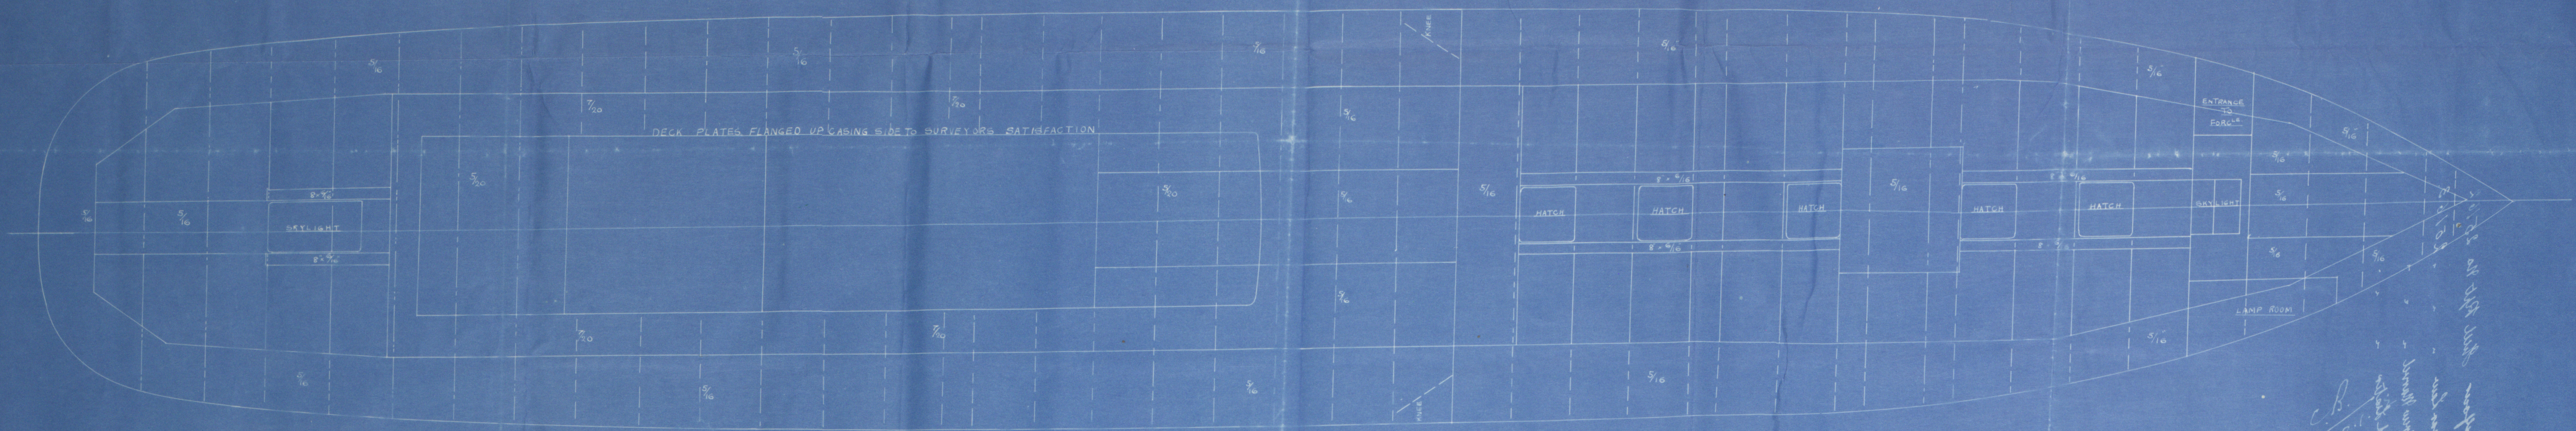

with all ship work
done
1/10/12
C.P.
20/11

SEA 252 HS 252
1/10/12
SEA 252 HS 252
1/10/12

Cochrane & Sons
No 535 same as
No 524.59 and 530.516

Duplicate -
Profile & Deck plans.

to Lord Carrington

Hull Report No: 25511



RETAIN



© 2020

Lloyd's Register
Foundation