


CLASS 100A.I. ~~440505~~

To LLOYDS. 1923 & 24 RULES

LENGTH B.P.	399.6
BREADTH EXTREME.	53.0
DEPTH MOULDED	27.5 TO 2 ND DECK.
	35.5 TO UPPER DECK

RULE LENGTH	399.0
" BREADTH	52.71
" DEPTH	35.41

EQUIPMENT NUMBER. 35673.

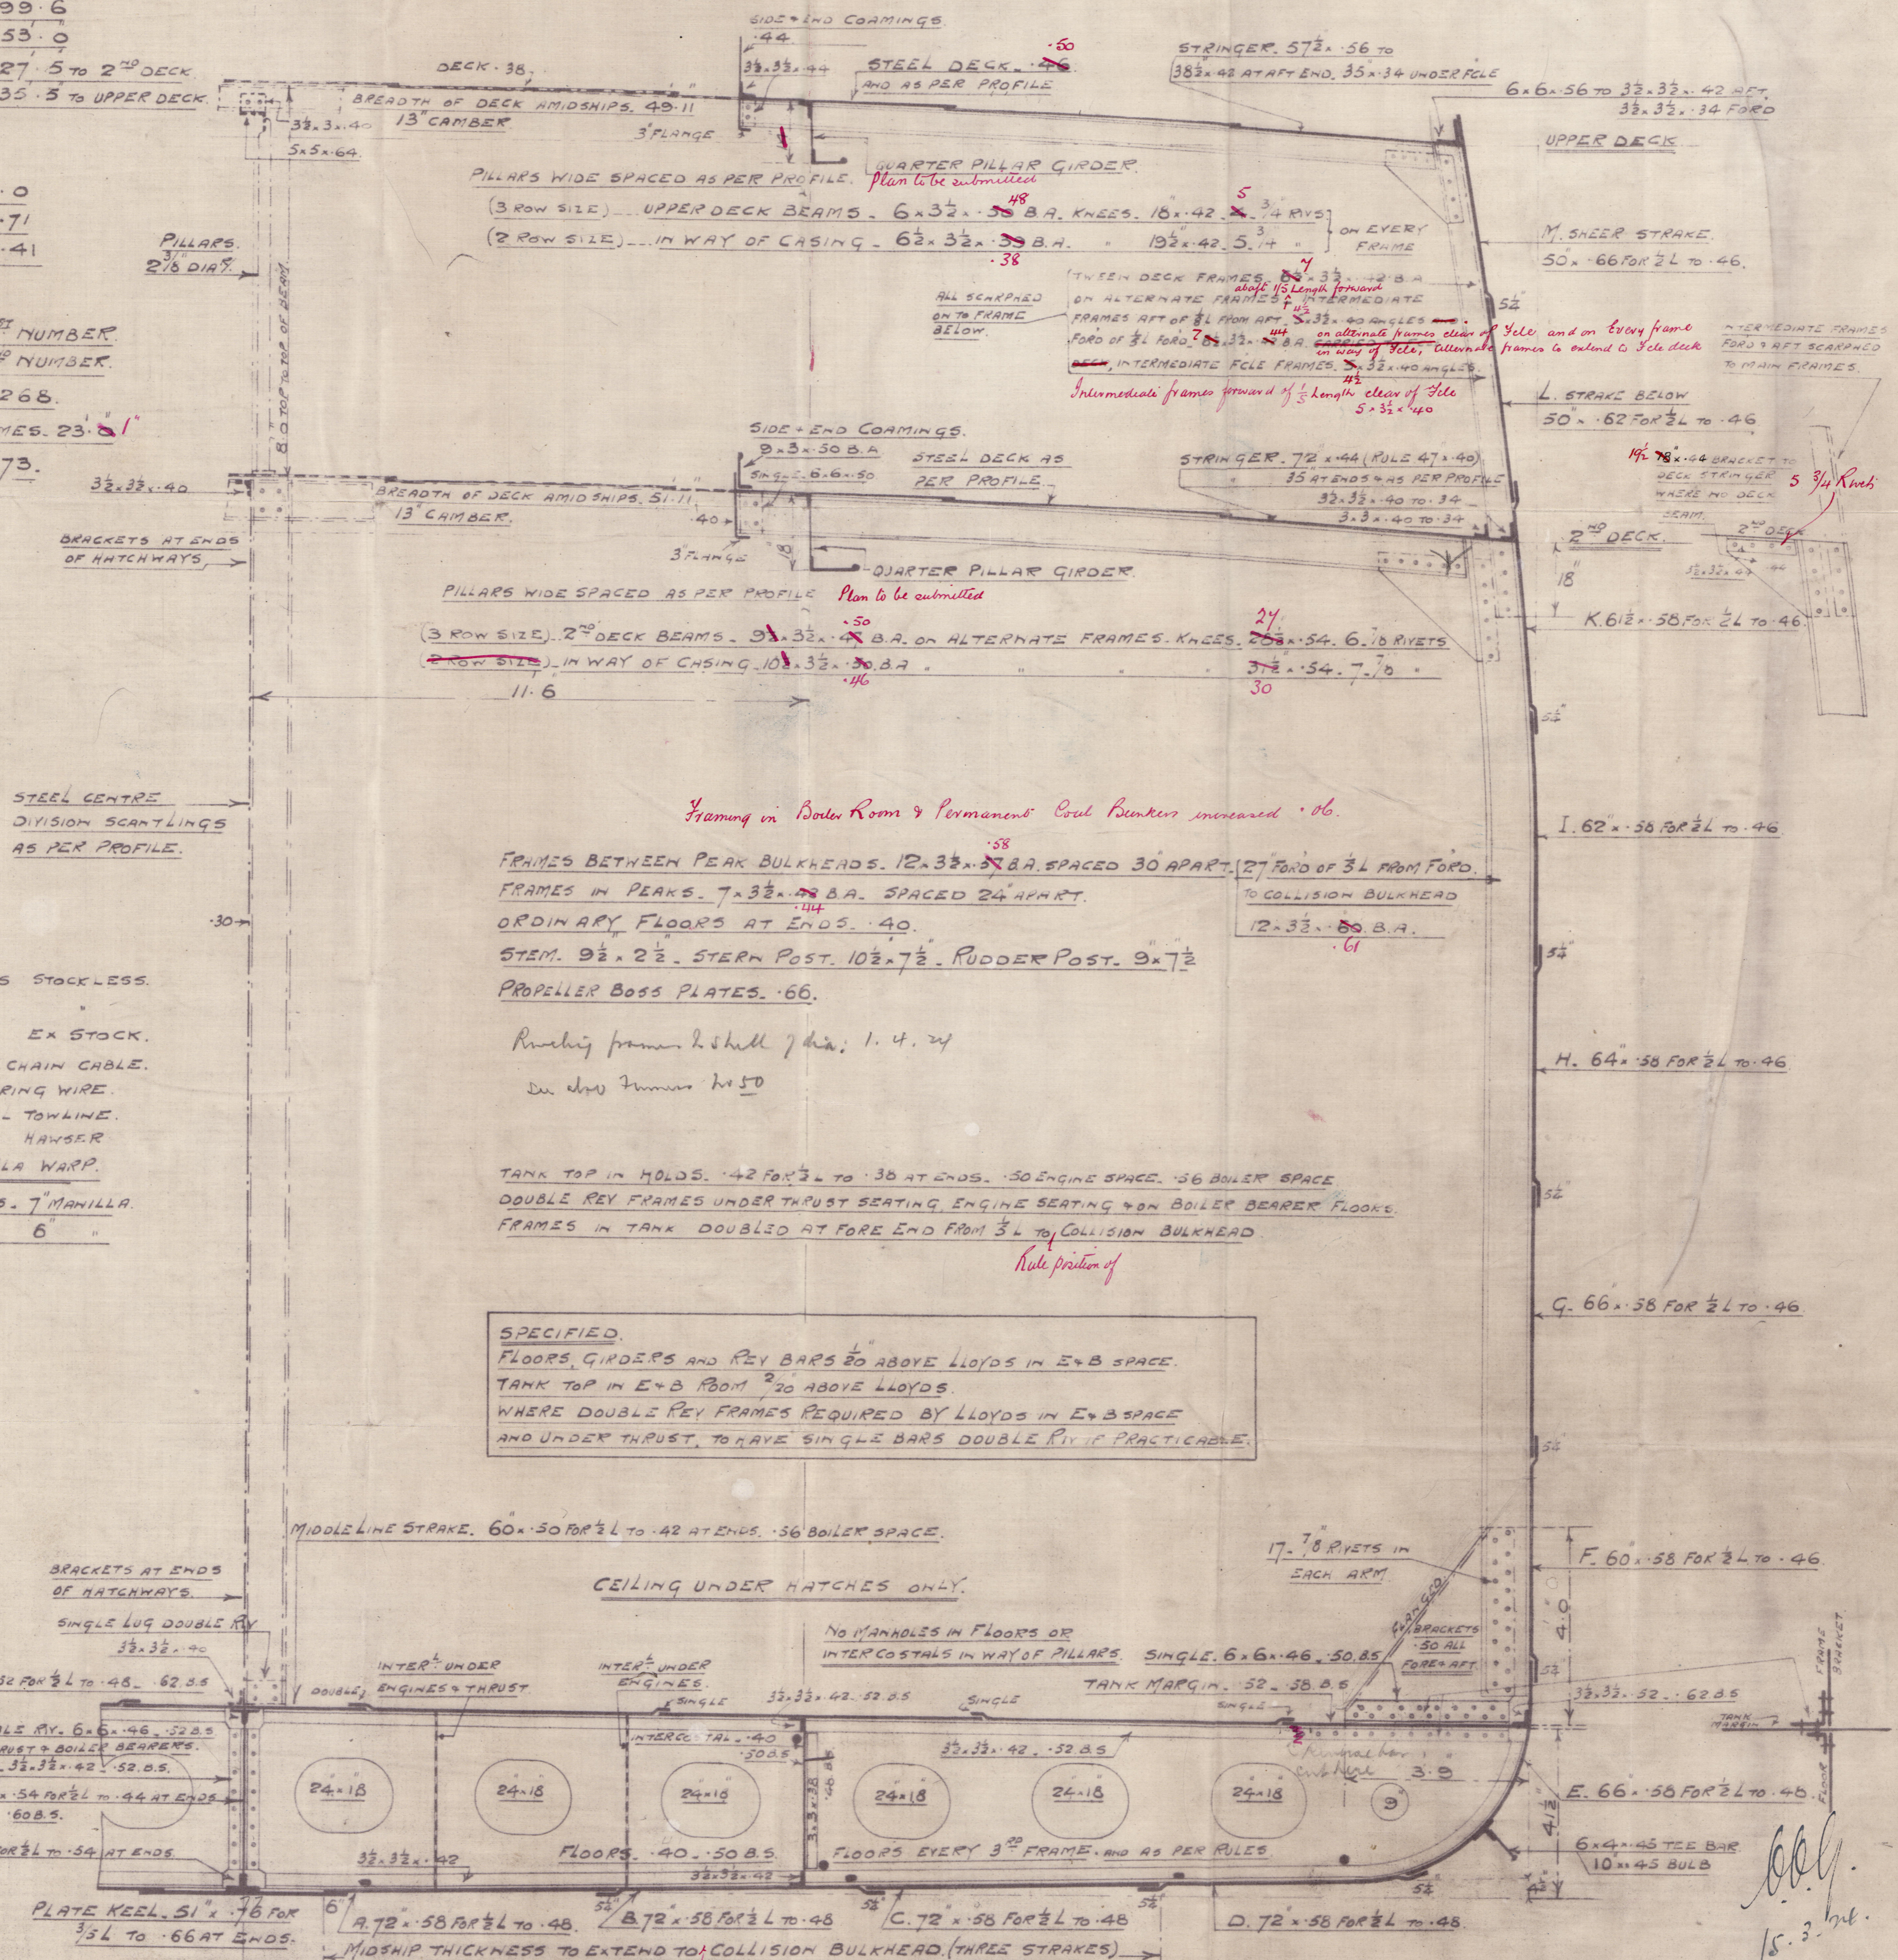

2. BOWERS. 63³/₄ CWTs STOCK LESS.
1. BOWER. 54¹/₂ " " "
1. STREAM. 17¹/₂ " EX STOCK.
270 FATHOMS. 24¹/₂ " STD CHAIN CABLE.
90 " 4³/₄ " MOORING WIRE.
120 " 5ⁿ " STEEL TOWLINE.
20F 90 " 24³/₄ " HAWSER.
20F 90 " 7ⁿ " MANILLA WARP.

2. CHECK ROPES. 90 FATHOMS. 7" MANILLA.
2. TRANSPORTING LINES. 90 " 6" "

SPECIFIED.
FLOORS, GIRDERS AND KEY BARS $\frac{1}{20}$ " ABOVE LLOYDS IN E+B SPACE.
TANK TOP IN E+B ROOM $\frac{2}{20}$ " ABOVE LLOYDS.
WHERE DOUBLE KEY FRAMES REQUIRED BY LLOYDS IN E+B SPACE
AND UNDER THRUST, TO HAVE SINGLE BARS DOUBLE KEY IF PRACTICABLE.

RICHARDSON DUCK & CO LTD
SHIPBUILDERS,
STOCKTON UPON TEES.

TRACING N^o 8030

11/3/1924.

11. 3. 24

Master Richardson Creek Hole


No 689

Mid: Sec:

S.S. Southborough
MDB. RPT. No. 12064
(found)

S.S. Southborough
MDB. RPT. No. 12408.
(quartz section)

W83-0036

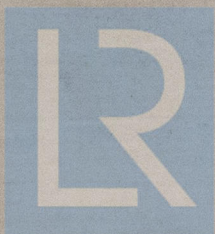

© 2019

Lloyd's Register
Foundation