

MESSRS CRAIG, TAYLOR & CO^S NO 147. 148.

SLAIR & COY., LTD.
ENGINEERS,
29 MAR 11
STOCKTON-ON-TEES.

Messrs Blair & Co Ltd

Gross 1726
1727


for

Messrs Craig Taylor & Co

S.S. No 147

" 148

Working Press 180 lbs.

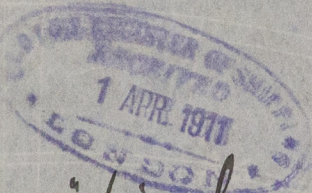

S.S. "Wimborne"

1726

No.	4743
LLOYD'S TEST	
360 lbs.	
22-9-11-WM	

Mat. Report
y/48

"Wimborne"

No.	4784
LLOYD'S TEST	
360 lbs.	
27-11-11-WM	

Mat. Report
7d do

W/83-0059

© 2019



Lloyd's Register
Foundation

W/83-0059(112)

1102

March 29th 1911

From BLAIR & CO., Ltd.,
STOCKTON-ON-TEES.

To

Messrs Lloyd's
Engineer Surveyors
Middlesbrough

Main Boilers
Engines

Lloyd's Register
Foundation
No 1726 & 1727

B 2242