



10.11.13
22.11.13
27.11.13
18.12.13

Profile & Deck Plans.


Nº 273.
Scale 1/8" = 1 Foot.

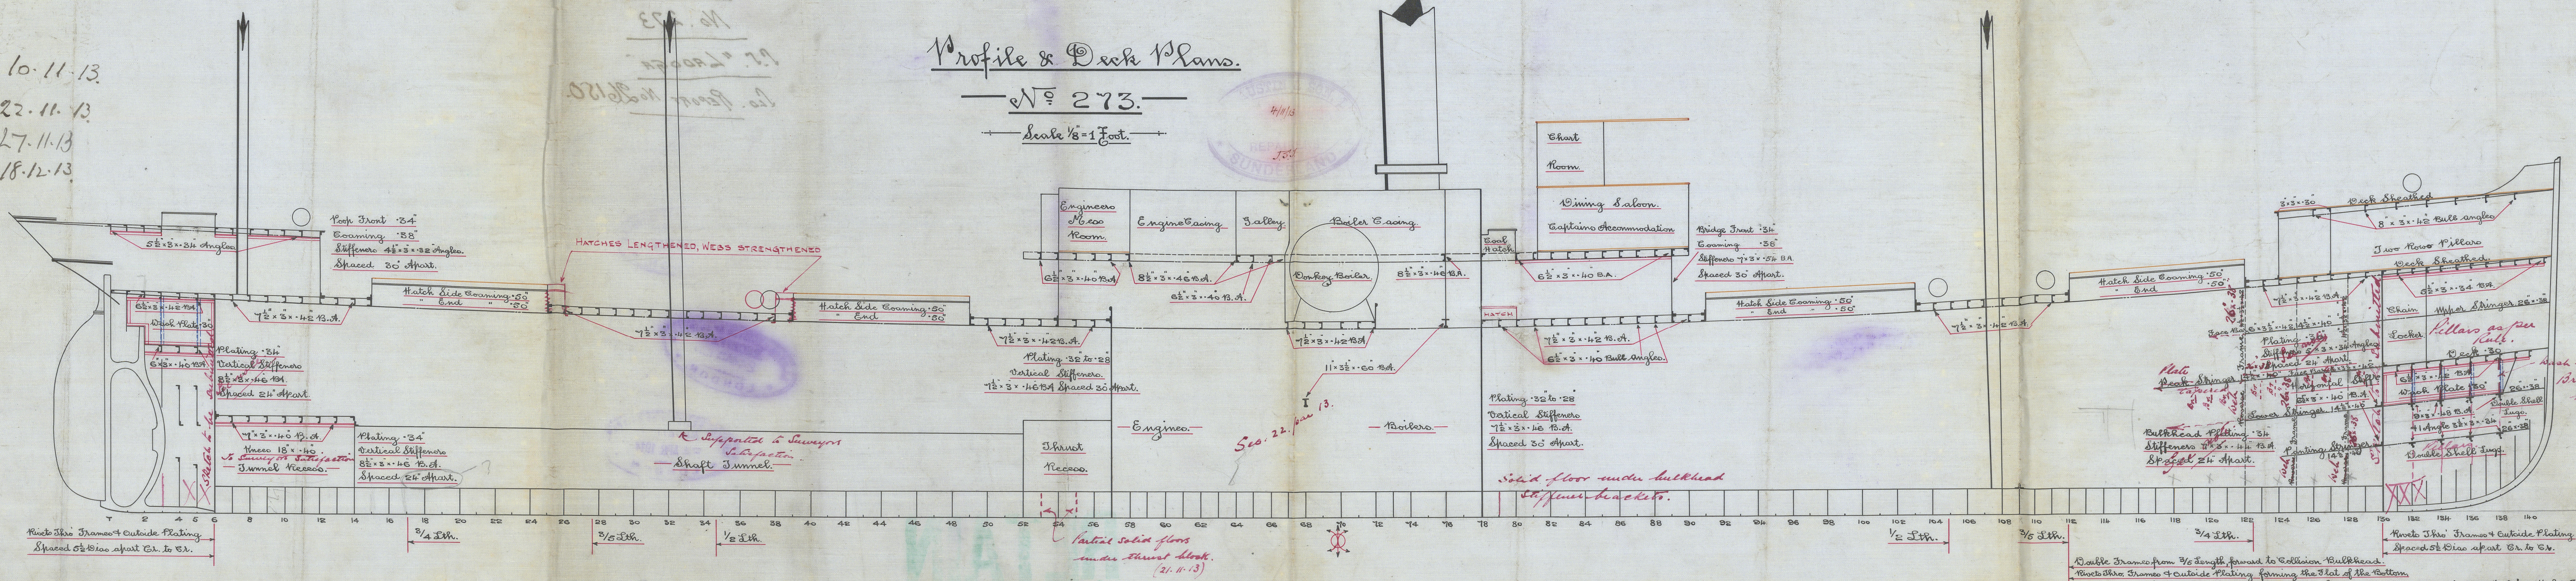

UPPER DECK.

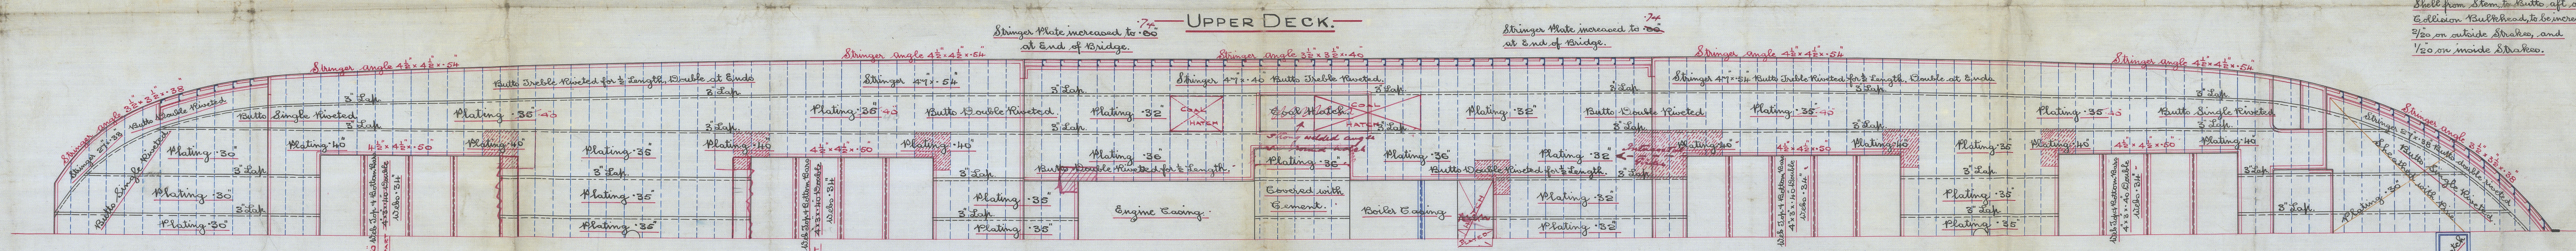


POOP DECK.

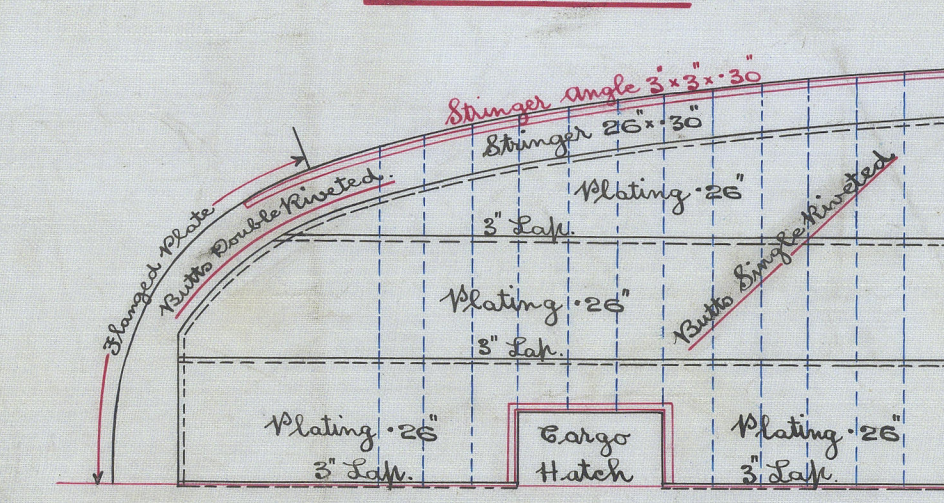


Particulars for Freeboard.

Length B.P.	276'-0"
Length L.W.S.	274'-6"
Breadth Extreme	40'-0"
Depth Moulded	21'-6"
Depth Hold	19'-2"
Sheer Forward	7'-3"
Sheer from Forward	4'-3"
Sheer Aft	3'-3"
Sheer from aft	1'-10"
Length Poop	24'-0"
Length Bridge	72'-0"
Length Forecastle	31'-0"
Coef of Displacement	1765
Under Deck Storage Approx.	1770
Single Deck 3yrs. No Ceiling on Tank Top.	
Cargo Battens to be fitted.	

BRIDGE DECK.

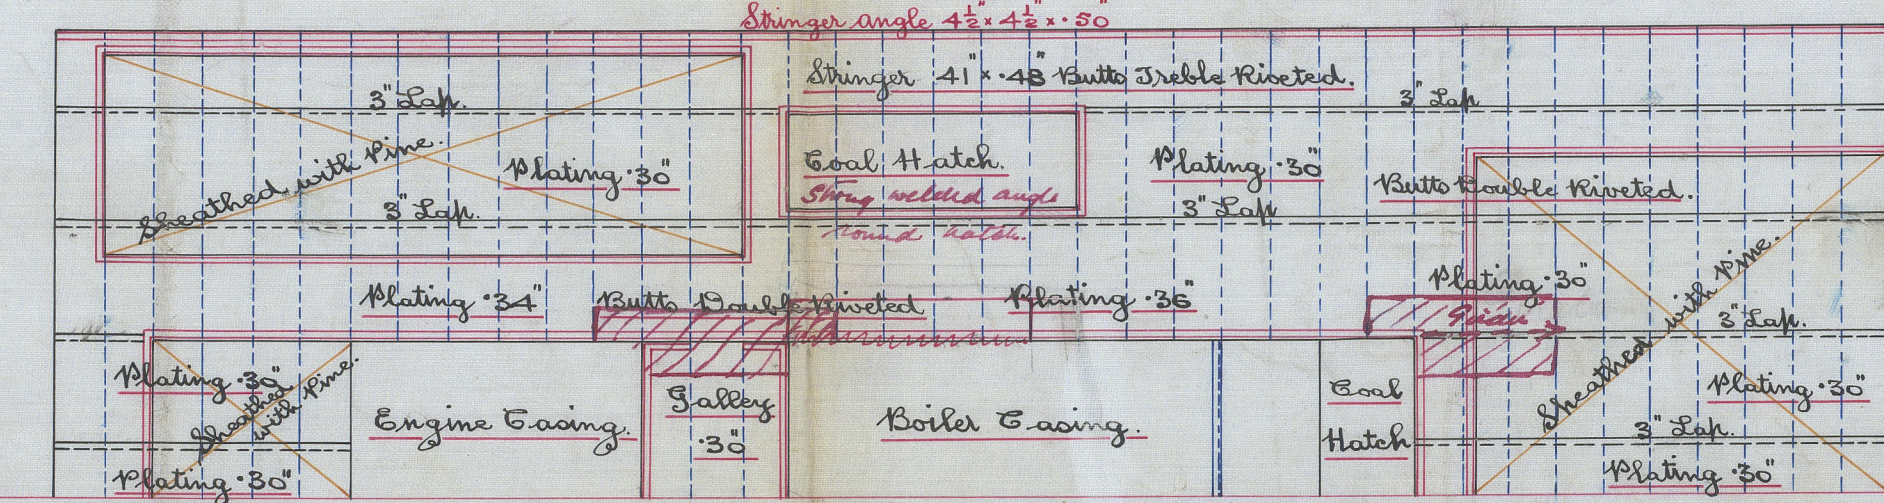

FO'LE DECK.

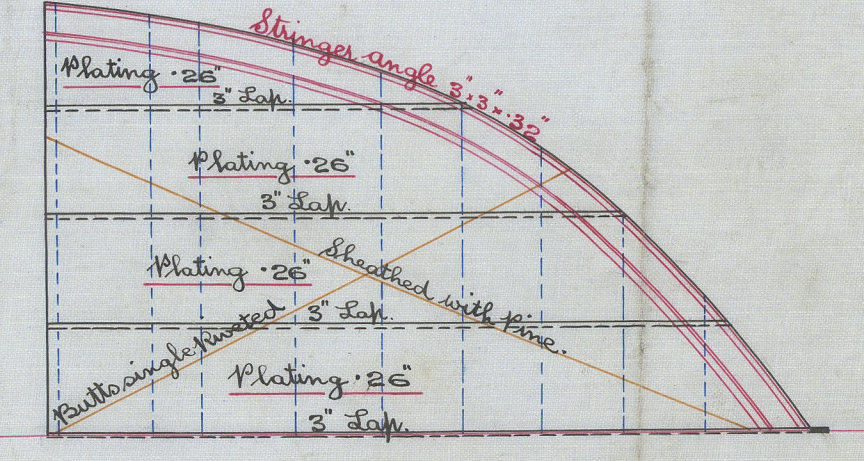

C.P.
10.11.13.

Del
5.11.13

SUNDERLAND

Mess rs P. P. Austin & Son

PROFILE + DECK PLAN

No. 273


P.S. "LADOGA"

Geo. REPORT No 26150

1. Profile & Deck Plan

2. S.S. 273

3. Deck Plan

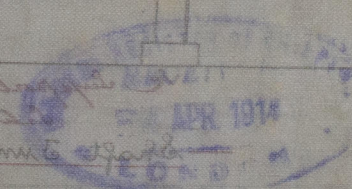

RETAIN



© 2020
Lloyd's Register
Folio W830-0090