

## BOILER.

SCHEDULE "L"

WRITTEN DIMENSIONS ONLY TO BE TAKEN.



CONTRACT 2161. 2.OFF.

DRAWING N° 4612.




N. E. M. E. Co. LD  
SLD

C. No 2161

MAIN BOILERS

2 OFF.

No 3216  
LLOYD'S TEST  
360 LBS  
15-5-14 W.B.

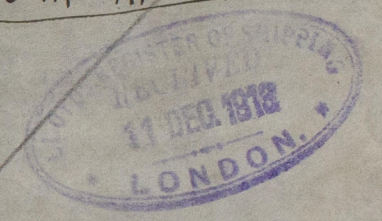

✓  
AMENDED PLAN.

AUSTINS. 273 5/5  
8/8 "Ladoga"

