



30.10.05
6.11.05
22.11.05



MIDSHIP SECTION — N° 237. —

LENGTH, B.P. — 310'-0"

BREADTH, MLD. — 43'-9"

DEPTH, MOULDED. — 22'-10"

SCALE 1/2" = 1 FOOT.

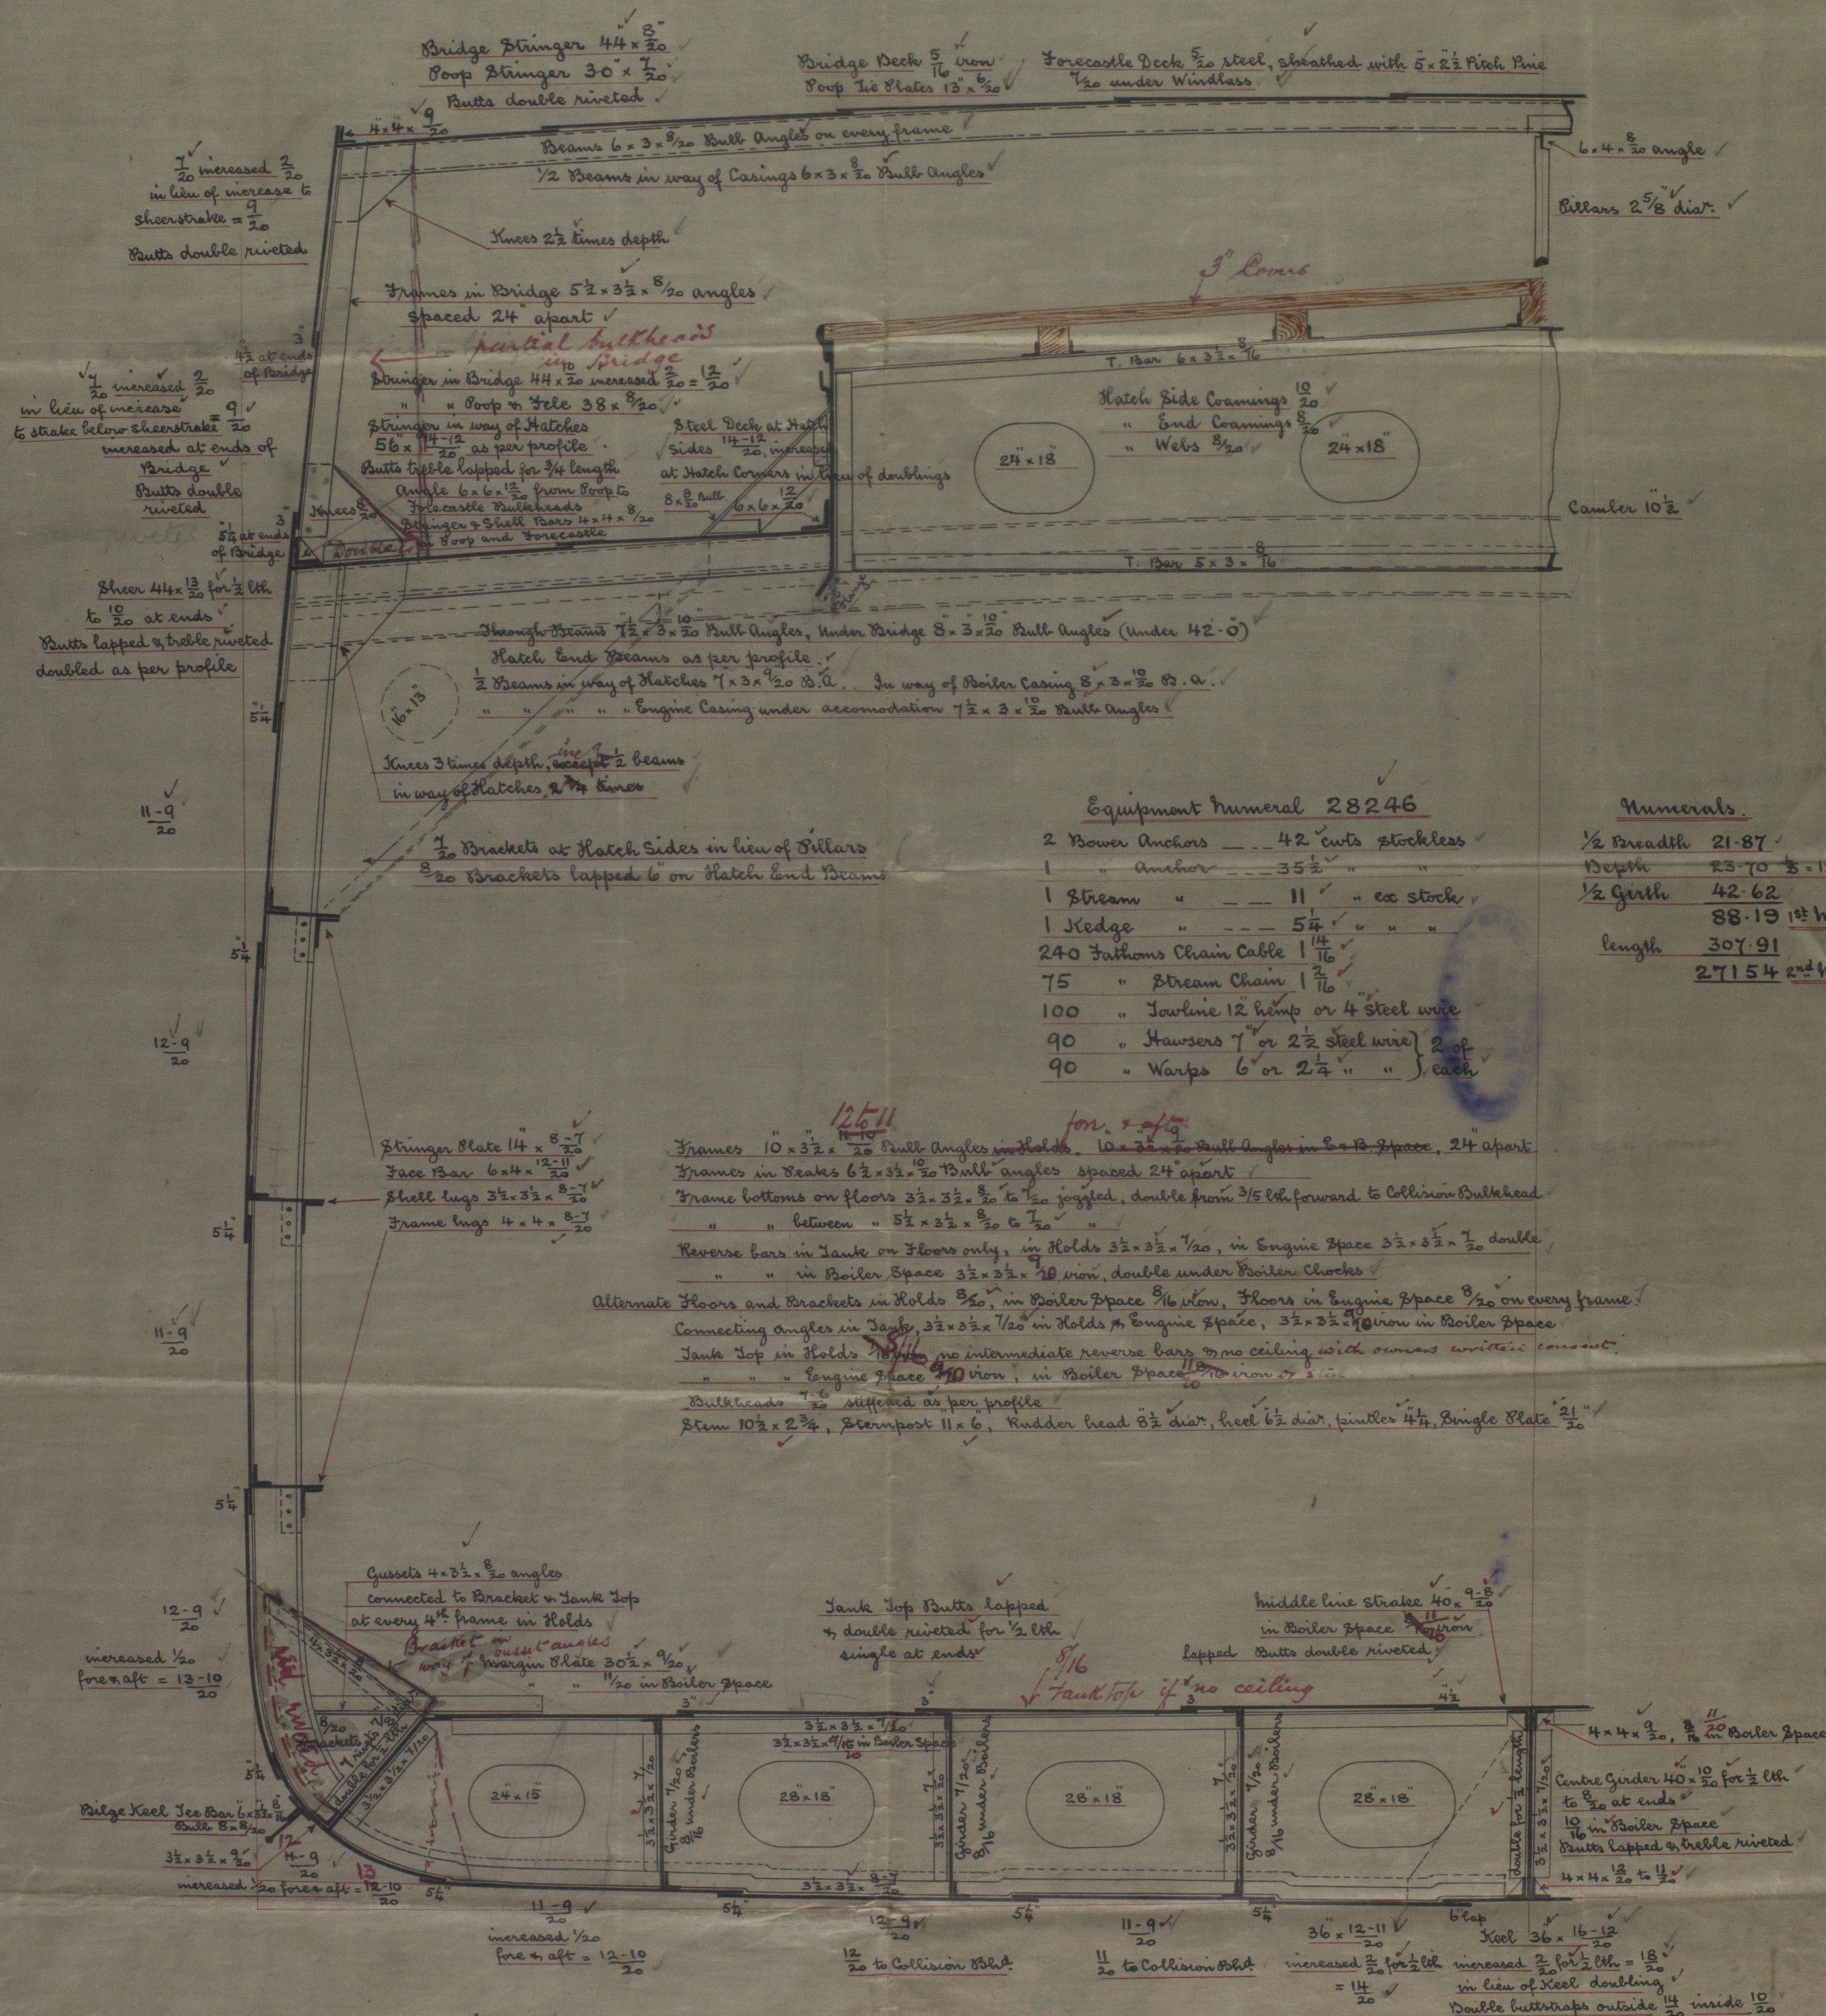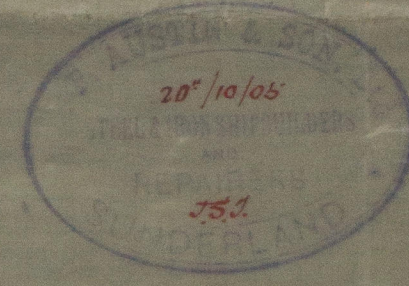

Equipment numeral 28246

2 Bower Anchors	42 cuts stockless
1 " Anchor	35 1/2 "
1 Stream "	11 " co stock
1 Kedge "	5 1/4 " "
240 Fathoms Chain Cable	1 1/4 "
75 " Stream Chain	1 1/2 "
100 " Trawl line 12 hemp or 4 steel wire	
90 " Hawser 7 or 2 1/2 steel wire	2 of
90 " Warps 6 or 2 1/4 "	each

Numeral

1/2 Breadth	21-87
Depth	23-70 1/2 = 12-99
1/2 Girth	42-62
	88-19 1st Number
Length	307-91
	27154 2nd Number

Butts of Shell Plating lapped and treble riveted
Where outside strakes exceed 46" and inside strakes exceed 54" wide
Butts quadruple riveted for 1/2 length, treble at ends.

28
30.10.05




W830-0154 2020

Midships section
for
Messrs S. P. Austin & Son
No 237

S. S. Lady Mary Wight

Order E. No 22944

 


20.01.02

[Handwritten signature]

RETAIN


W830-0164


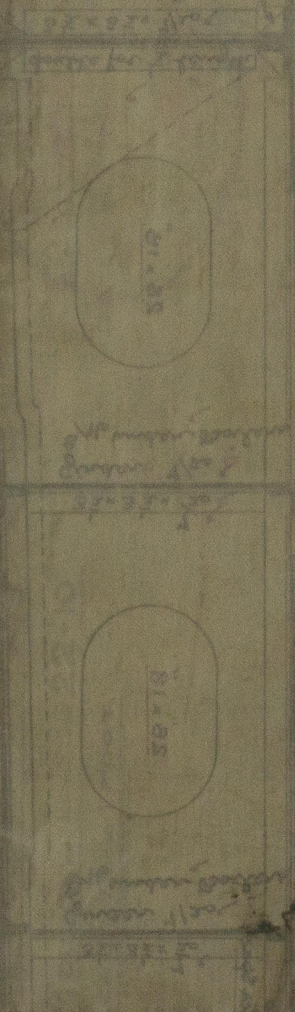



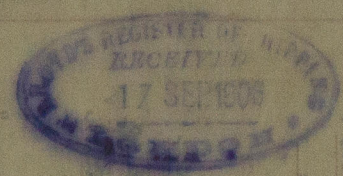




© 2020 Lloyd's Register Foundation