




25:4:06

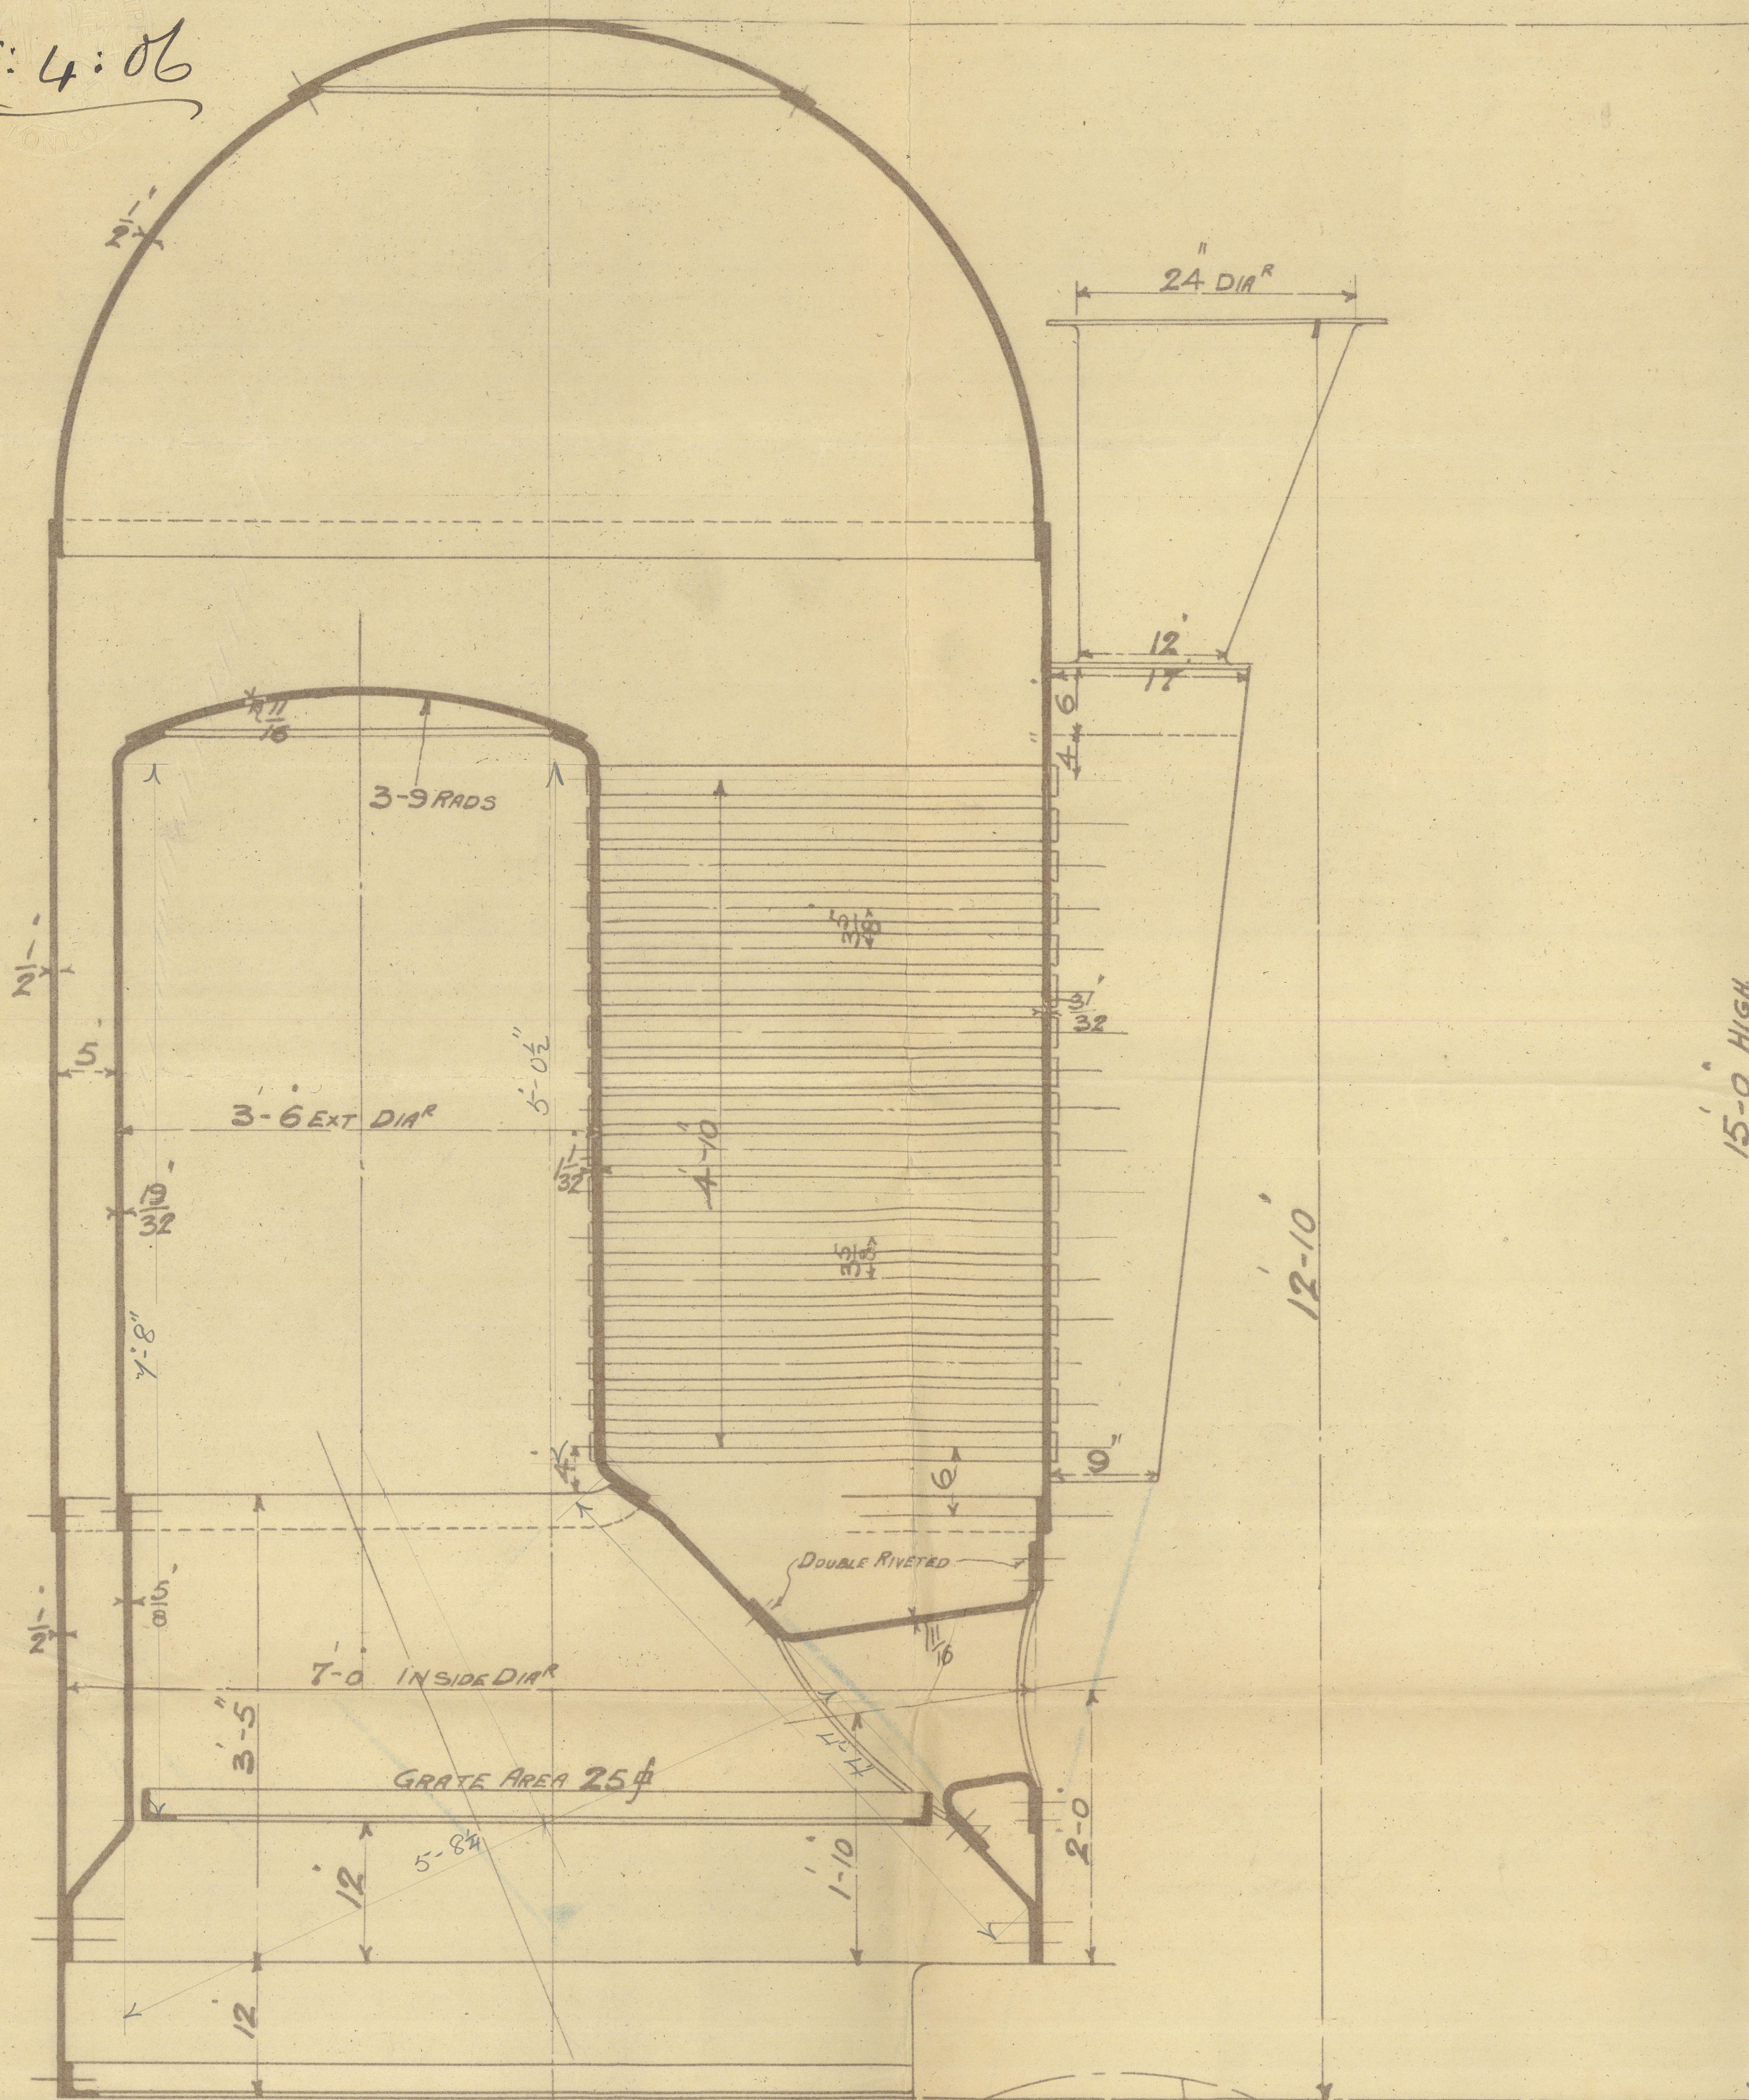


SECTIONAL ELEVATION

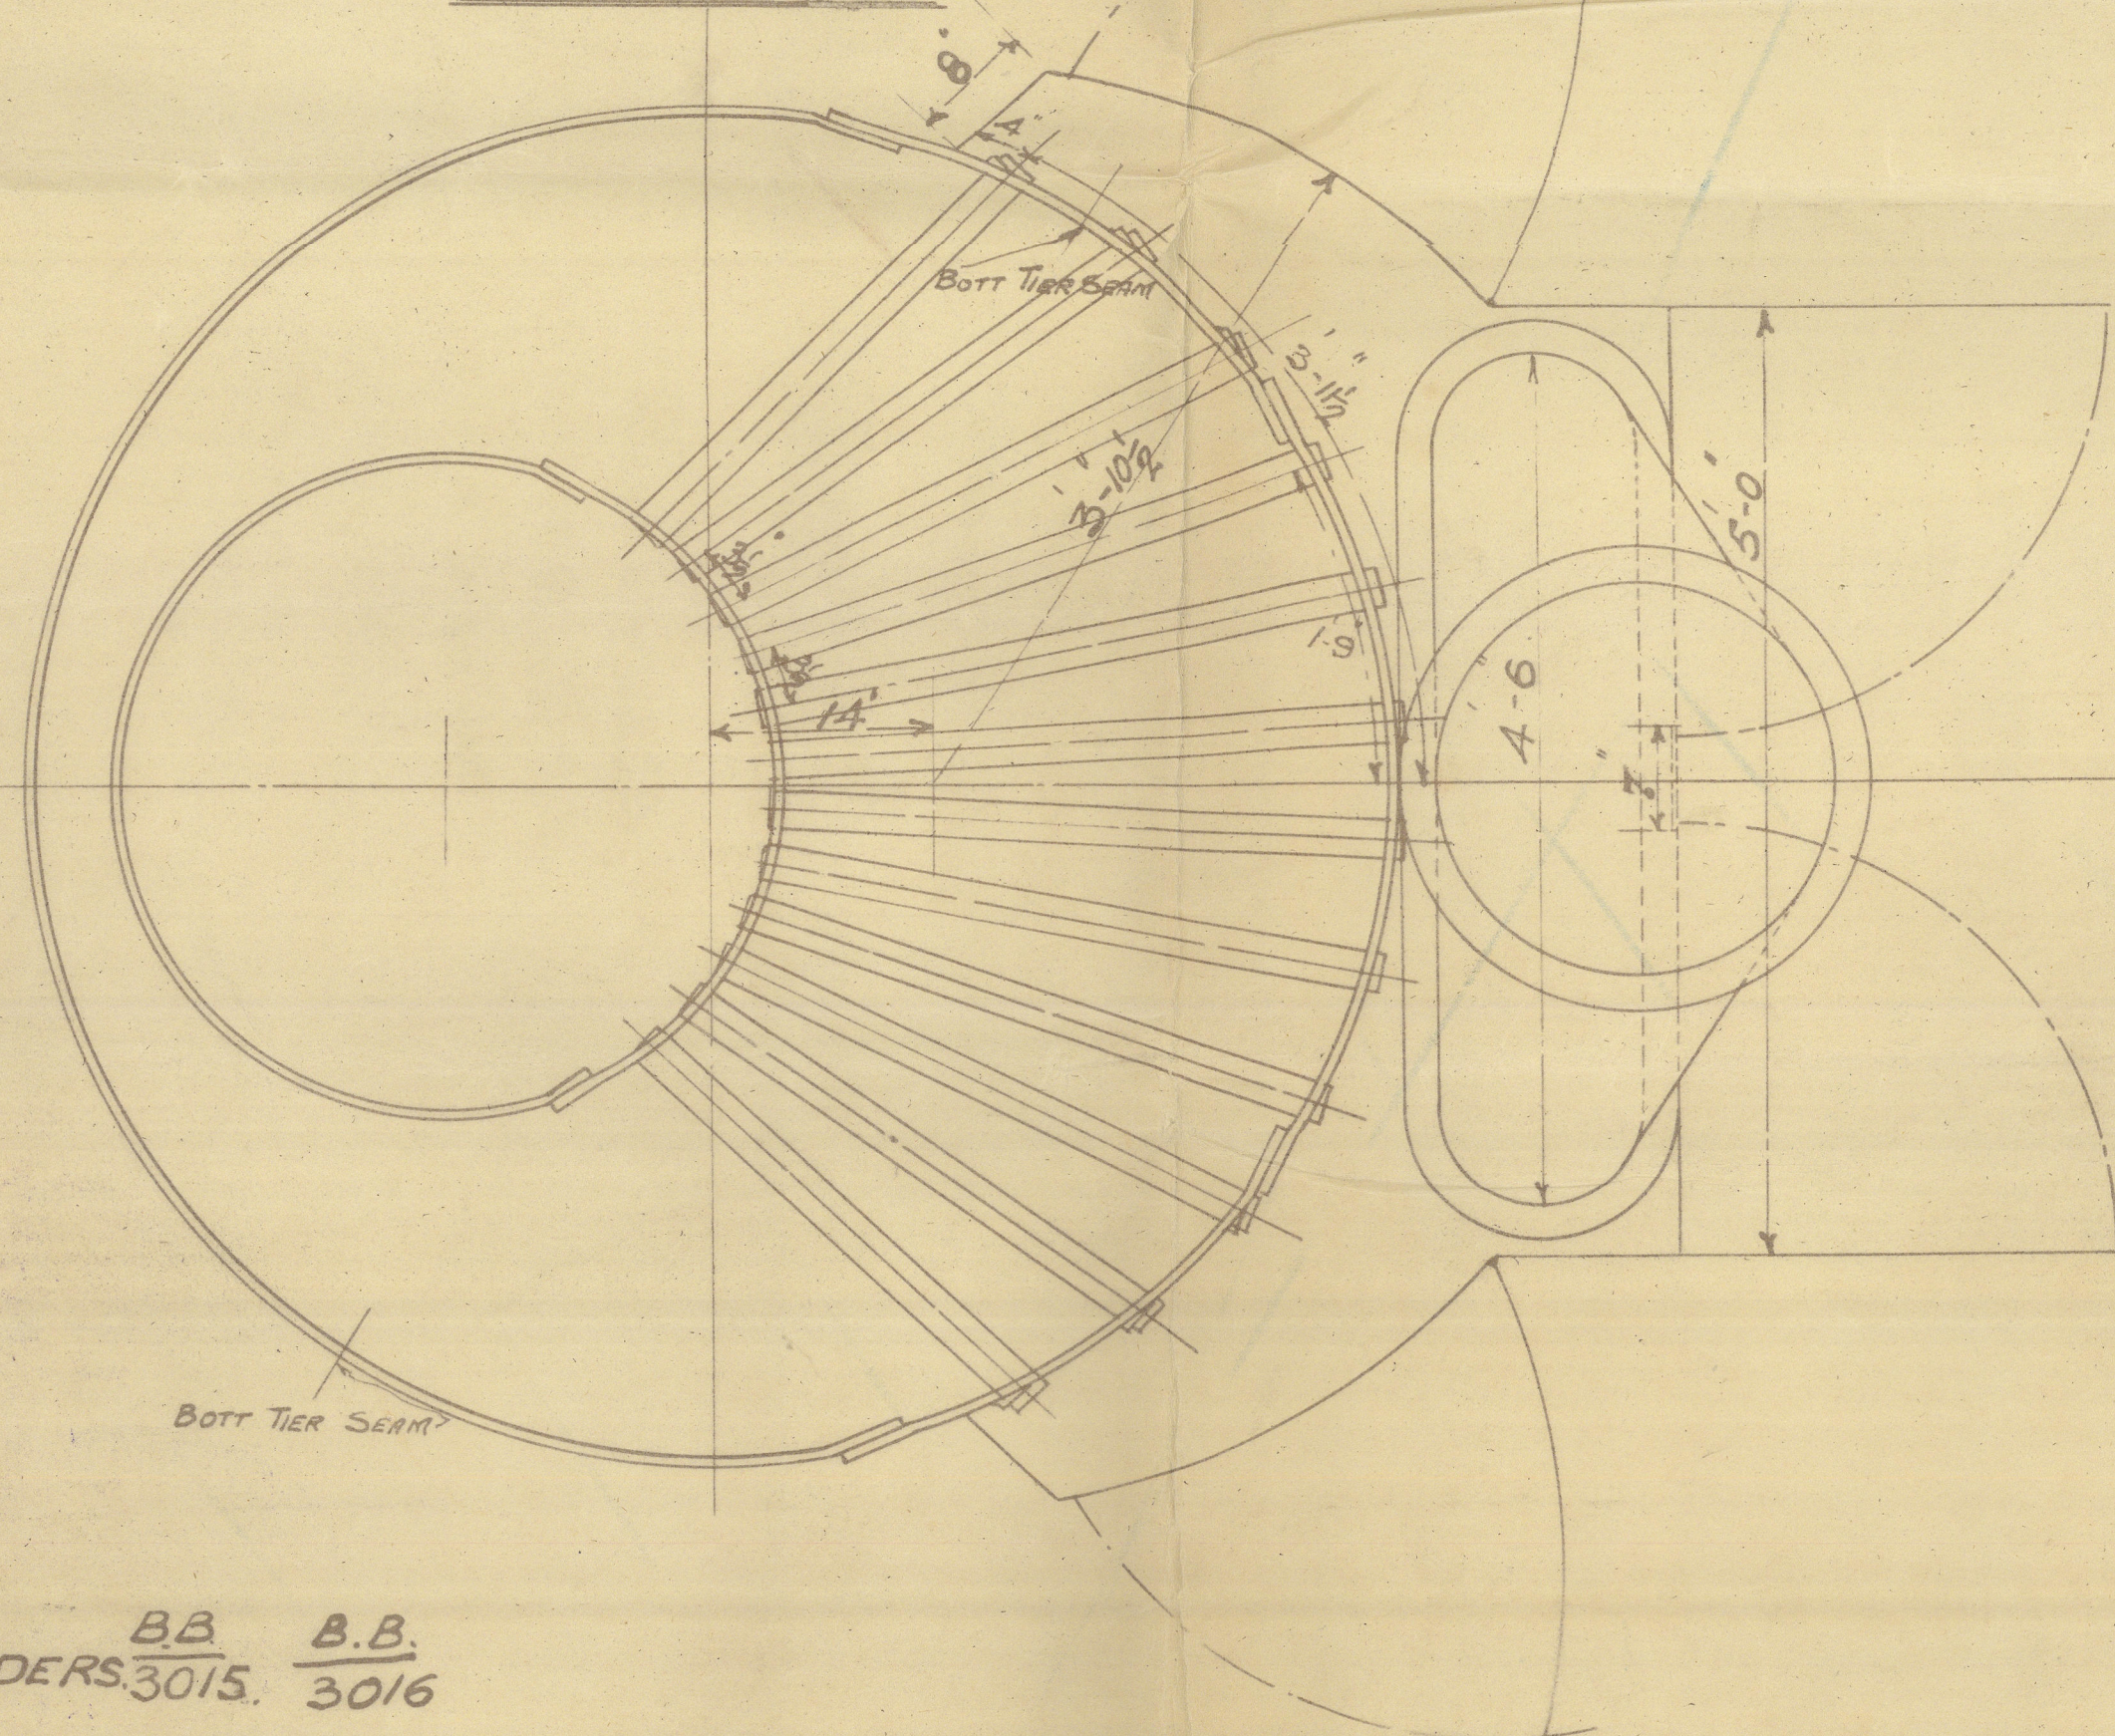


BB B.B.
ORDERS 3015. 3016

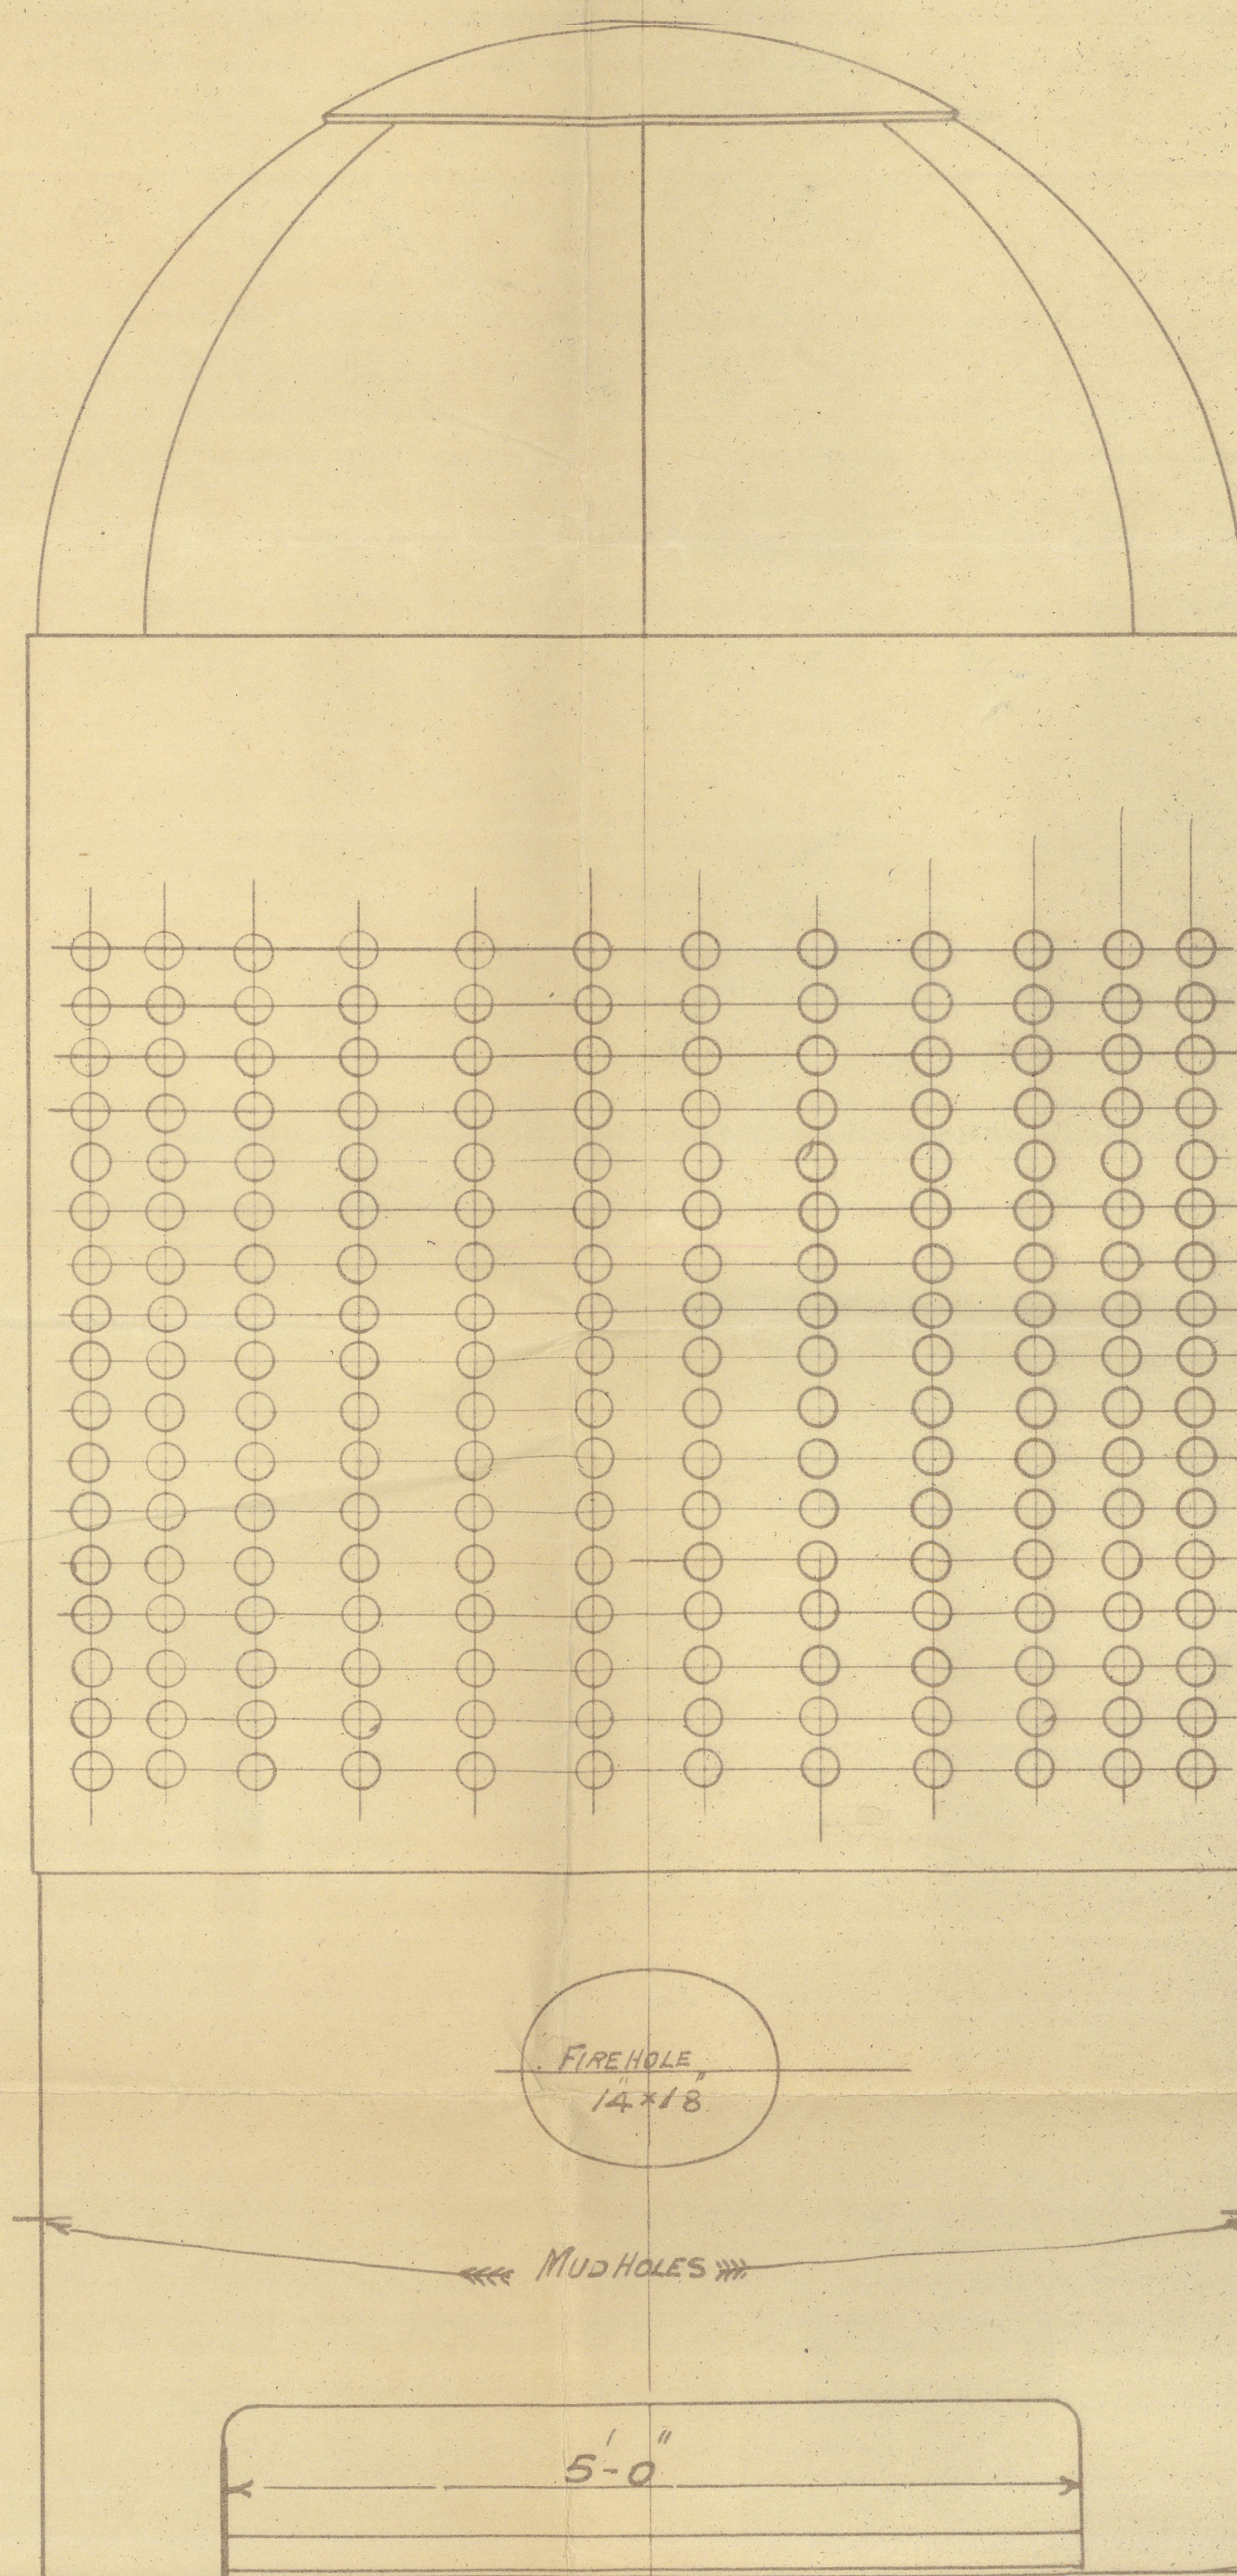

FRONT ELEVATION

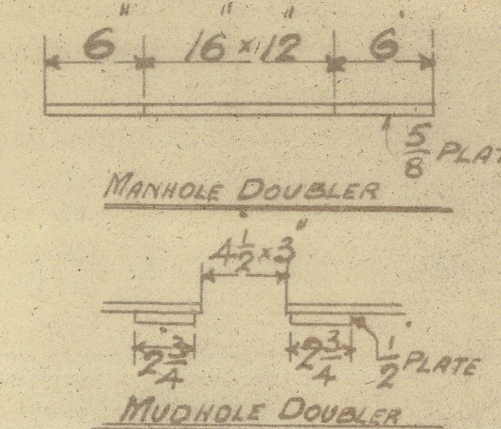

SHELL RIVETING HOLES DRILLED

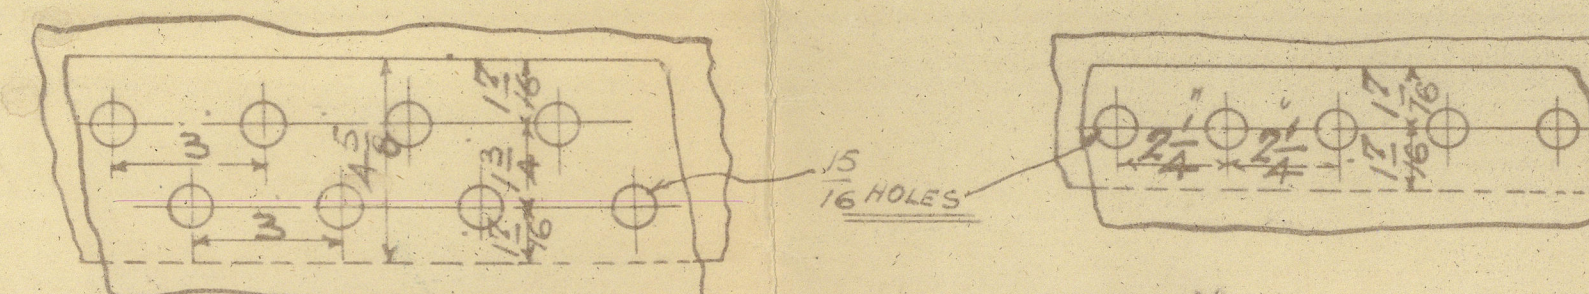

LONGITUDINAL SEAMS

CROWN AND CIRCULAR SEAMS

WORKING PRESSURE 90 LBS PER SQ INCH

204 PLAIN TUBES 2 1/2\"/>


STEEL PLATES & RIVETS. IRON TUBES

TENSILE STRENGTH OF SHELL PLATES 27 TO 32 TONS

DO OF ALL OTHER PLATES 26 TO 30 TONS

"BLAKES" PATENT BOILER TO LLOYDS SURVEY

HEATING SURFACE 550 SQ FEET SCALE 1\"/>

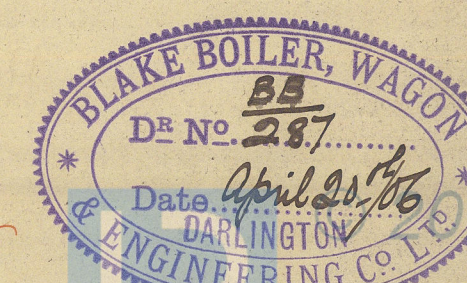

25:4:06

25:4:06

Blakes Patent
Donkey Boilers



Nos 3015-~~3016~~

Blake Boiler, Wagon & Eng Co. Ltd.


S. P. Austin & Son Ltd

S S Nos 237-~~238~~

mat report no 4695

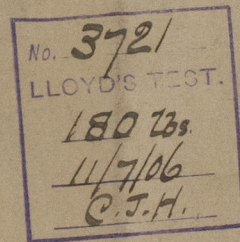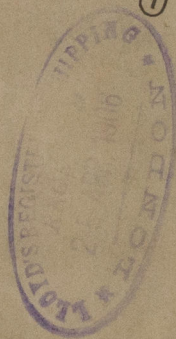


Reported

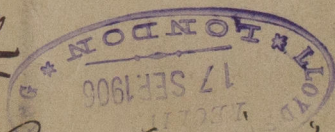

S. S. Lady Cory & Co
Slds S. E. No. 22944

RETAIN

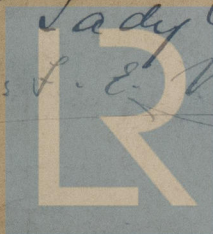

Lloyd's Register
Foundation
W830-0155