

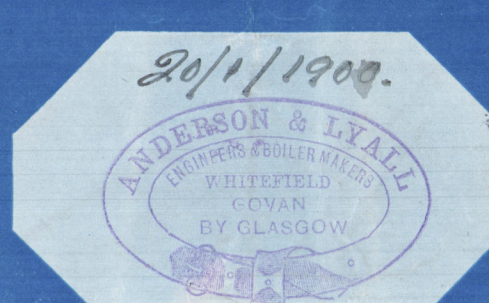
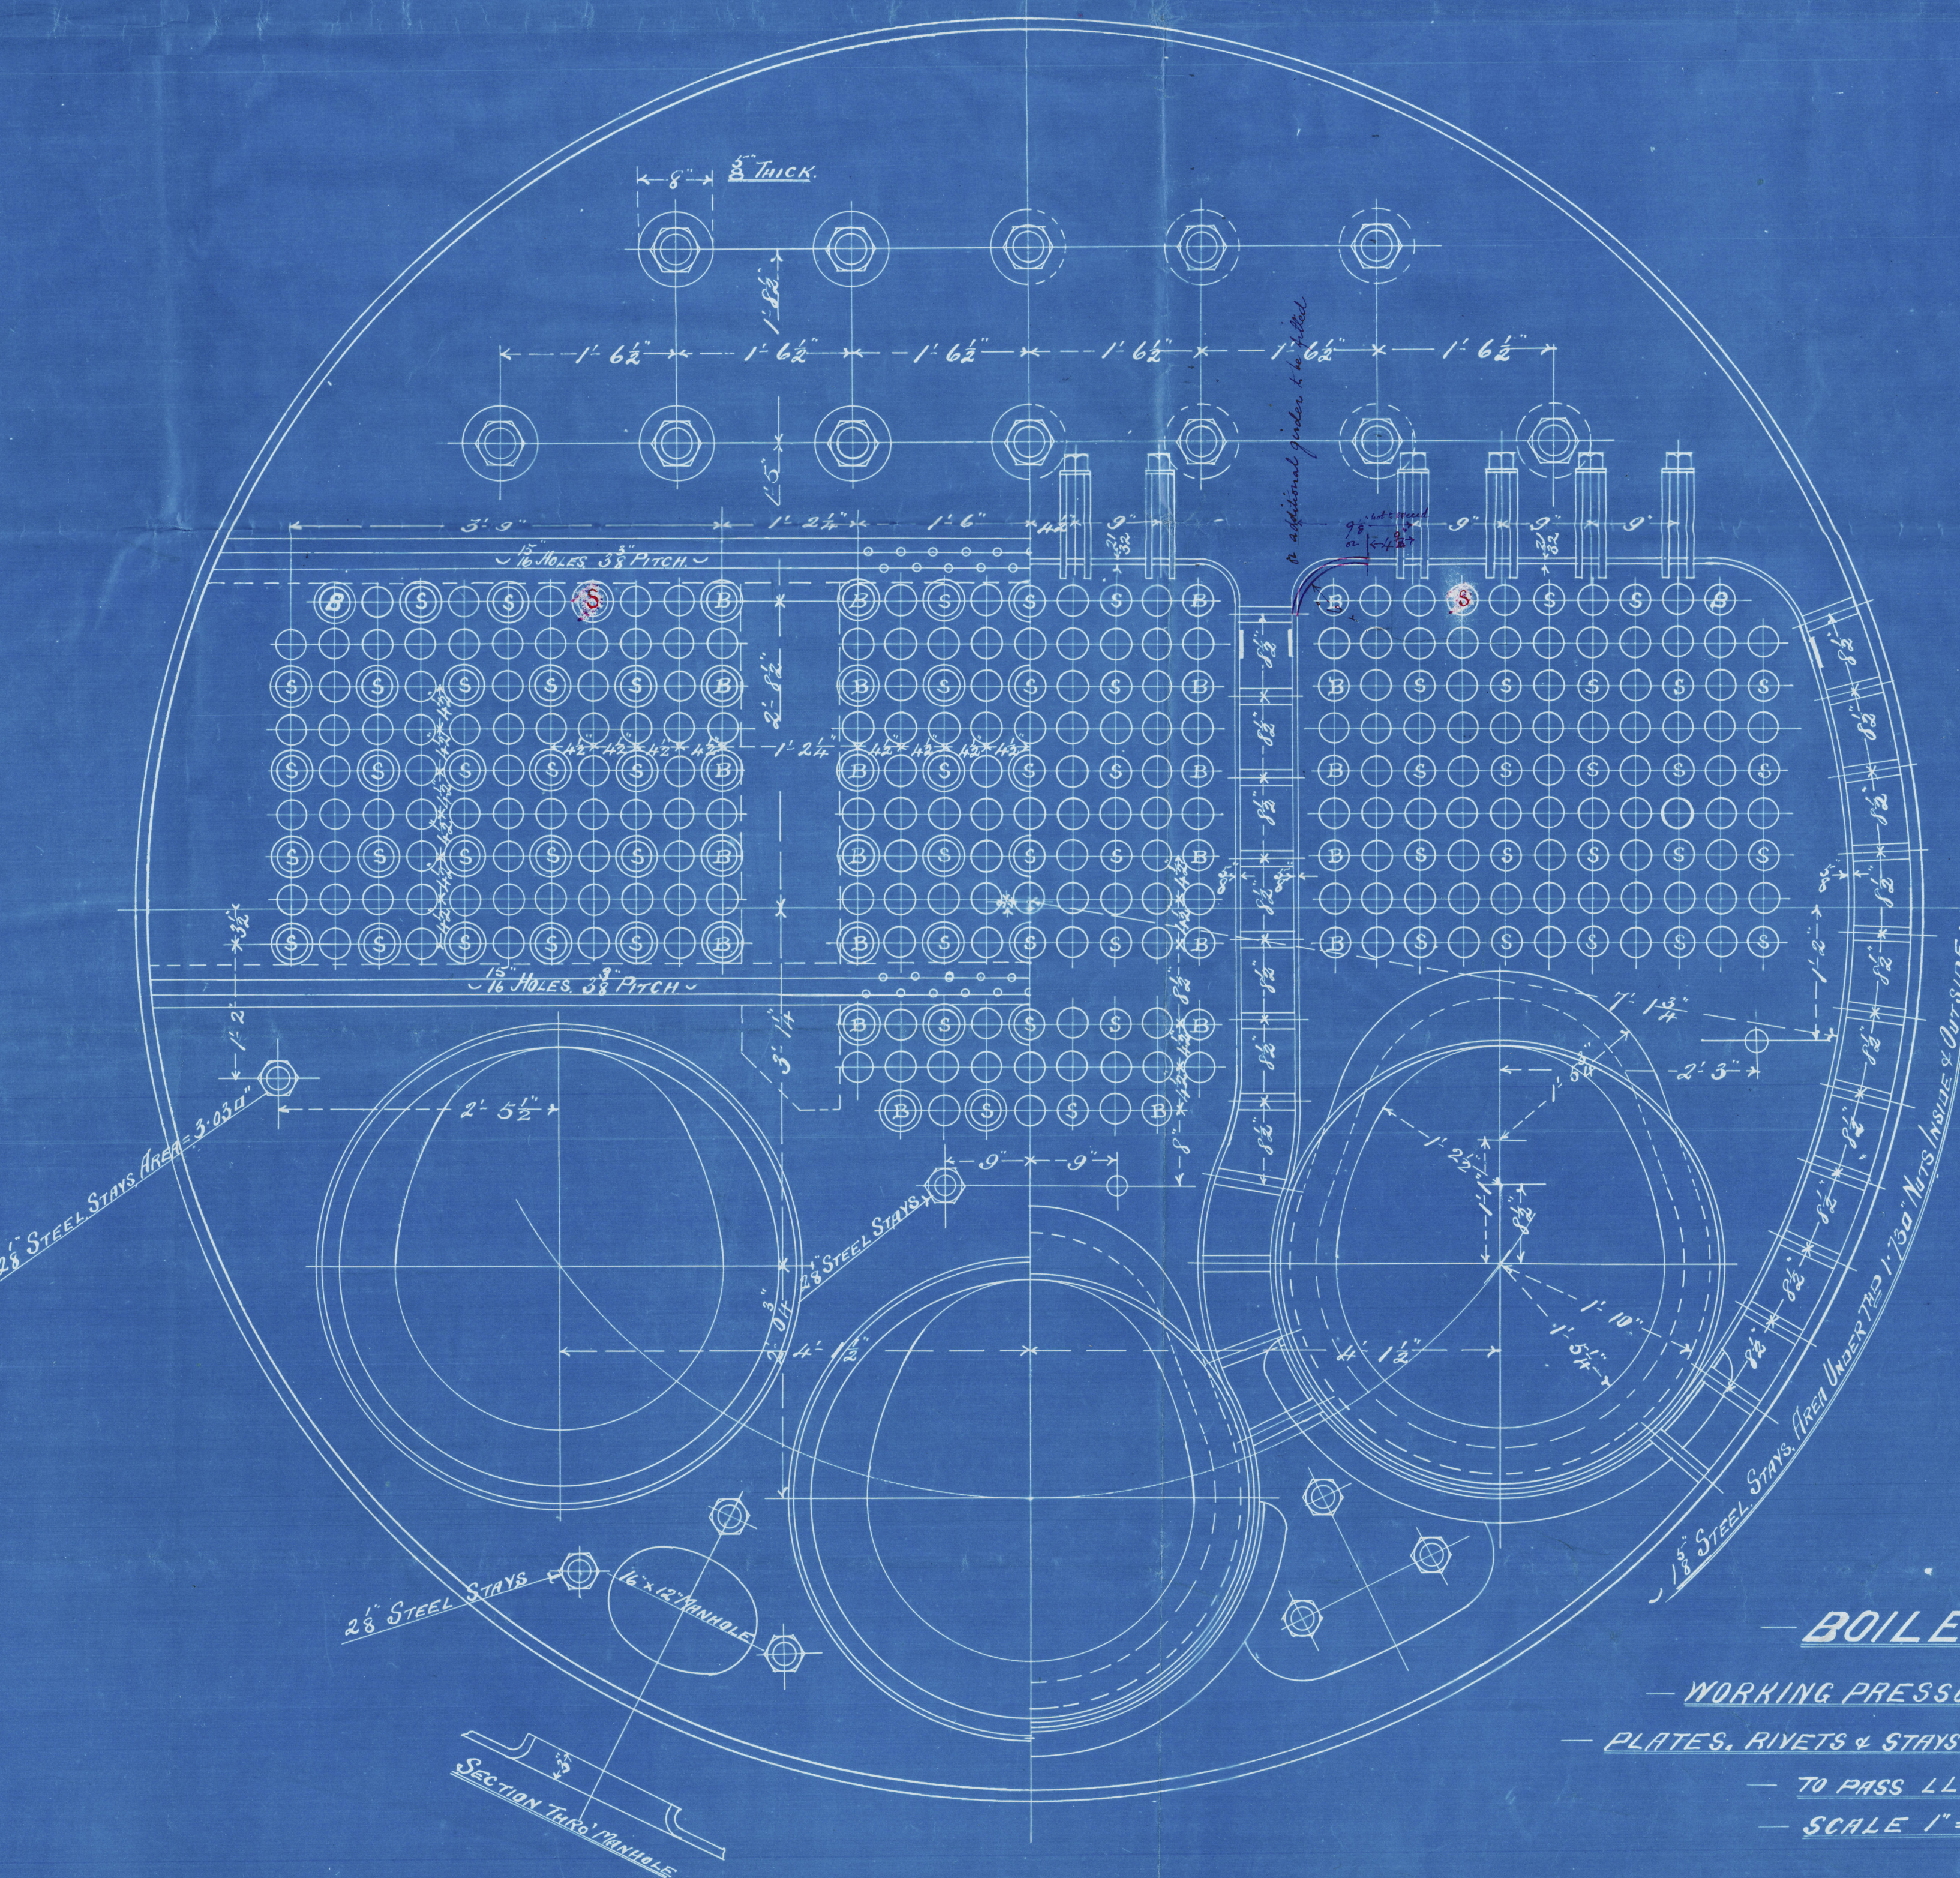
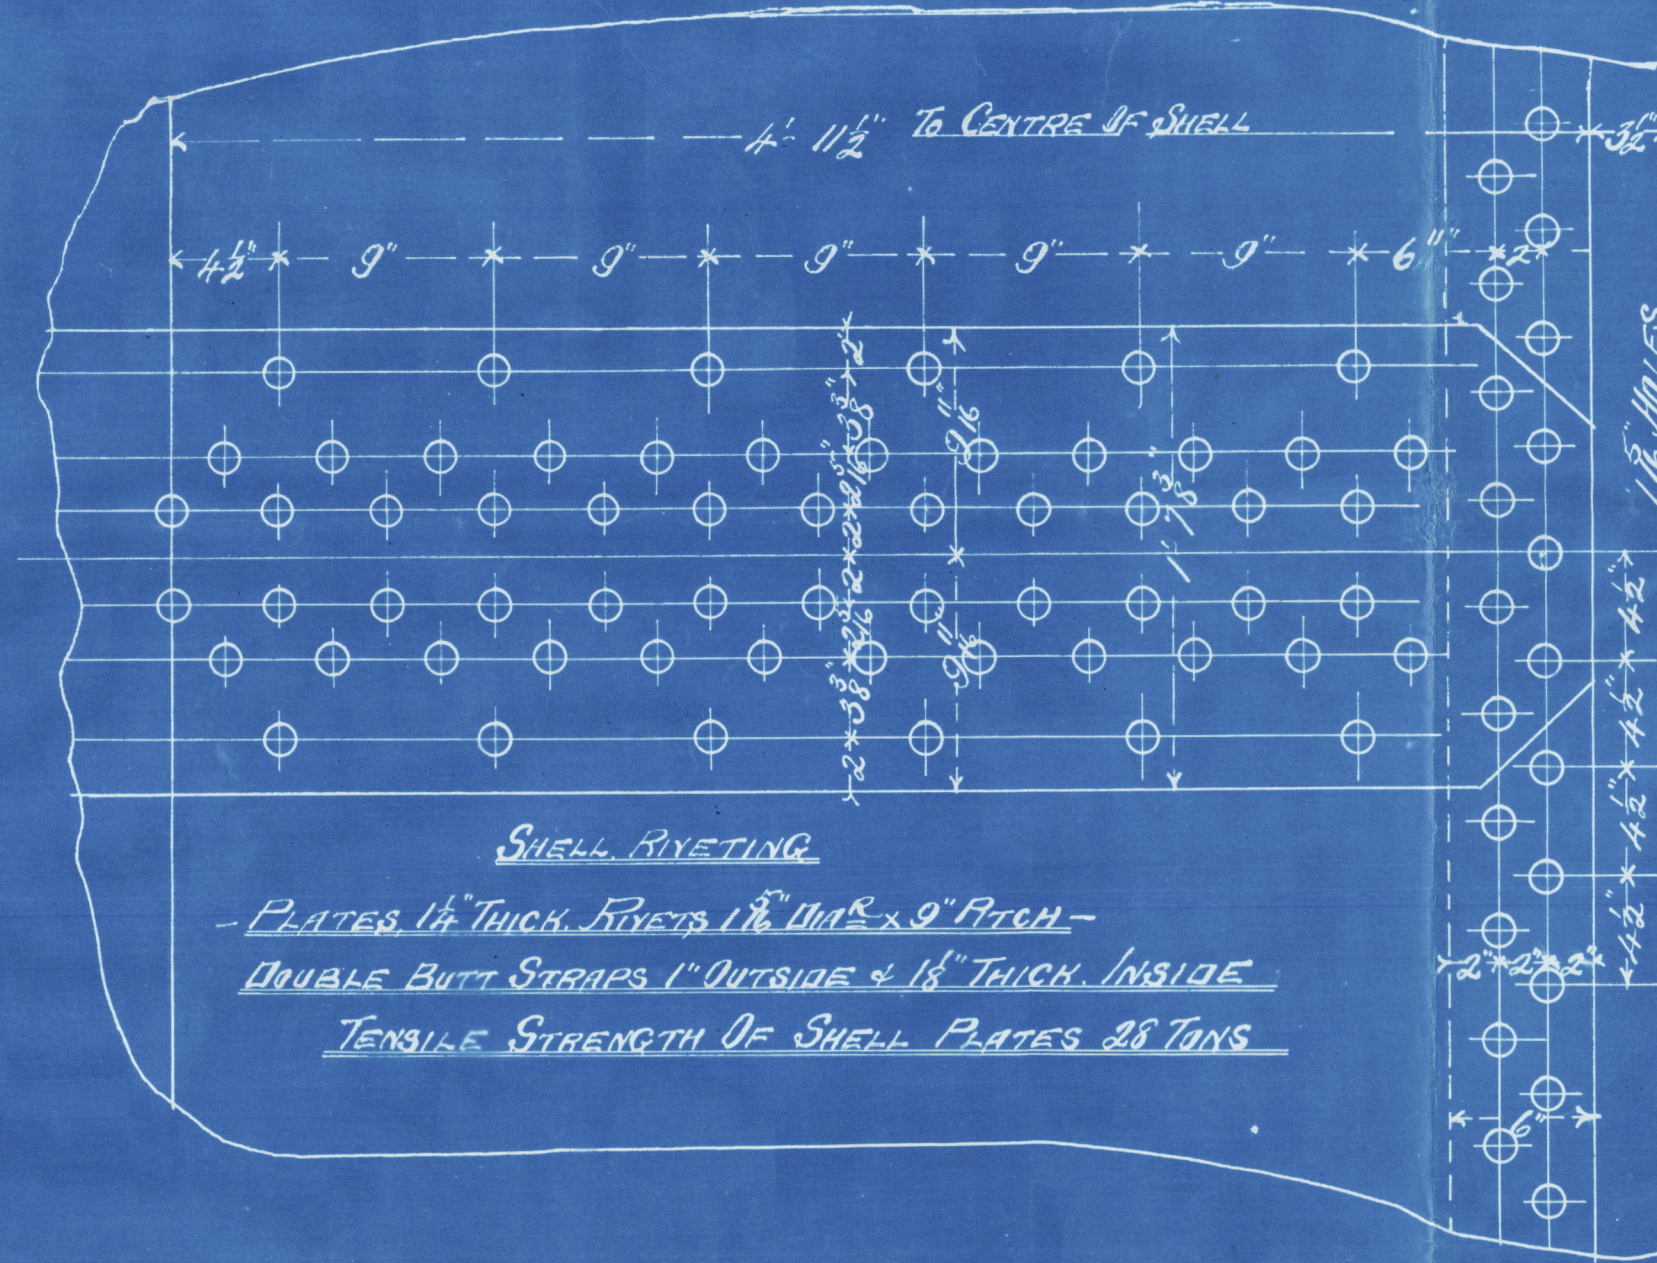
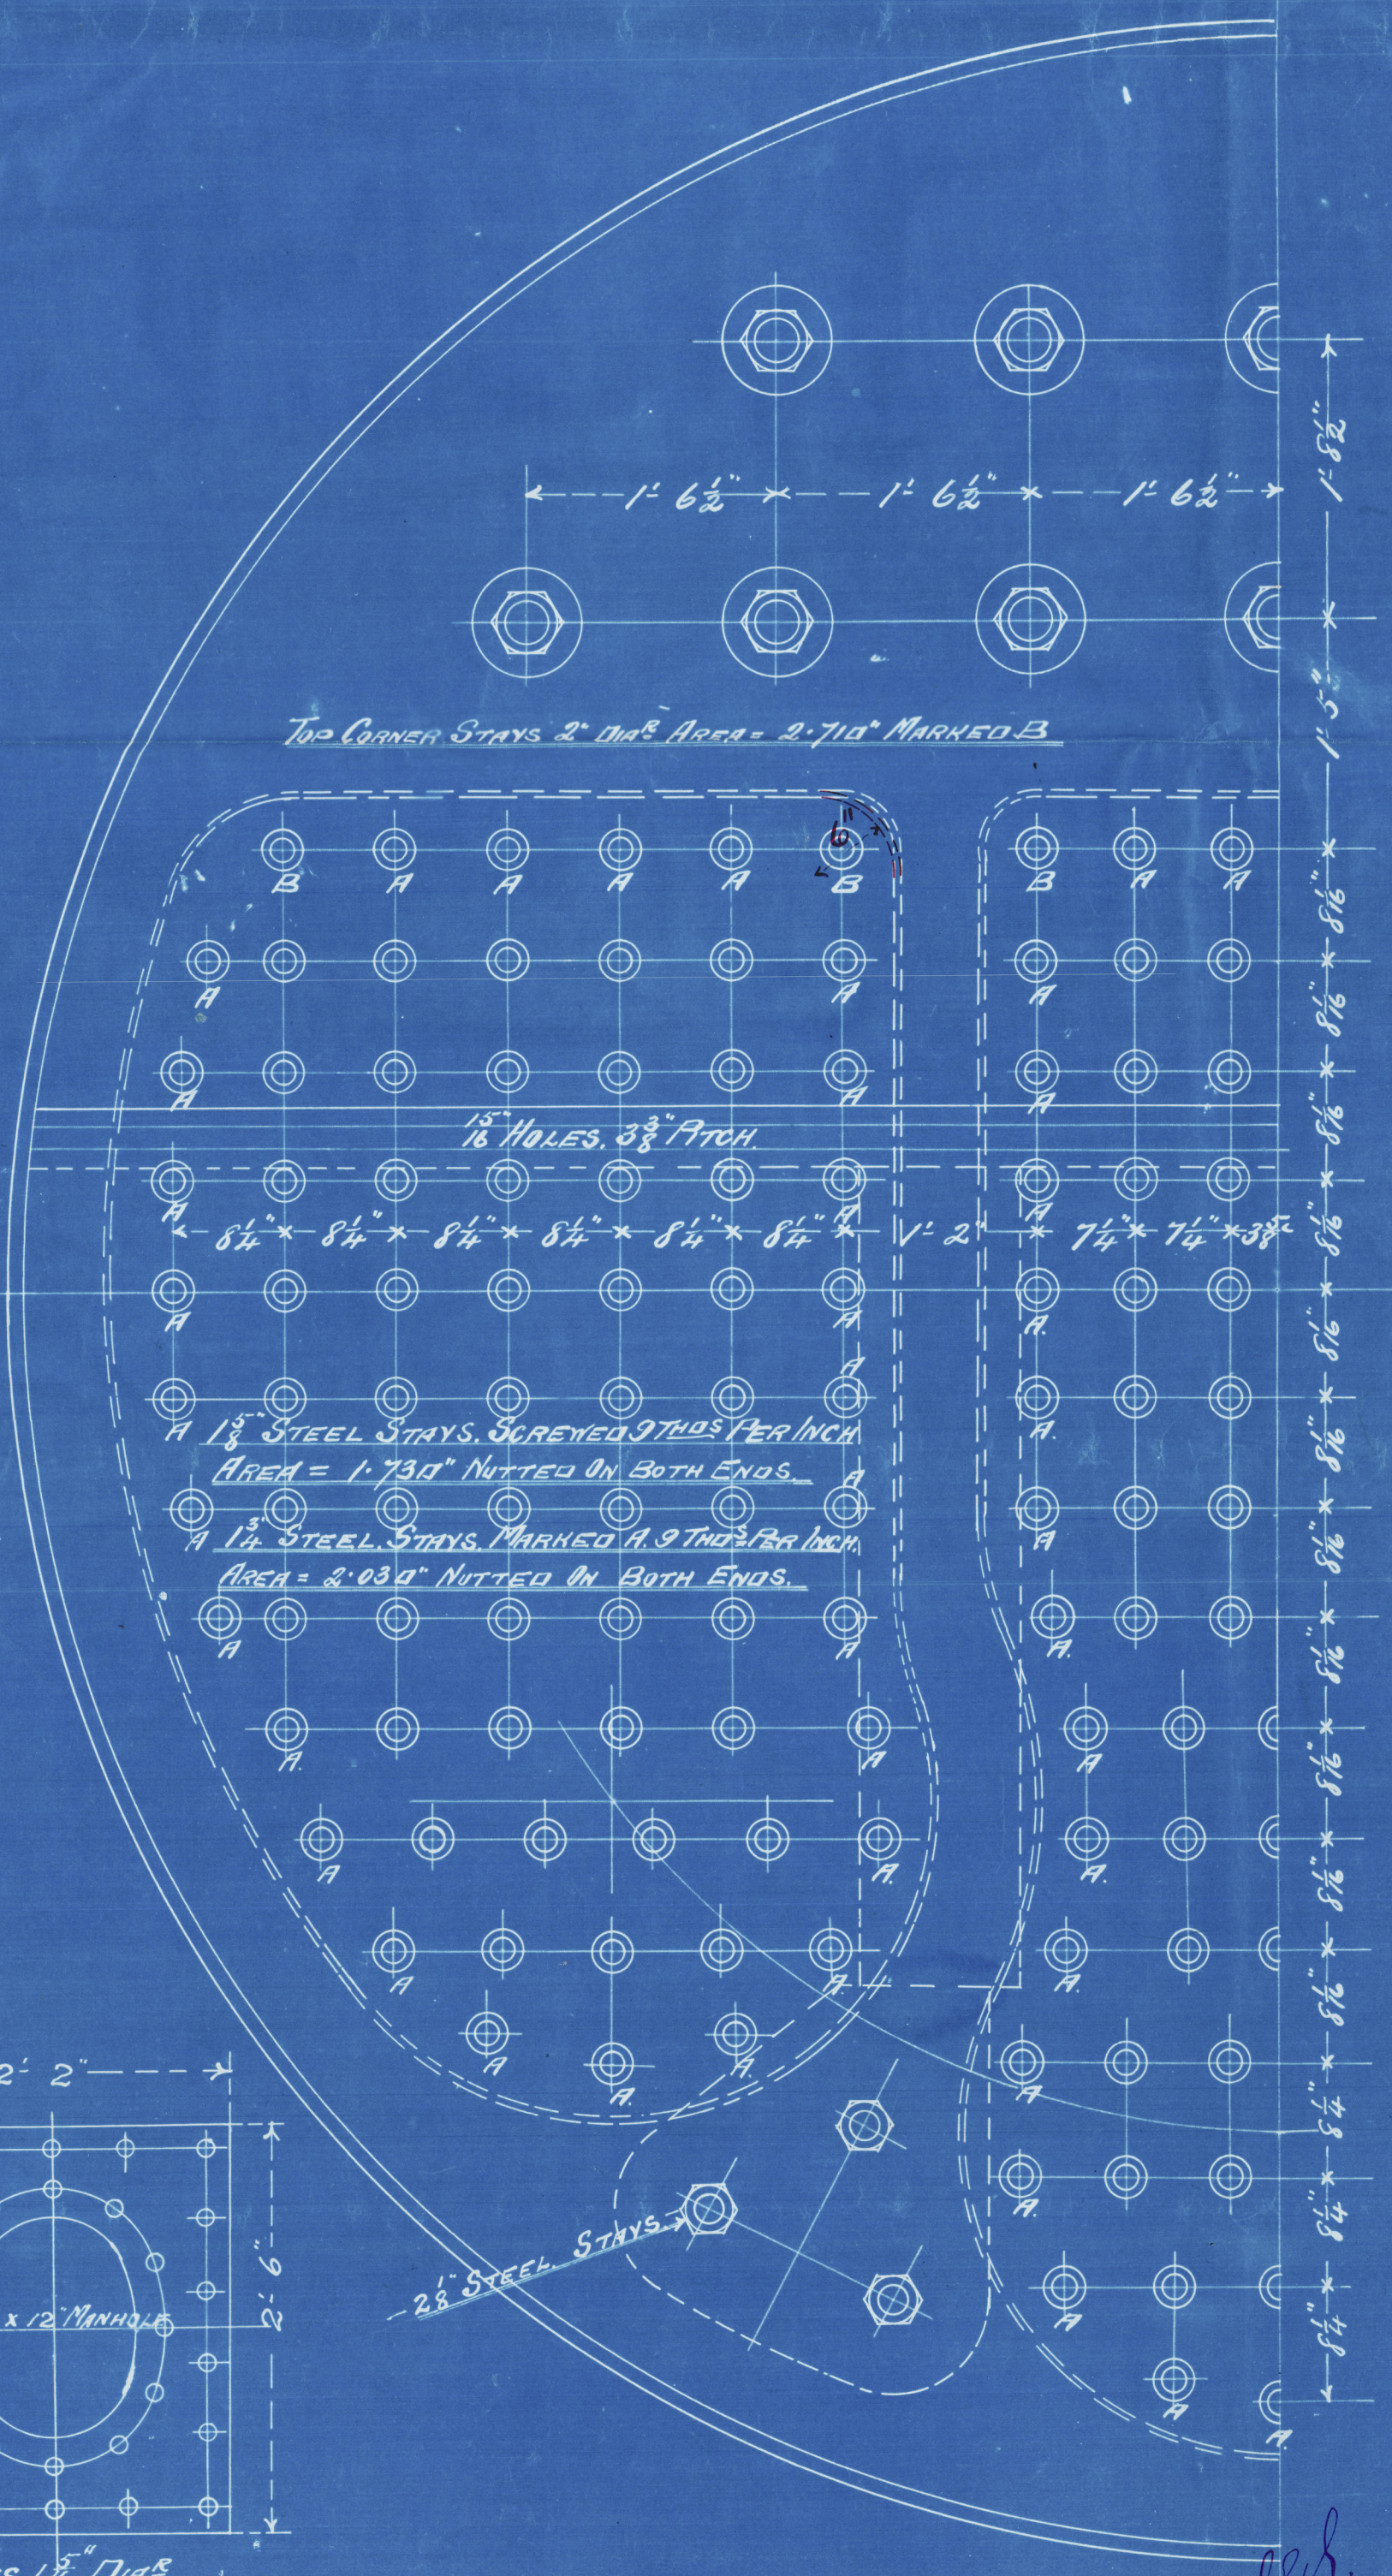


24 1.00

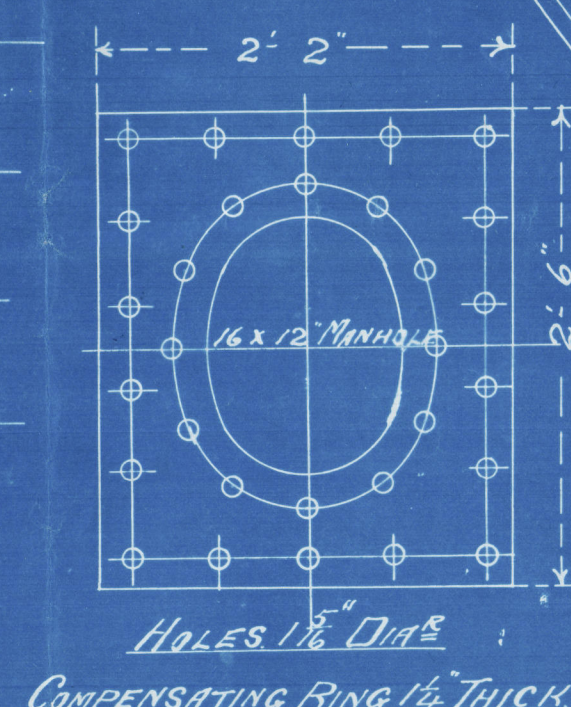

BOILER, N^o 407-8
 WORKING PRESSURE 100 LBS PER SQ. INCH
 PLATES, RIVETS & STAYS OF STEEL TUBES OF IRON
 TO PASS LLOYD'S SURVEY
 SCALE 1" = 1 FOOT

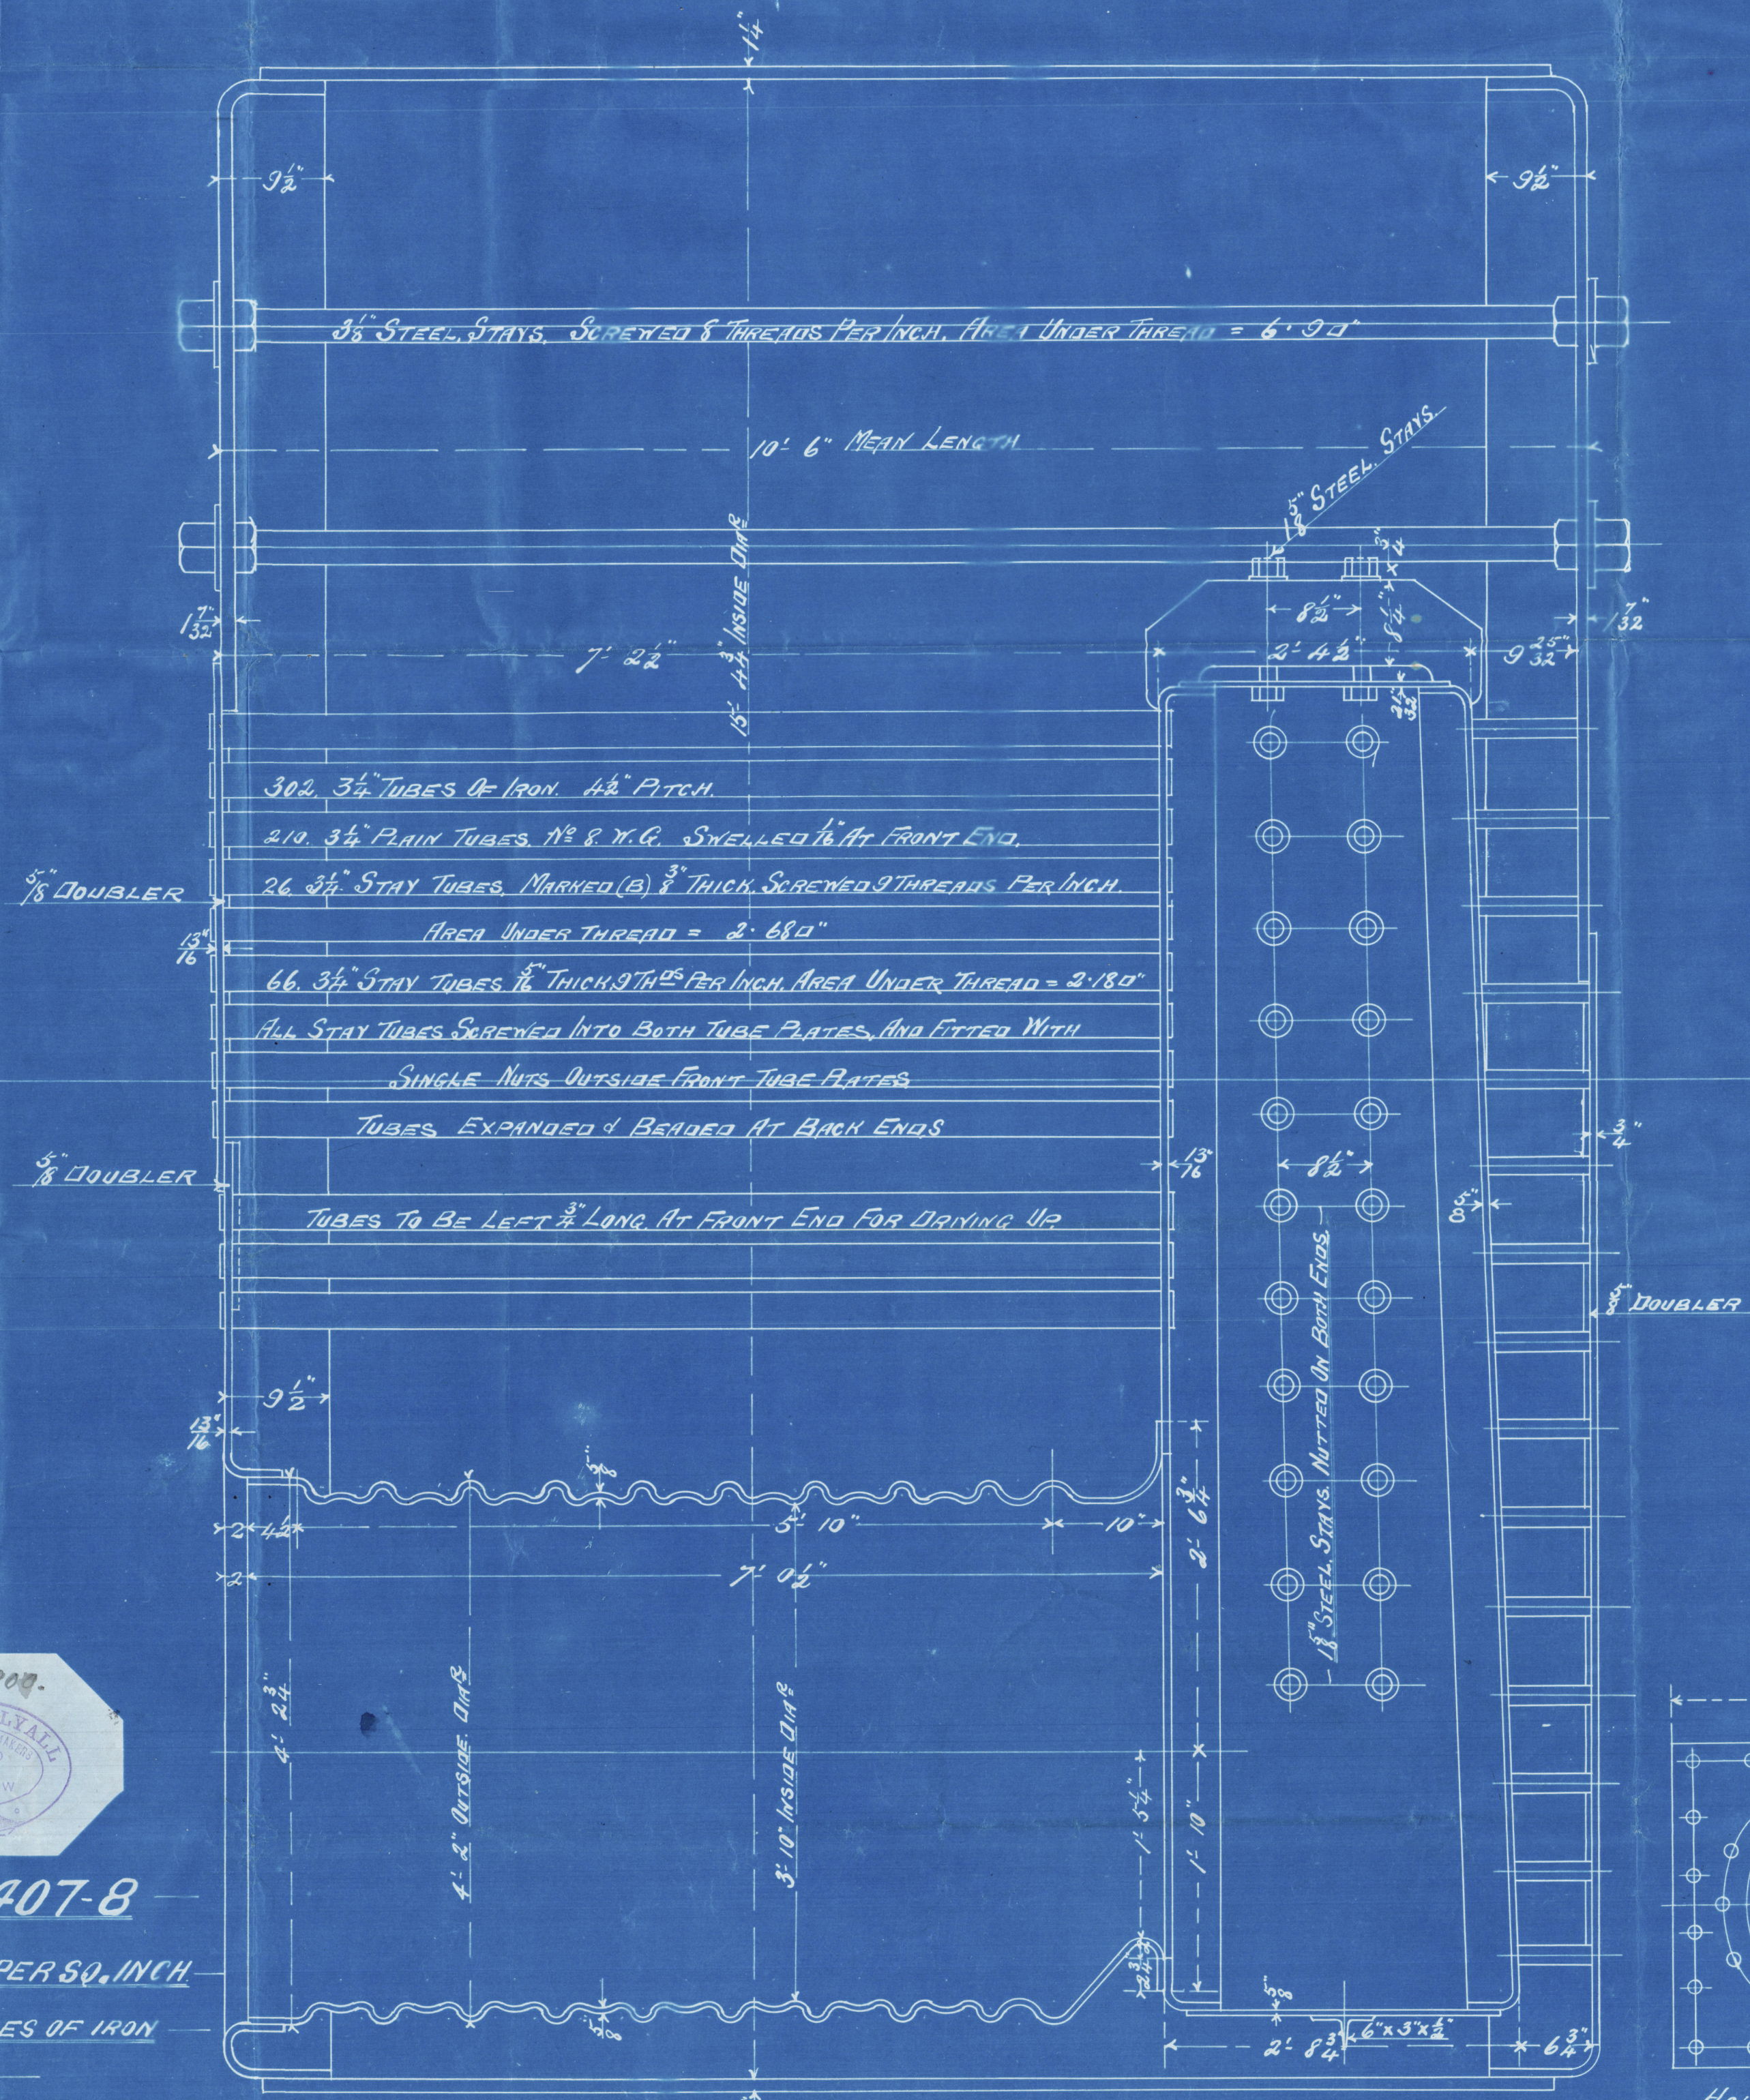

Mami Boileis
by

Anderson Ryall.

for
Russell 1650 N° 476 41





J. H. Kneads N° 296 Supra

S. S. "Arciduca" "Mofano"

180 Hs "Working pressure"

Glo rpt N° 18852

Glo report N° 13075-
Tested 11/11/1901

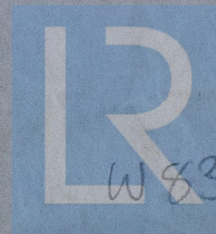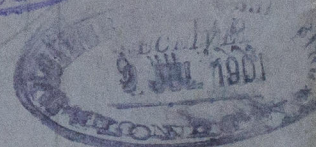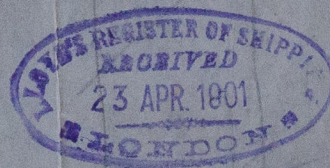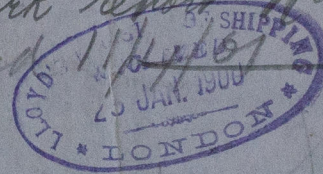

© 2020

Lloyd's Register
Foundation

RETAIN