

6.6.00


LONGITUDINAL & DECK PLANS.

S.S. No. 476

Scale 1" = 10'




Fore + main masts, 2 planks in the round. Butts lapped + 5" above Deck, 2" below Deck. Stems lapped + single riveted.

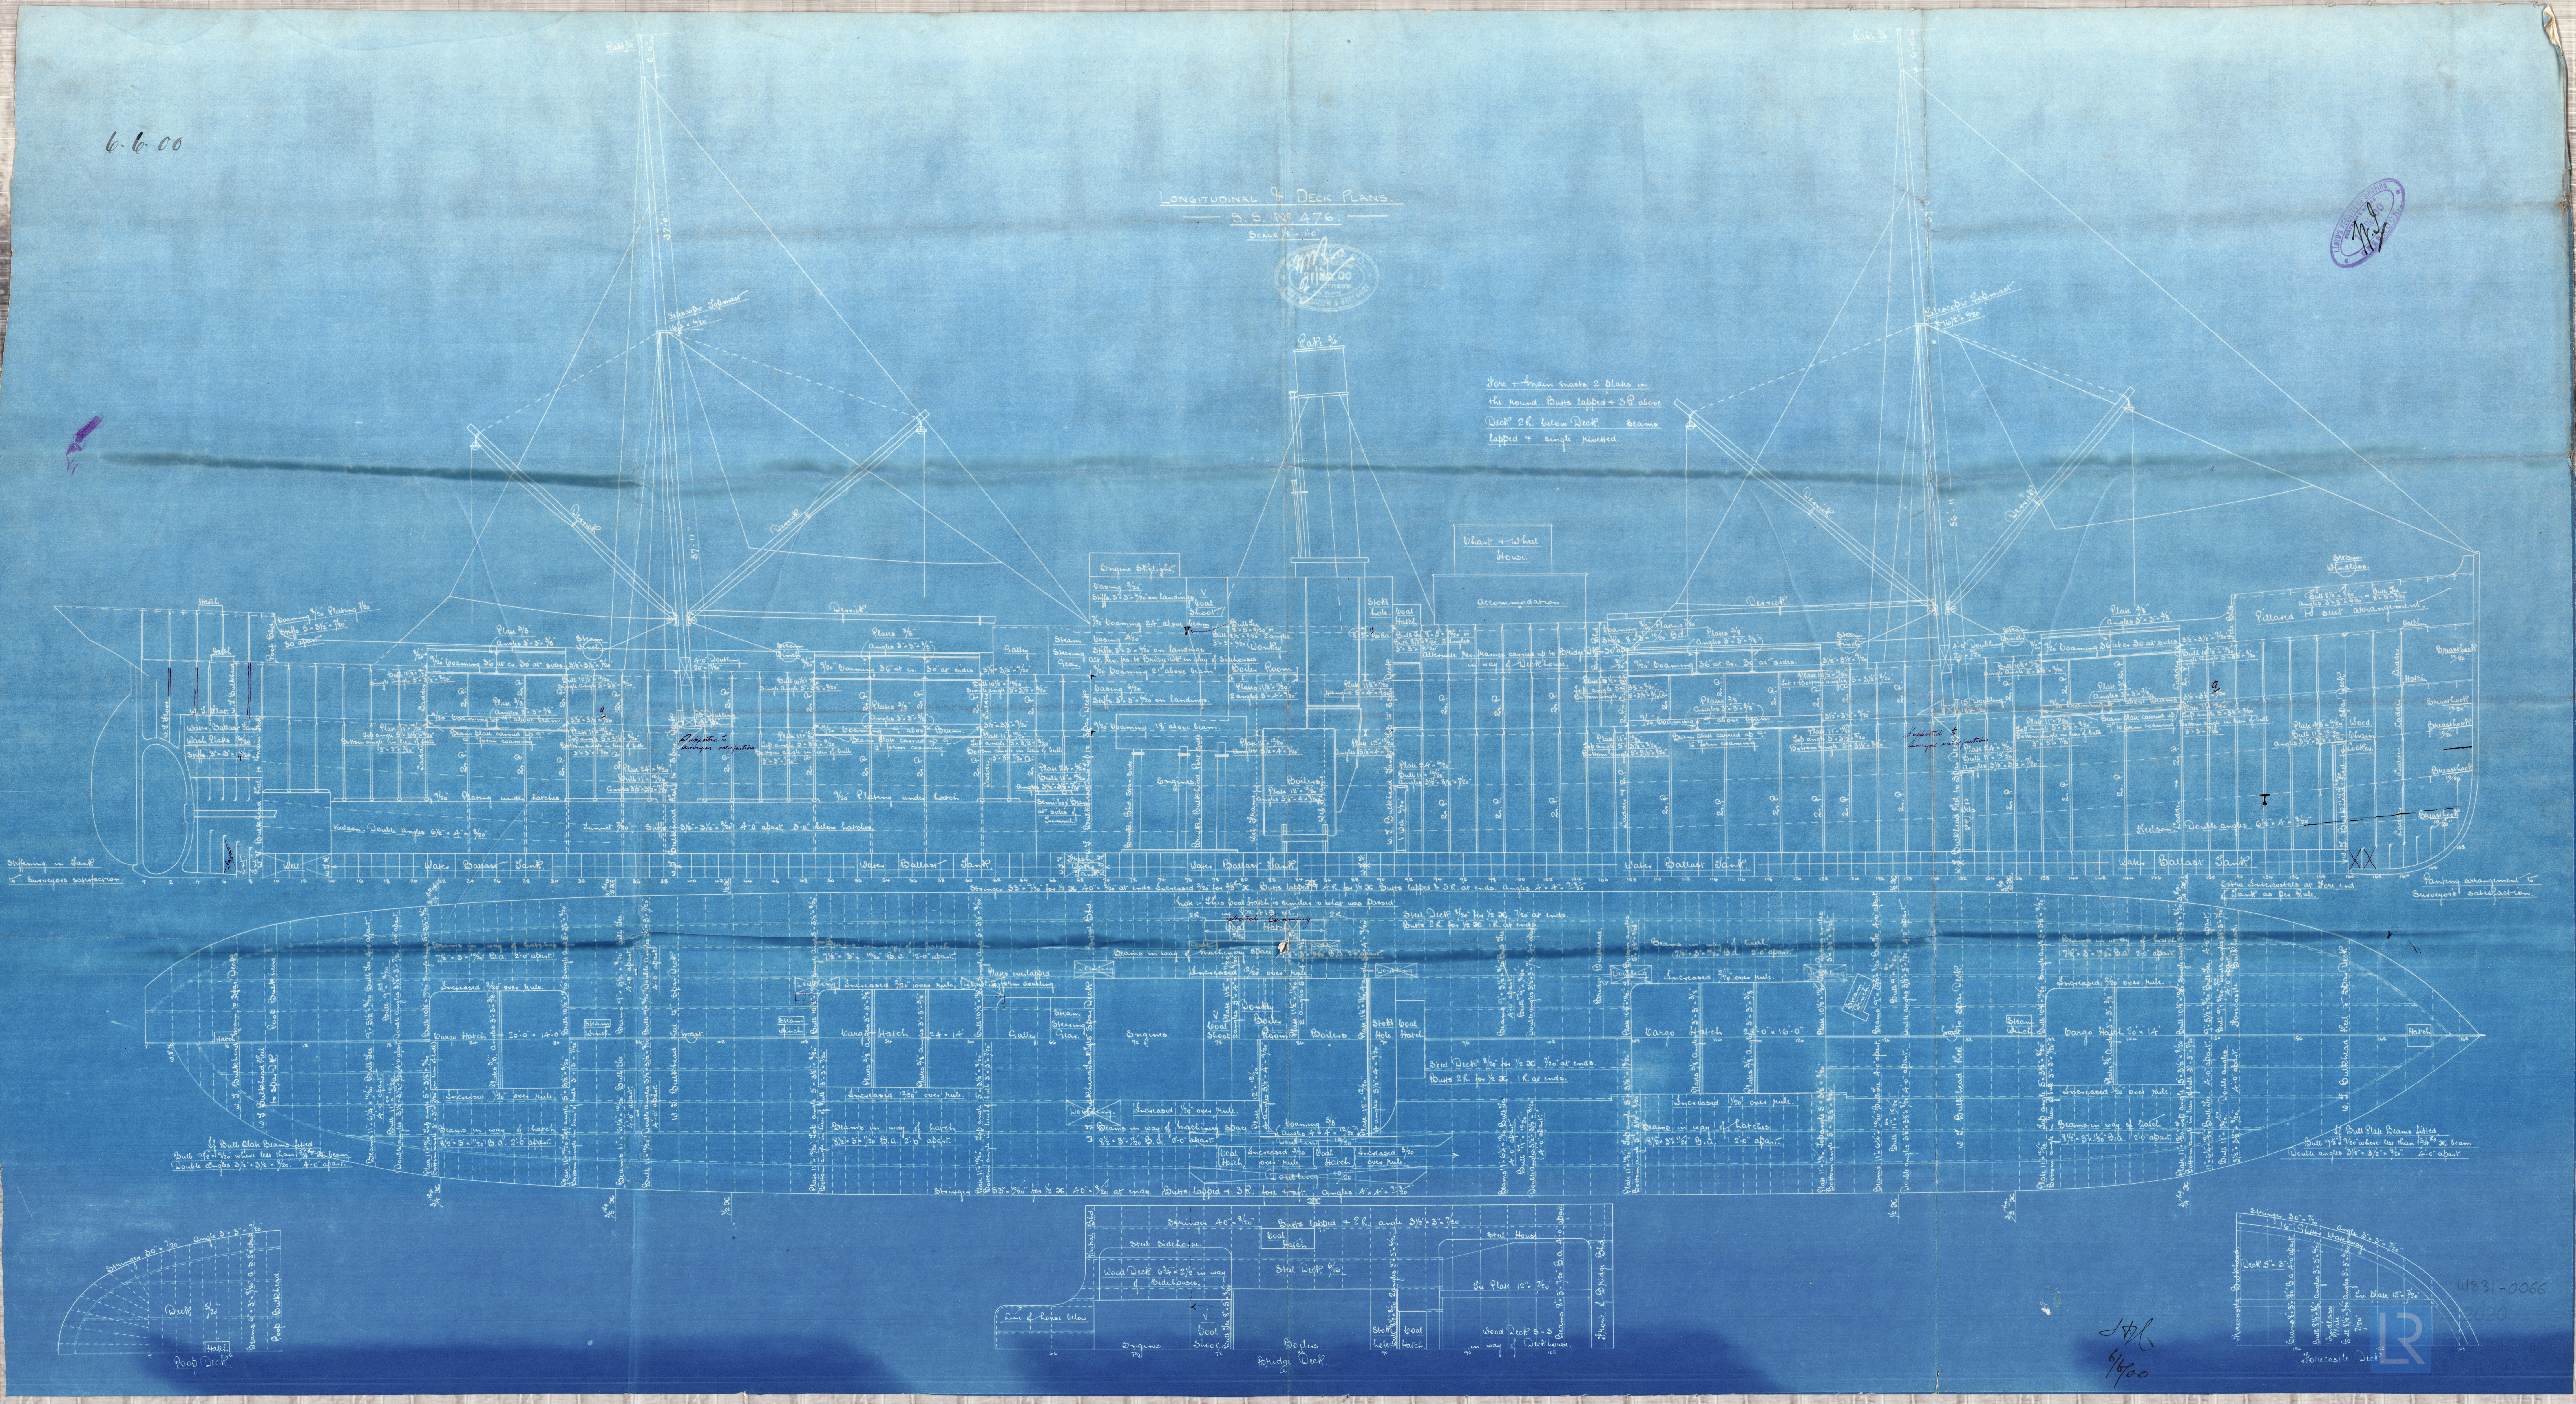


W831-0066

2020

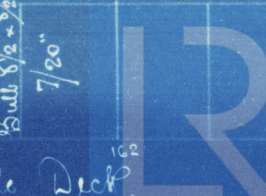

Longitudinal & Deck Plan

Russell No. 476

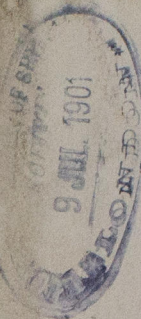

LONGITUDINAL & DECK
PLANS.


S.S. 476.

LLOYD'S.

S.S. Arciduca Stefano
Grk report No 13075



RETAIN

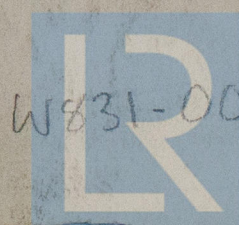

© 2020

W831-0066

Lloyd's Register
Foundation

1/1
23/3



© 2020

Lloyd's Register
Foundation