

TO CLASS 100 A.I. \boxtimes SPAR DECK RULE.

SCALE $\frac{1}{2}" = 1$ FOOT

6.6.00

1/9/98

12.1


Midship Section

Russell & Co No 476
S.S. "Arciduca Stefano"
Grk report No 13075


MIDSHIP SECTION.

S. S. No 476.

LLOYD'S.

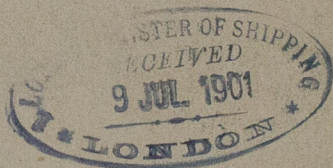

RETAIN

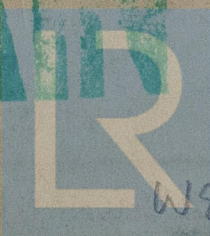

© 2020

Lloyd's Register
Foundation

W831-0067