

Particulars for Subboard (approx Dimensions)
 Required Length ----- 220'-0"
 Breadth ----- 35'-0"
 Depth ----- 14'-06"
 Approximate Under Deck Lonnage ----- 820 Tons.

PROPOSED MIDSHIP SECTION

OF STEEL SCREW STEAMER
 TO CLASS 100 A1 AT LLOYDS


PRINCIPAL DIMENSIONS
 LENGTH BP ----- 220'-0"
 BREADTH MOULDED ----- 34'-10"
 DEPTH MOULDED ----- 16'-2"

SCALE 1/2" = 1 FOOT

Equipment Number 15/58-19
 2 Bower anchors (Stockless) 26 1/2 cwt } 4 1/2 cwt
 1 Stream anchor (Ex Stock) 7 1/2 cwt
 1 Rege " " 3 1/2 "
 210 fathoms of 1 1/16" Stud Chain Cable
 7/8 " " 1 1/16" Stream Chain 3 1/2" steel wire
 90 " " 10" hemp or 3 1/4" steel wire
 90 " " 6" Warp
 90 " " 5" Warp

9.03
 9.03

Length of Raised Quarter Deck 48'-4" Bridge Deck 49'-10" Forecastle Deck 24'-10"
 Bridge Front Stiffened as per detail sketch, framing Port Area as per rule with 25% extra as required

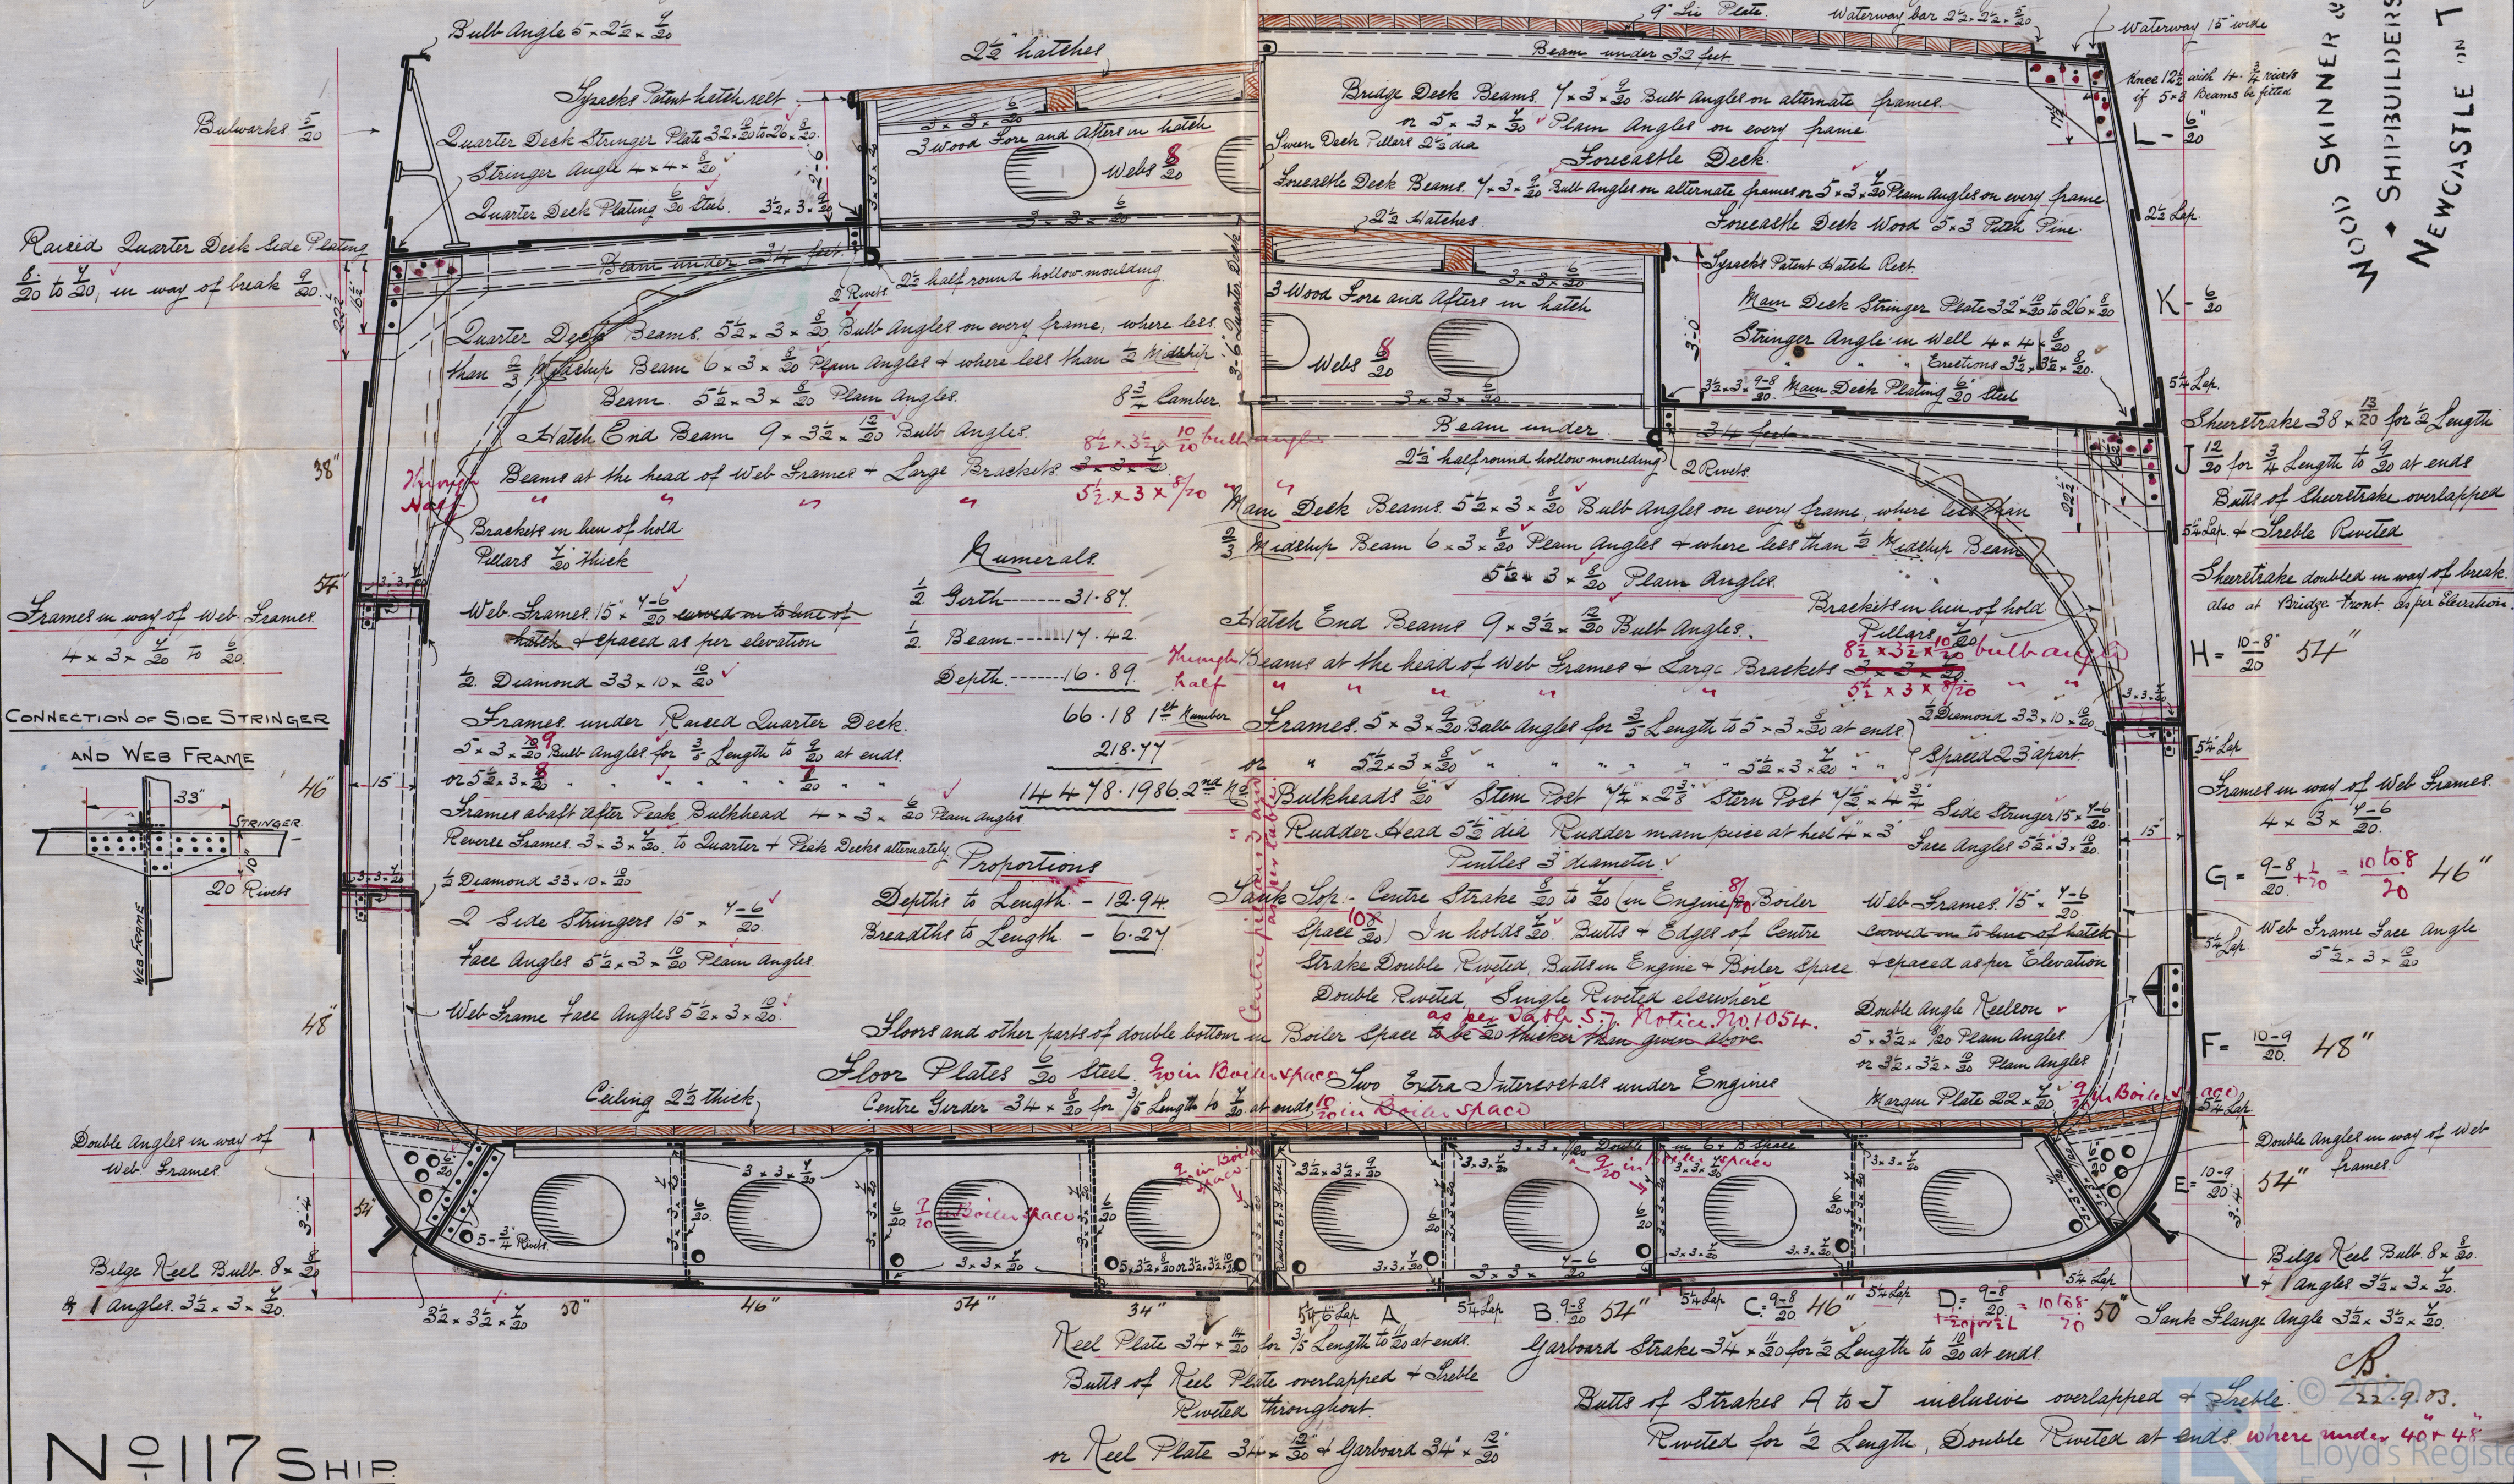

Nº 117 SHIP

New Wood Skinner to

S.S. 10117

Midship Section

S.S.
Lucy Andersen

N. No. 46768.



© 2020

Lloyd's Register
Foundation