

Dr. 03
1:12:03

PROPOSED SUCTION PLAN.

UNDER DECK TONNAGE. Approx. 820 TONS.


LENGTH 220'-0" B. 34'-10" D 16'-2"

Nº 117 SHIP

Scale 1/8 inch = one foot

NOTE: DOWNTON FLYWHEEL PUMP FITTED IN ENGINE ROOM.
IN LIEU OF HAND PUMPS IN HOLDS. *to be of a suitable size*

Bilge injection, Rule size, to be fitted.
2 1/2" SEPARATE DONKEY SUCTION

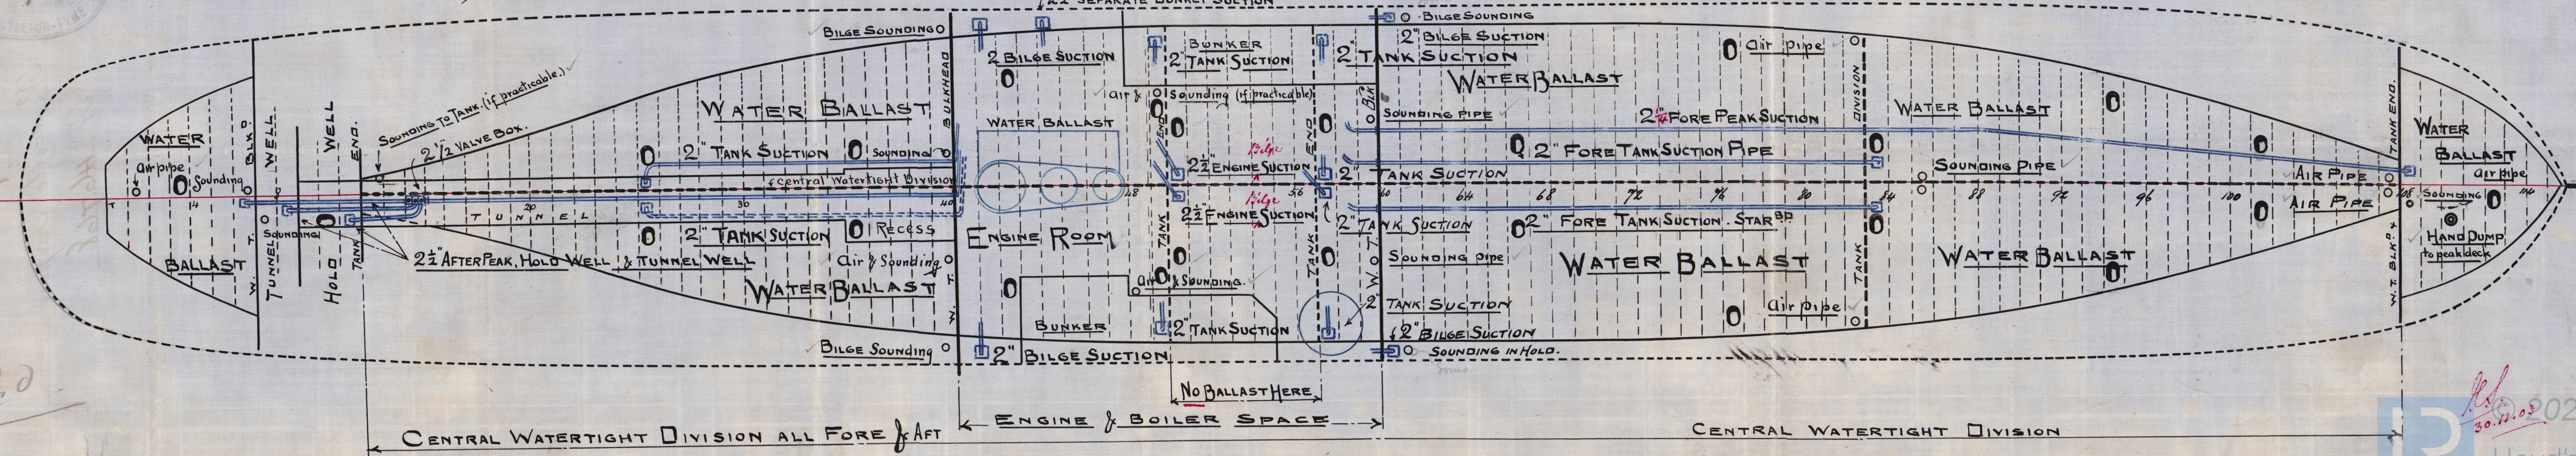

Newcastle-on-Tyne

Messrs Wood, Skinner's


No. 117

Pumping Plan

S. P. Lucy Andersen

Newcastle Report


No 146.768

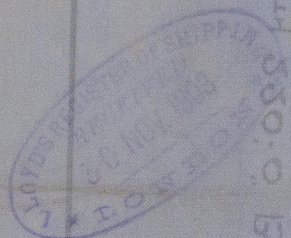

1:15.00
1:15.00

Scale 8 inch = one foot

PRO

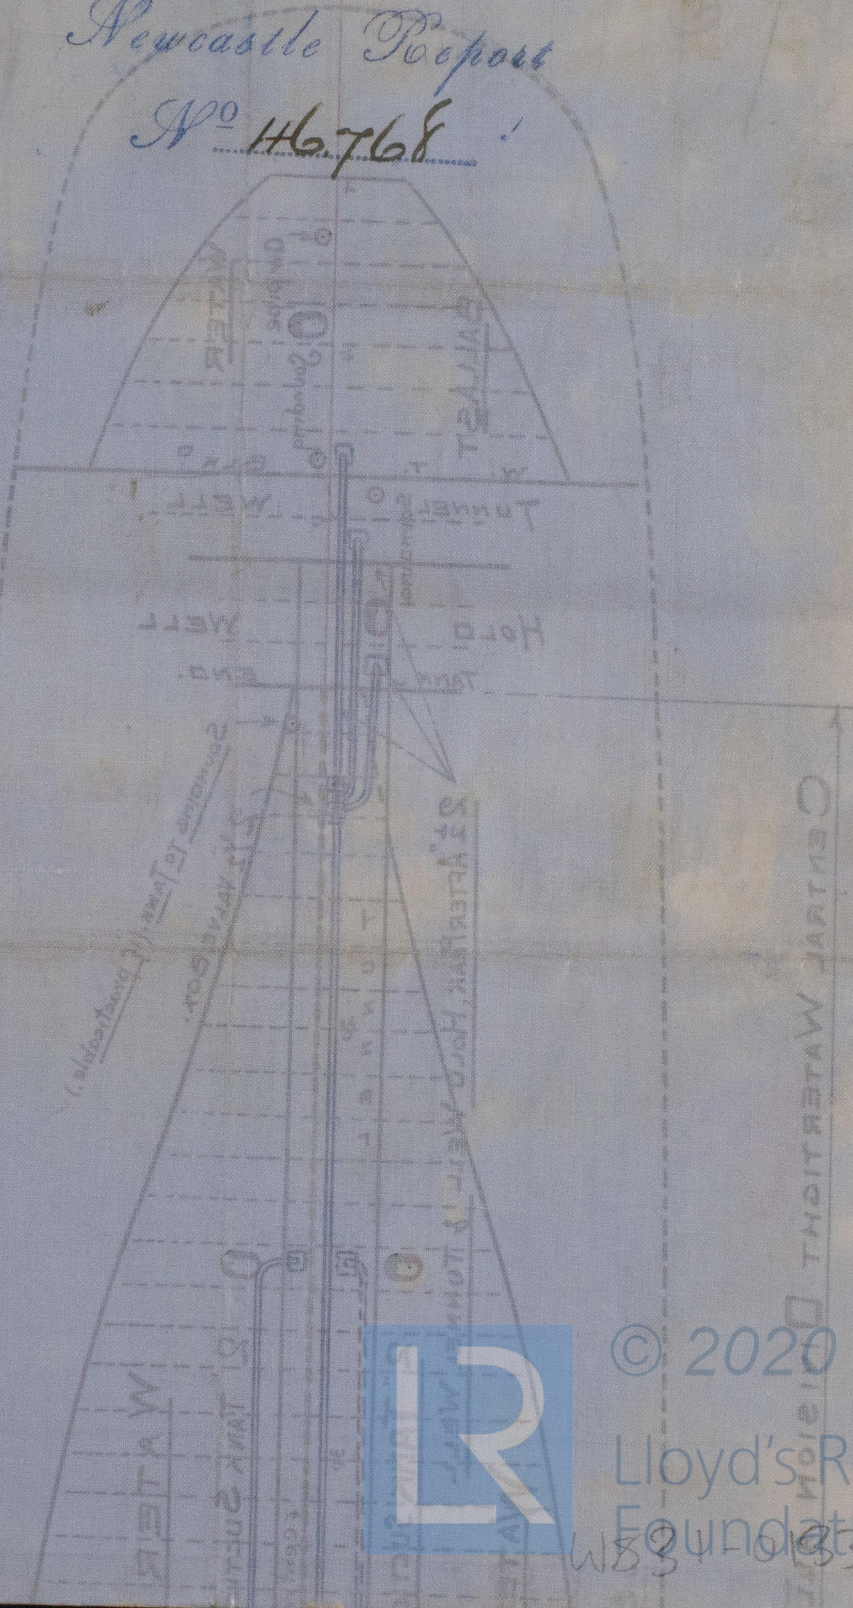

© 2020

Lloyd's Register
Foundation

W83 0133