


SCREW STEAMERS

N^{os} 200, 201 & 202, 203.

SCALE $\frac{1}{2}$ = 1 FOOT

also N^{os} 204, 205, 206, 207
appd. 18.10.05

21.8.05
28.8.05
2.9.05
18.10.05 (N^{os} 204, 205, 206, 207)
47, (each figure)

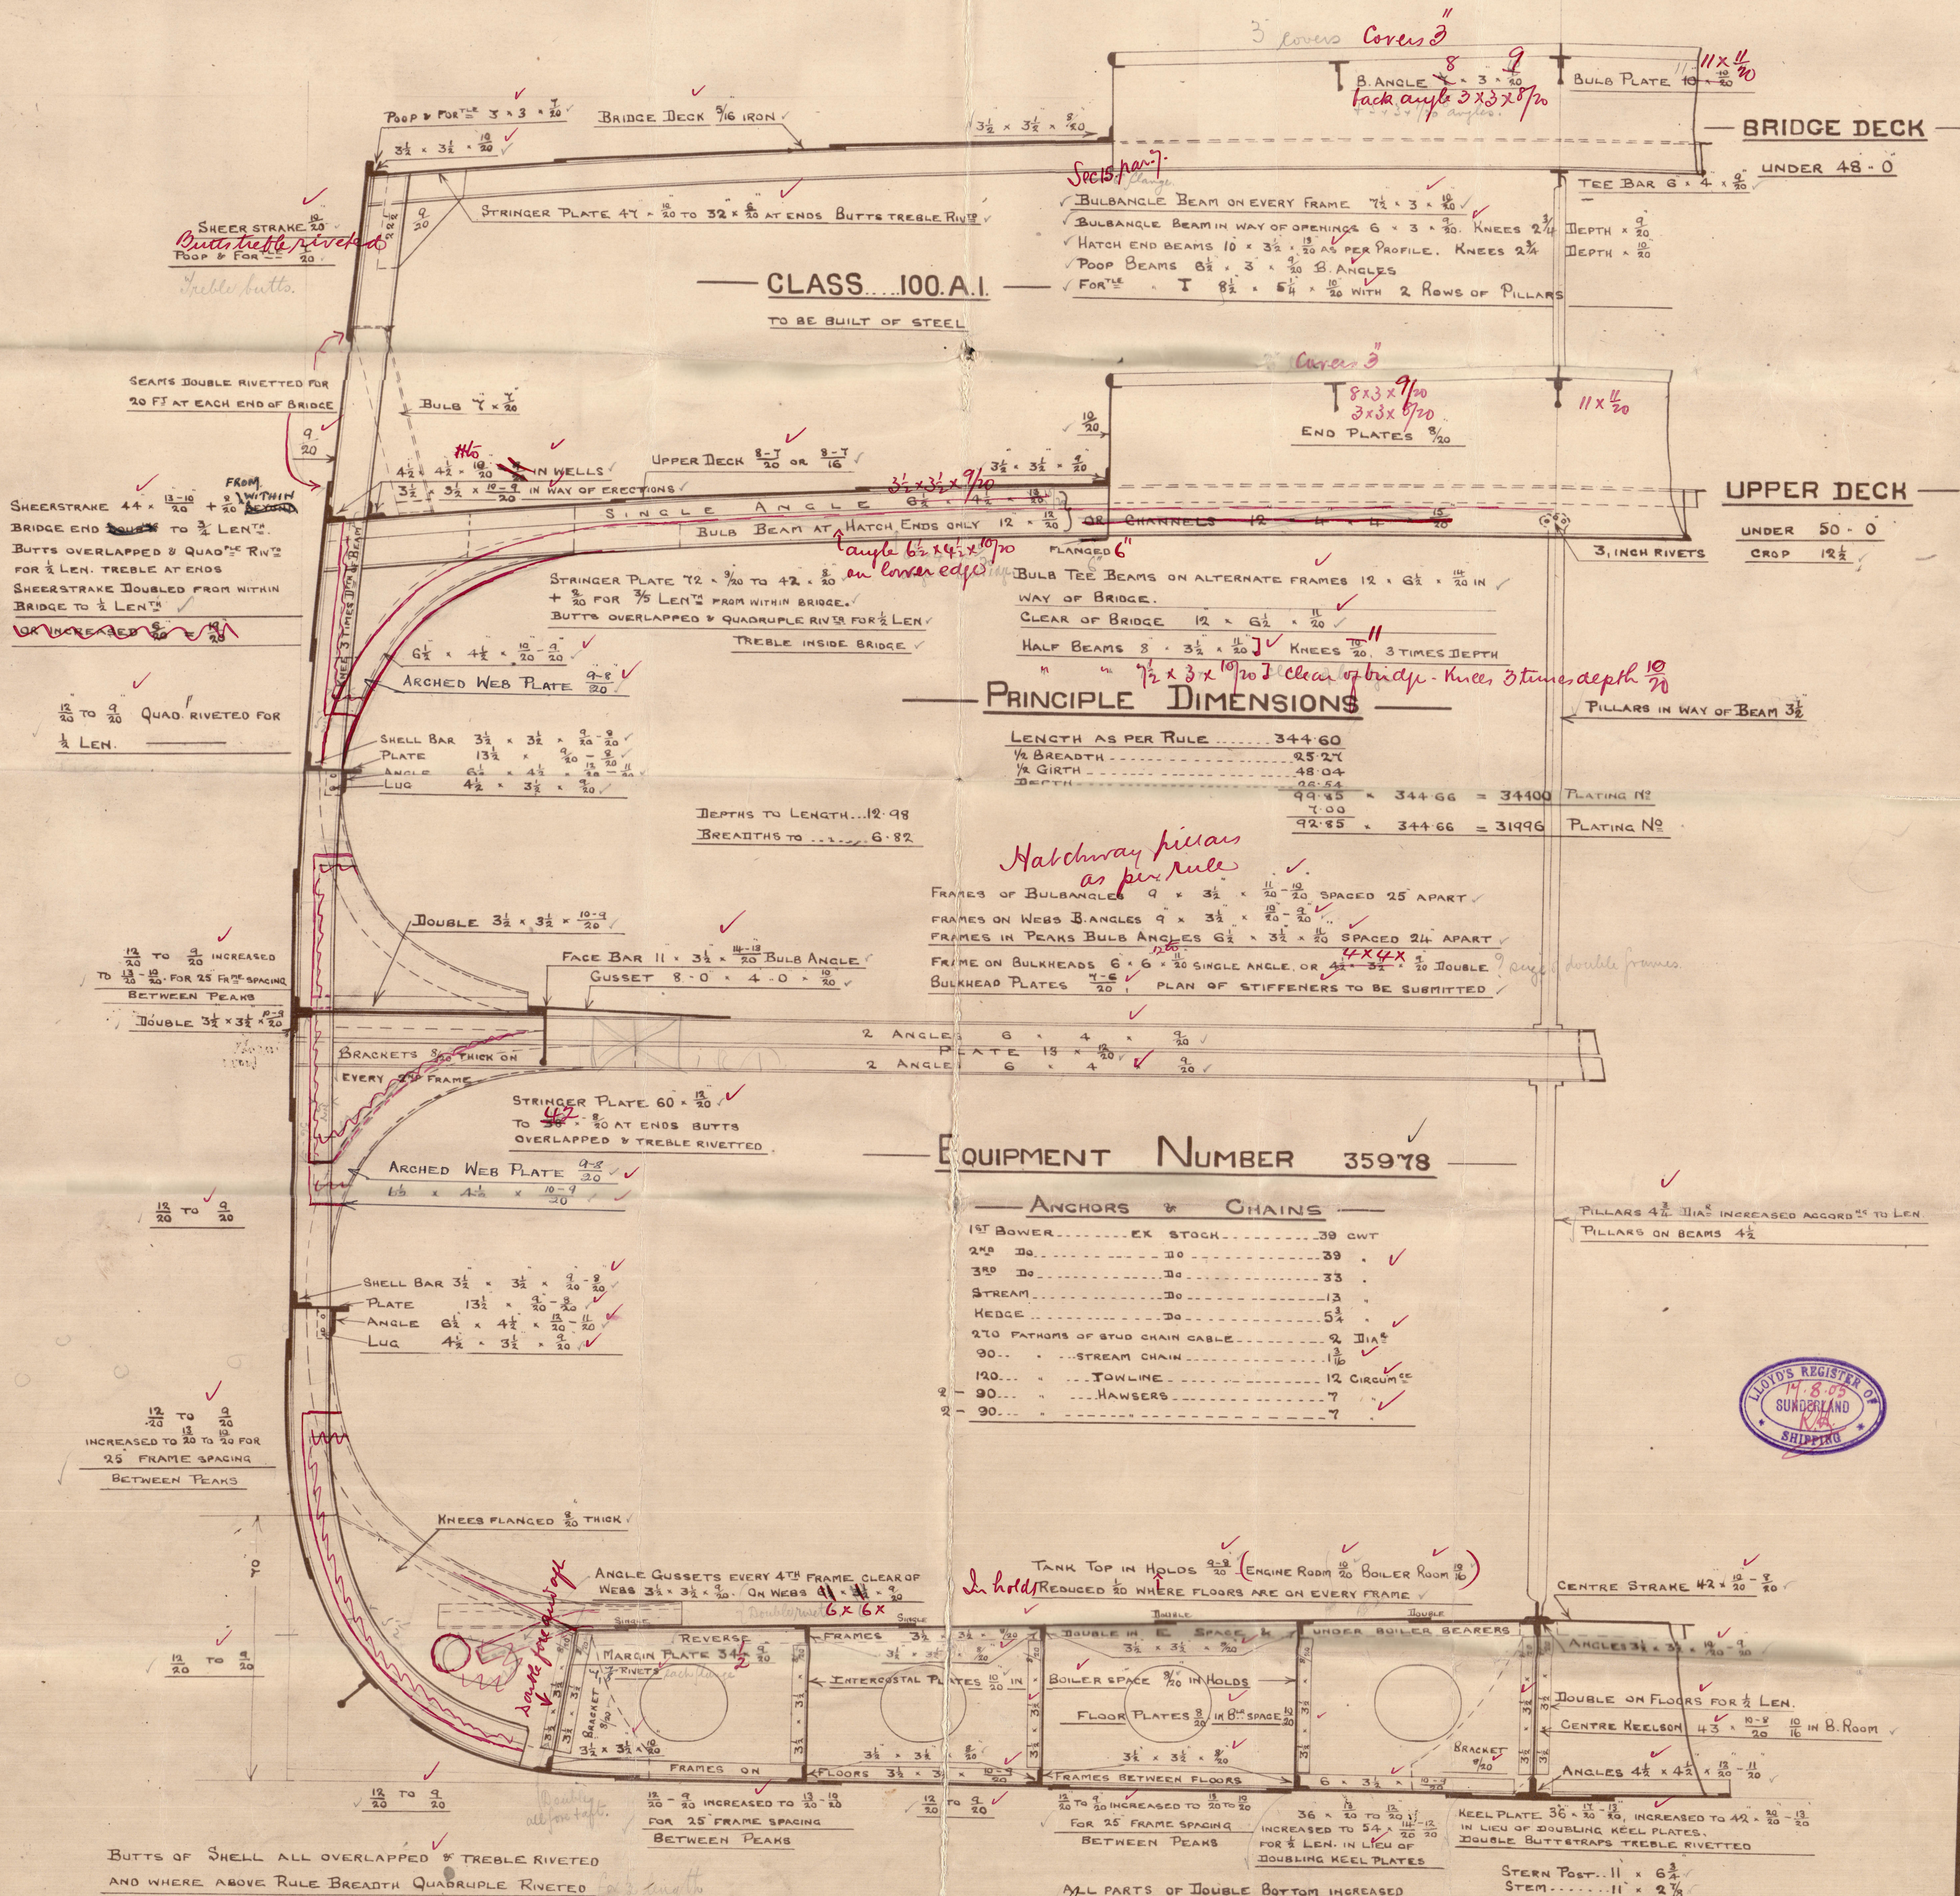

BARTRAM & SONS
SOUTH DOCK
SUNDERLAND



MIDSHIP SECTION.
MESSRS BARTRAM & SONS

Nos 200-1-2-3


204, 205, 207

WB
25T

Ludgate

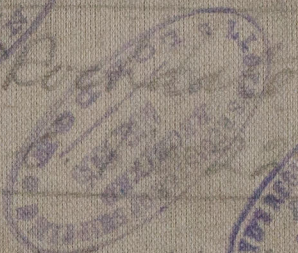
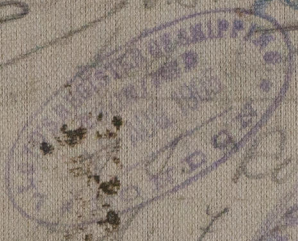


S. S. South
S. S. North

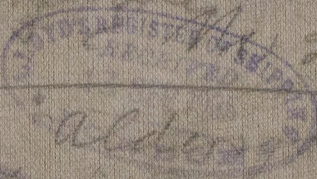


22862

S. S. Alder

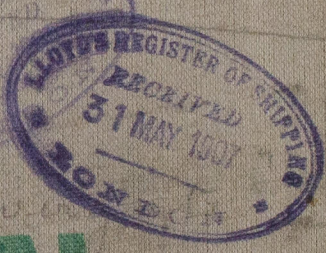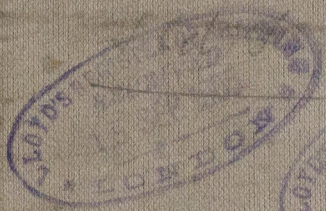

2941

No 204

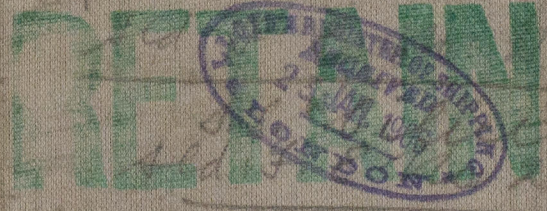

2014

3126

Please return for duplicate

207



207



© 2020

Lloyd's Register
Foundation



S. S. 6 No 25662

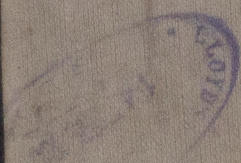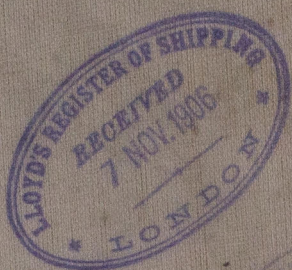

© 2020

Lloyd's Register
WB31.0142
Foundation

Aldersgate 203

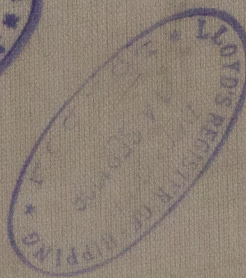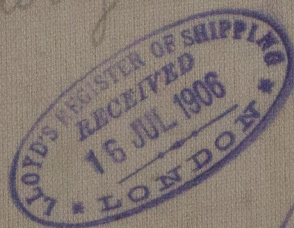

© 2020

Lloyd's Register
Foundation