

— PROFILE & DECK PLAN S. S. Nos: 200, 1, 2, & 3. —

— Scale 1/8" = 1 Foot. —

also N^o 204, 205 & 206
(app^d 18.10.05)


21.8.05
28.8.05
2.9.05
18.10.05

Match end beams
as per midship
section.

See 44 page 4.

Stringer to Surveyor's satisfaction

Beak top
in ship

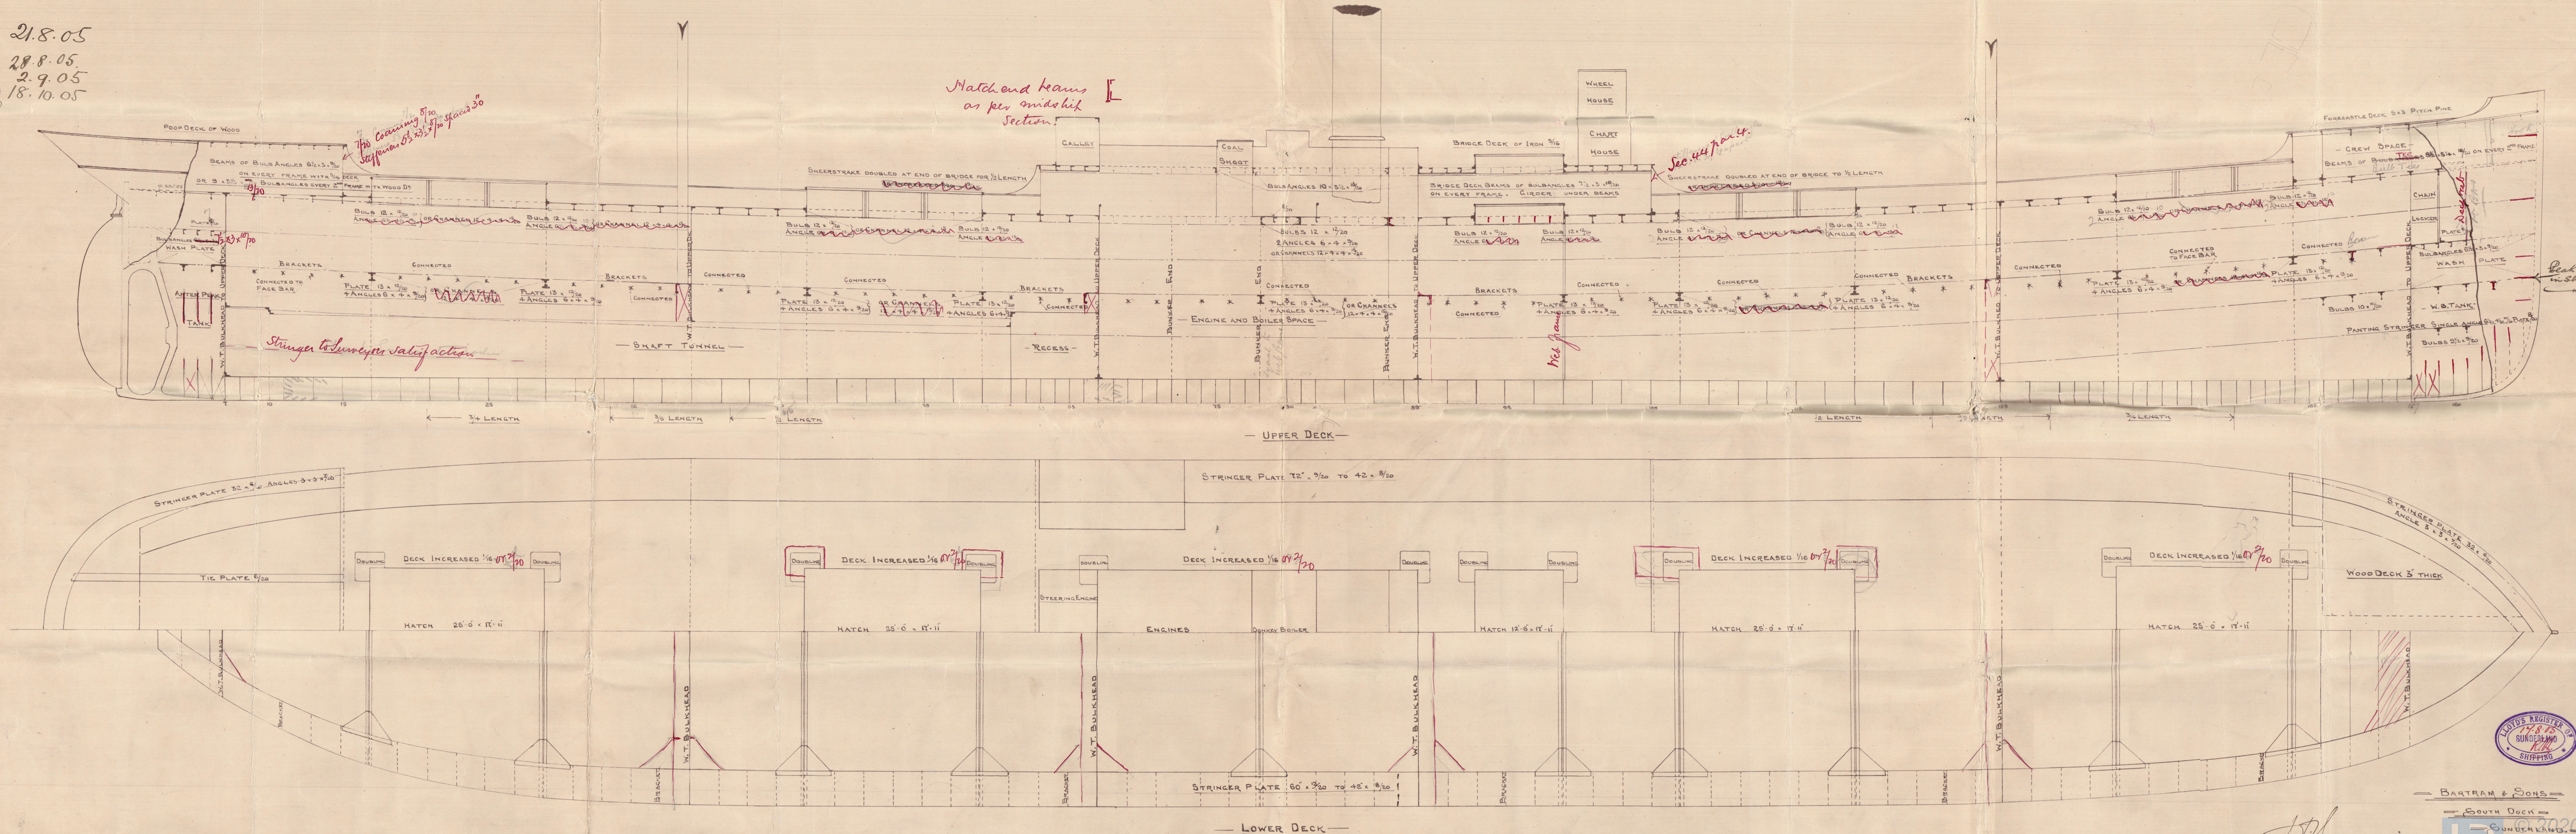

— BARTRAM & SONS —
— SOUTH DOCK —
— SUNDERLAND —

2/10/05

Lloyd's Register
W881-0143 foundation



© 2020

Lloyd's Register
Foundation

