

17-9-04
31.1.05

— N^o 490-1. —
— PROFILE & DECK PLAN —


— 126' 8" BP x 22' 0" x 12' 10 1/2" MW. —

— TO CLASS 100 A.1. STEEL AT LLOYD'S. —

— STEAM TRAWLER —

— SCALE 1/4" = 1 FT. —

— SCANTLINGS AS PER SECTION. —


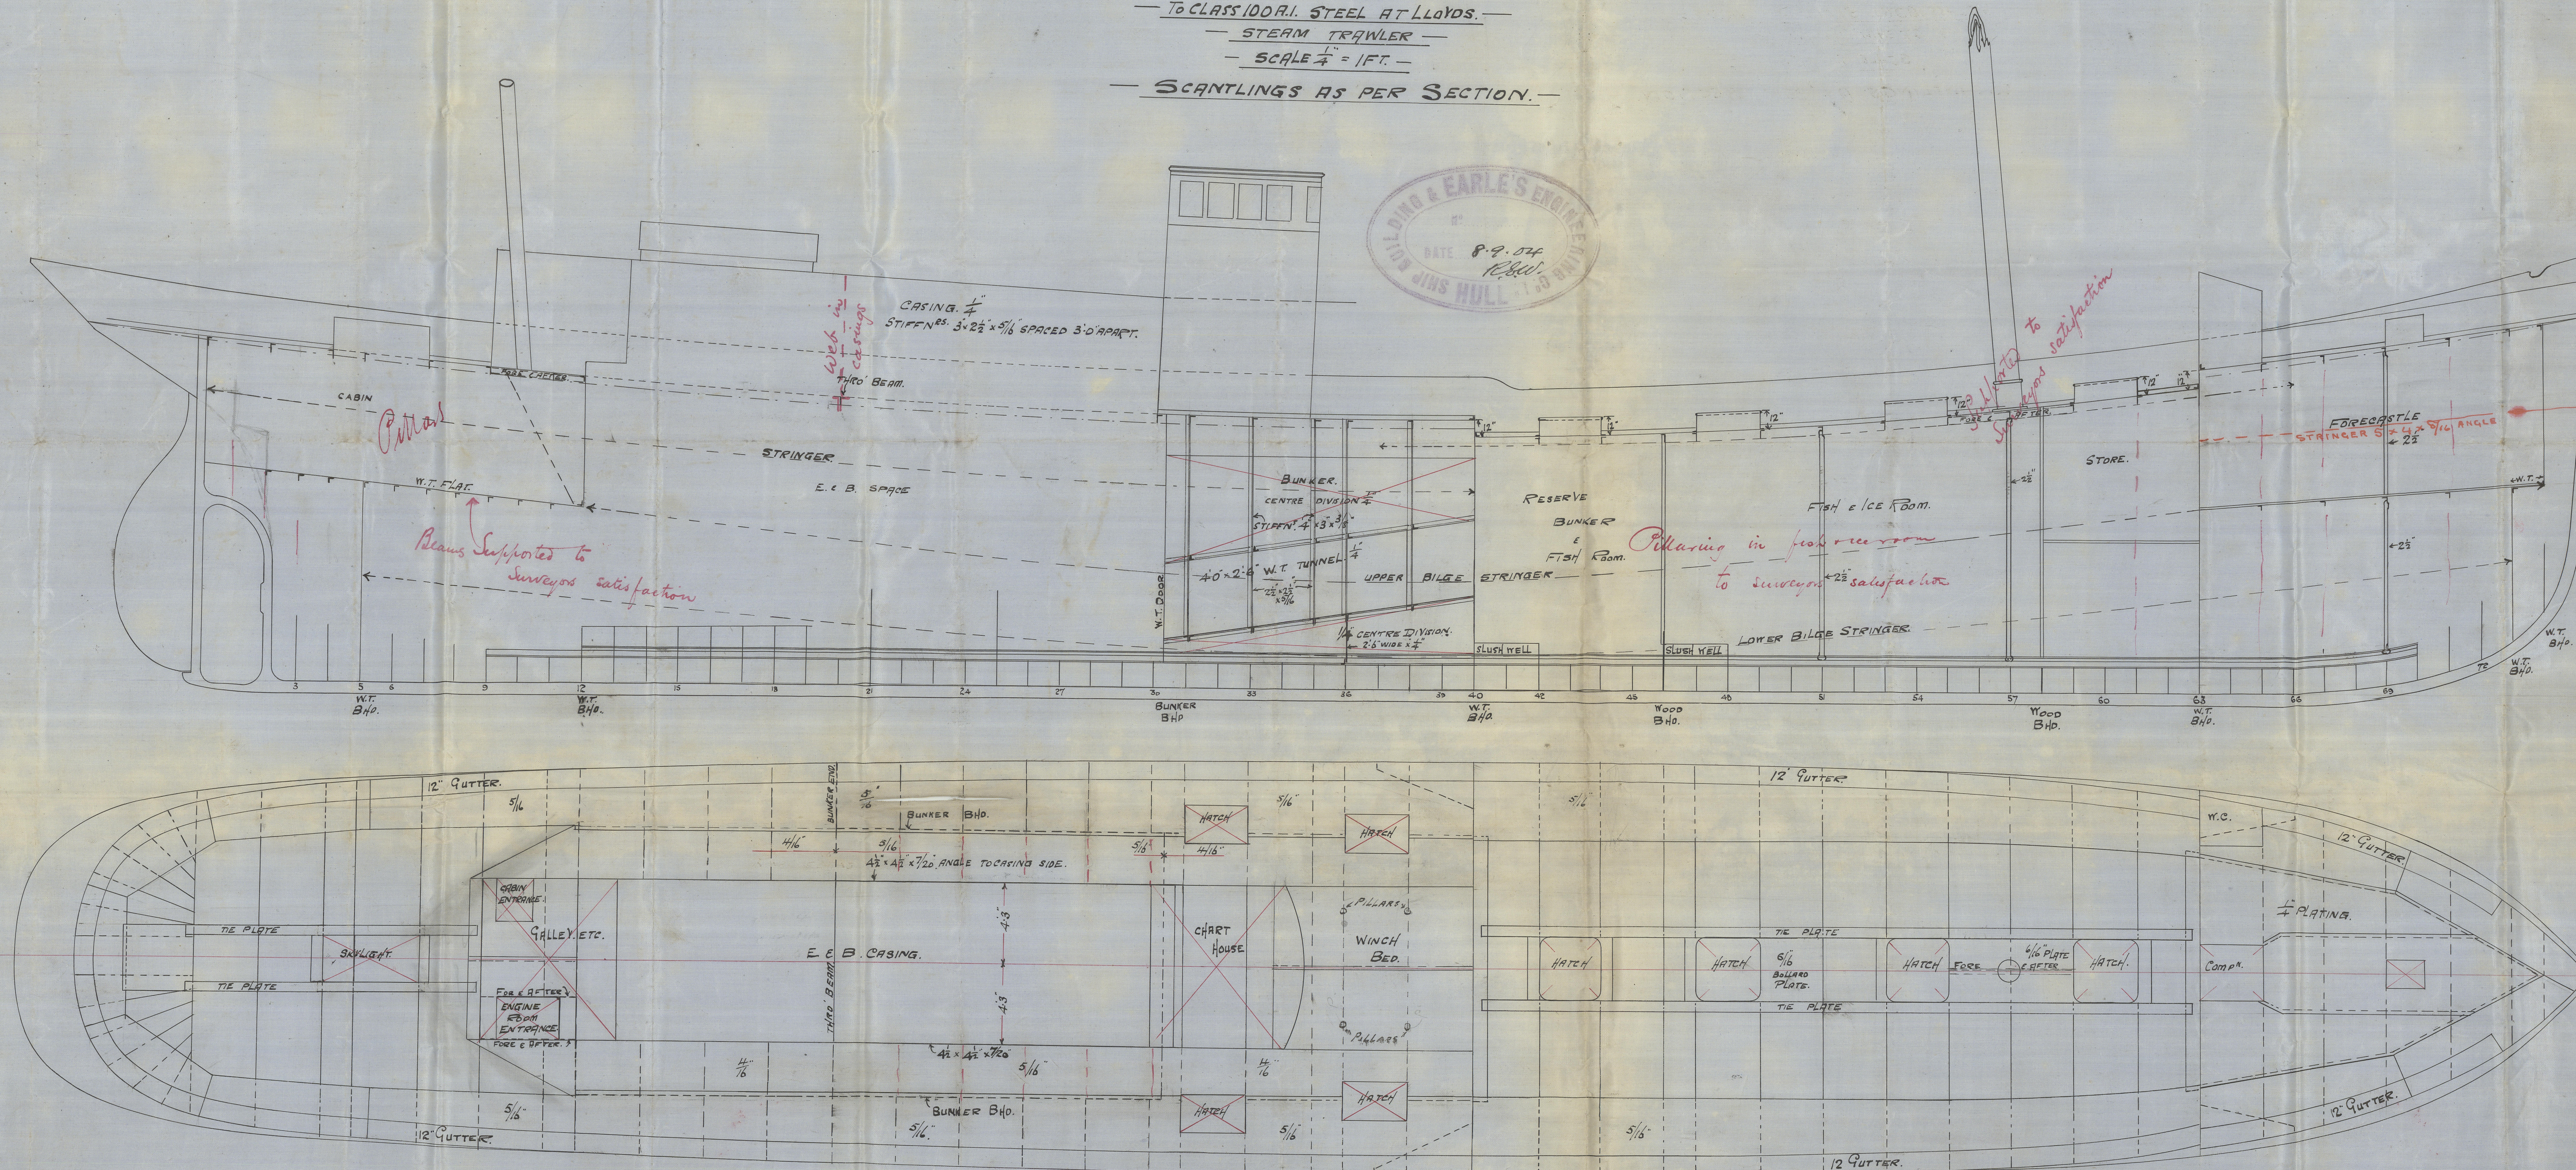


REMAIN

Charles S & R. Co.


N^{os} 490 + 491

Profile & Deck Plan

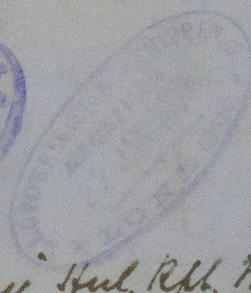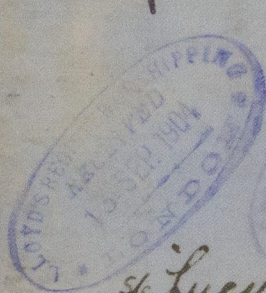

of Lucy Hul. Rph. No. 16583

of Laura - - - 16611

 

RETAIN



© 2020

Lloyd's Register
Foundation

W832-0112