



14.12.04


# 49041 PUMPING PLAN. SCALE 1/4" = ONE FOOT.

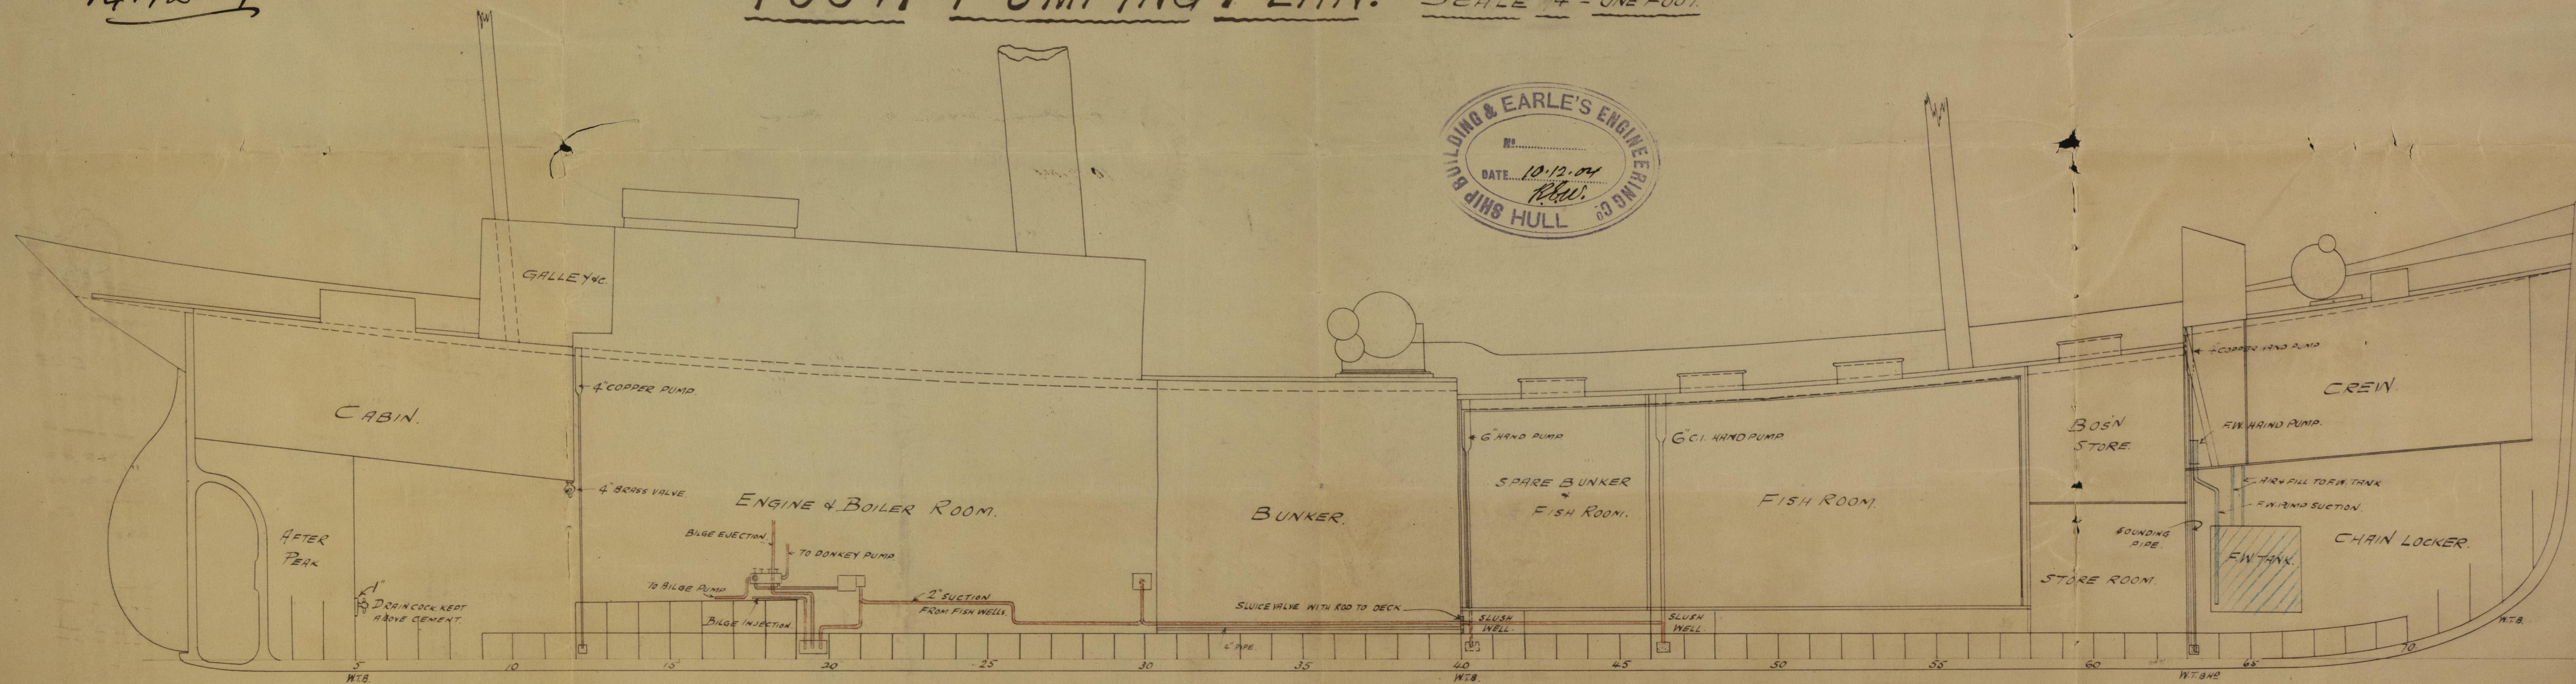

DECK PLAN.

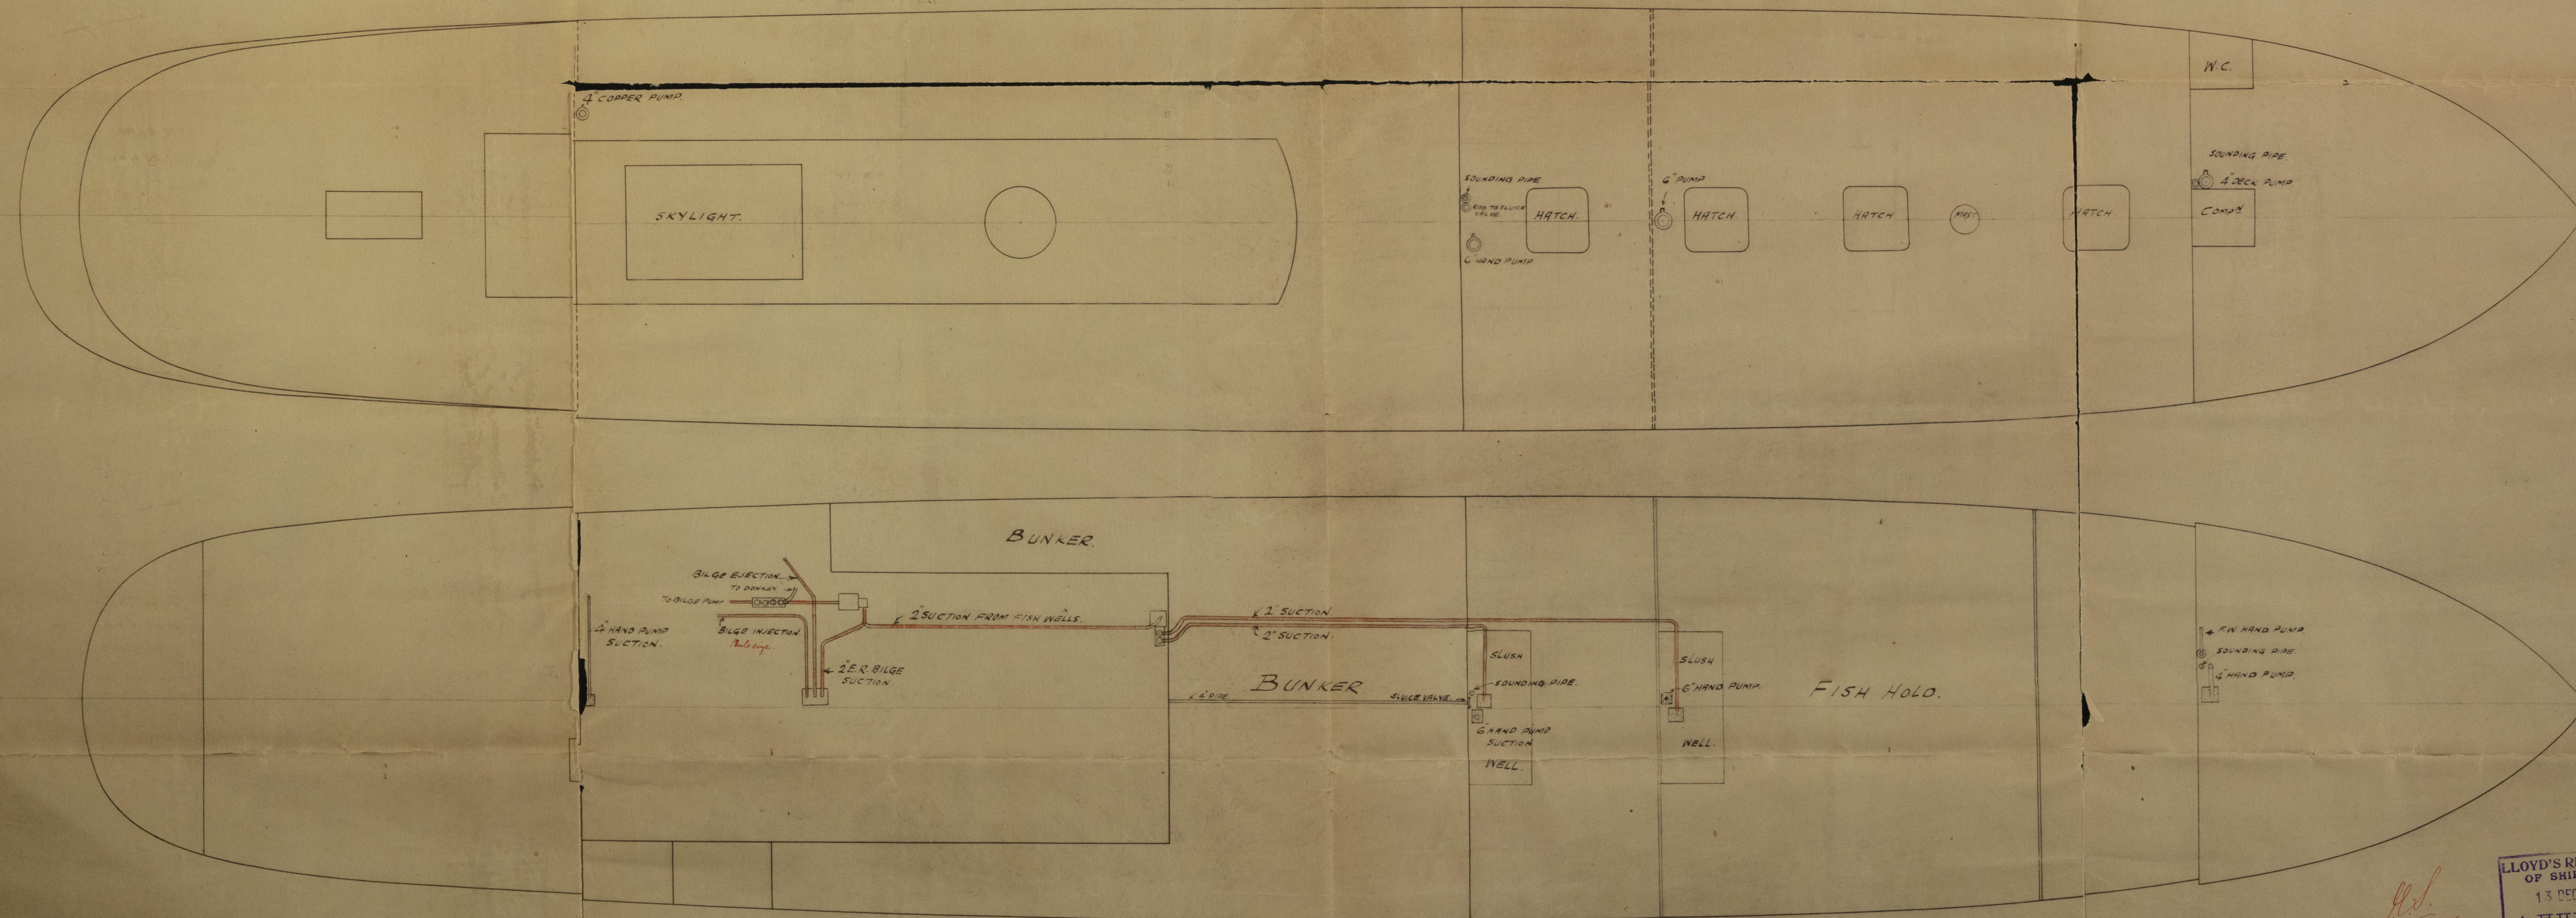

LLOYD'S REGISTER  
OF SHIPPING  
13 DEC. 1904  
+ HULL. +

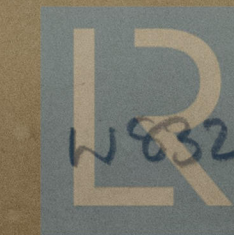


© 2020  
W832-0113's Register  
Foundation



Pumping arrangement

Earle's No 490 + 491 -

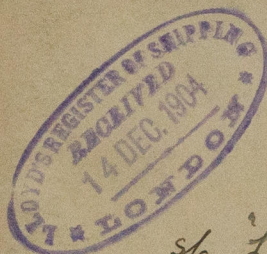

s/s 'Lucy'  
Hull Report No. 16583

s/s 'Laura'  
Hull Report No. 16611



© 2020

Lloyd's Register

W832-0113 Foundation