

— N^{OS} 490-1 —

MIDSHIP SECTION

— 126' 8" B.P. x 22' 0" x 12' 10 1/2" M^{LD}. —

— TO CLASS 100 A.1. STEEL AT LLOYDS —

— STEAM TRAWLER. —


— SCALE 1/2" = 1 FT. —

BLACK --- AS PER RULE

RED -- TO OWNERS REQUIREMENTS.


1/2 BREADTH	11.00
1/2 GIRTH	20.33
DEPTH	13.33
	44.66 = 1 ST N ^O
LENGTH PER RULE	125.64
	17864
	22330
	22330
	8932
	4466
	5606.6164 = 2 ND N ^O

$$\frac{L}{D} = 9.4$$

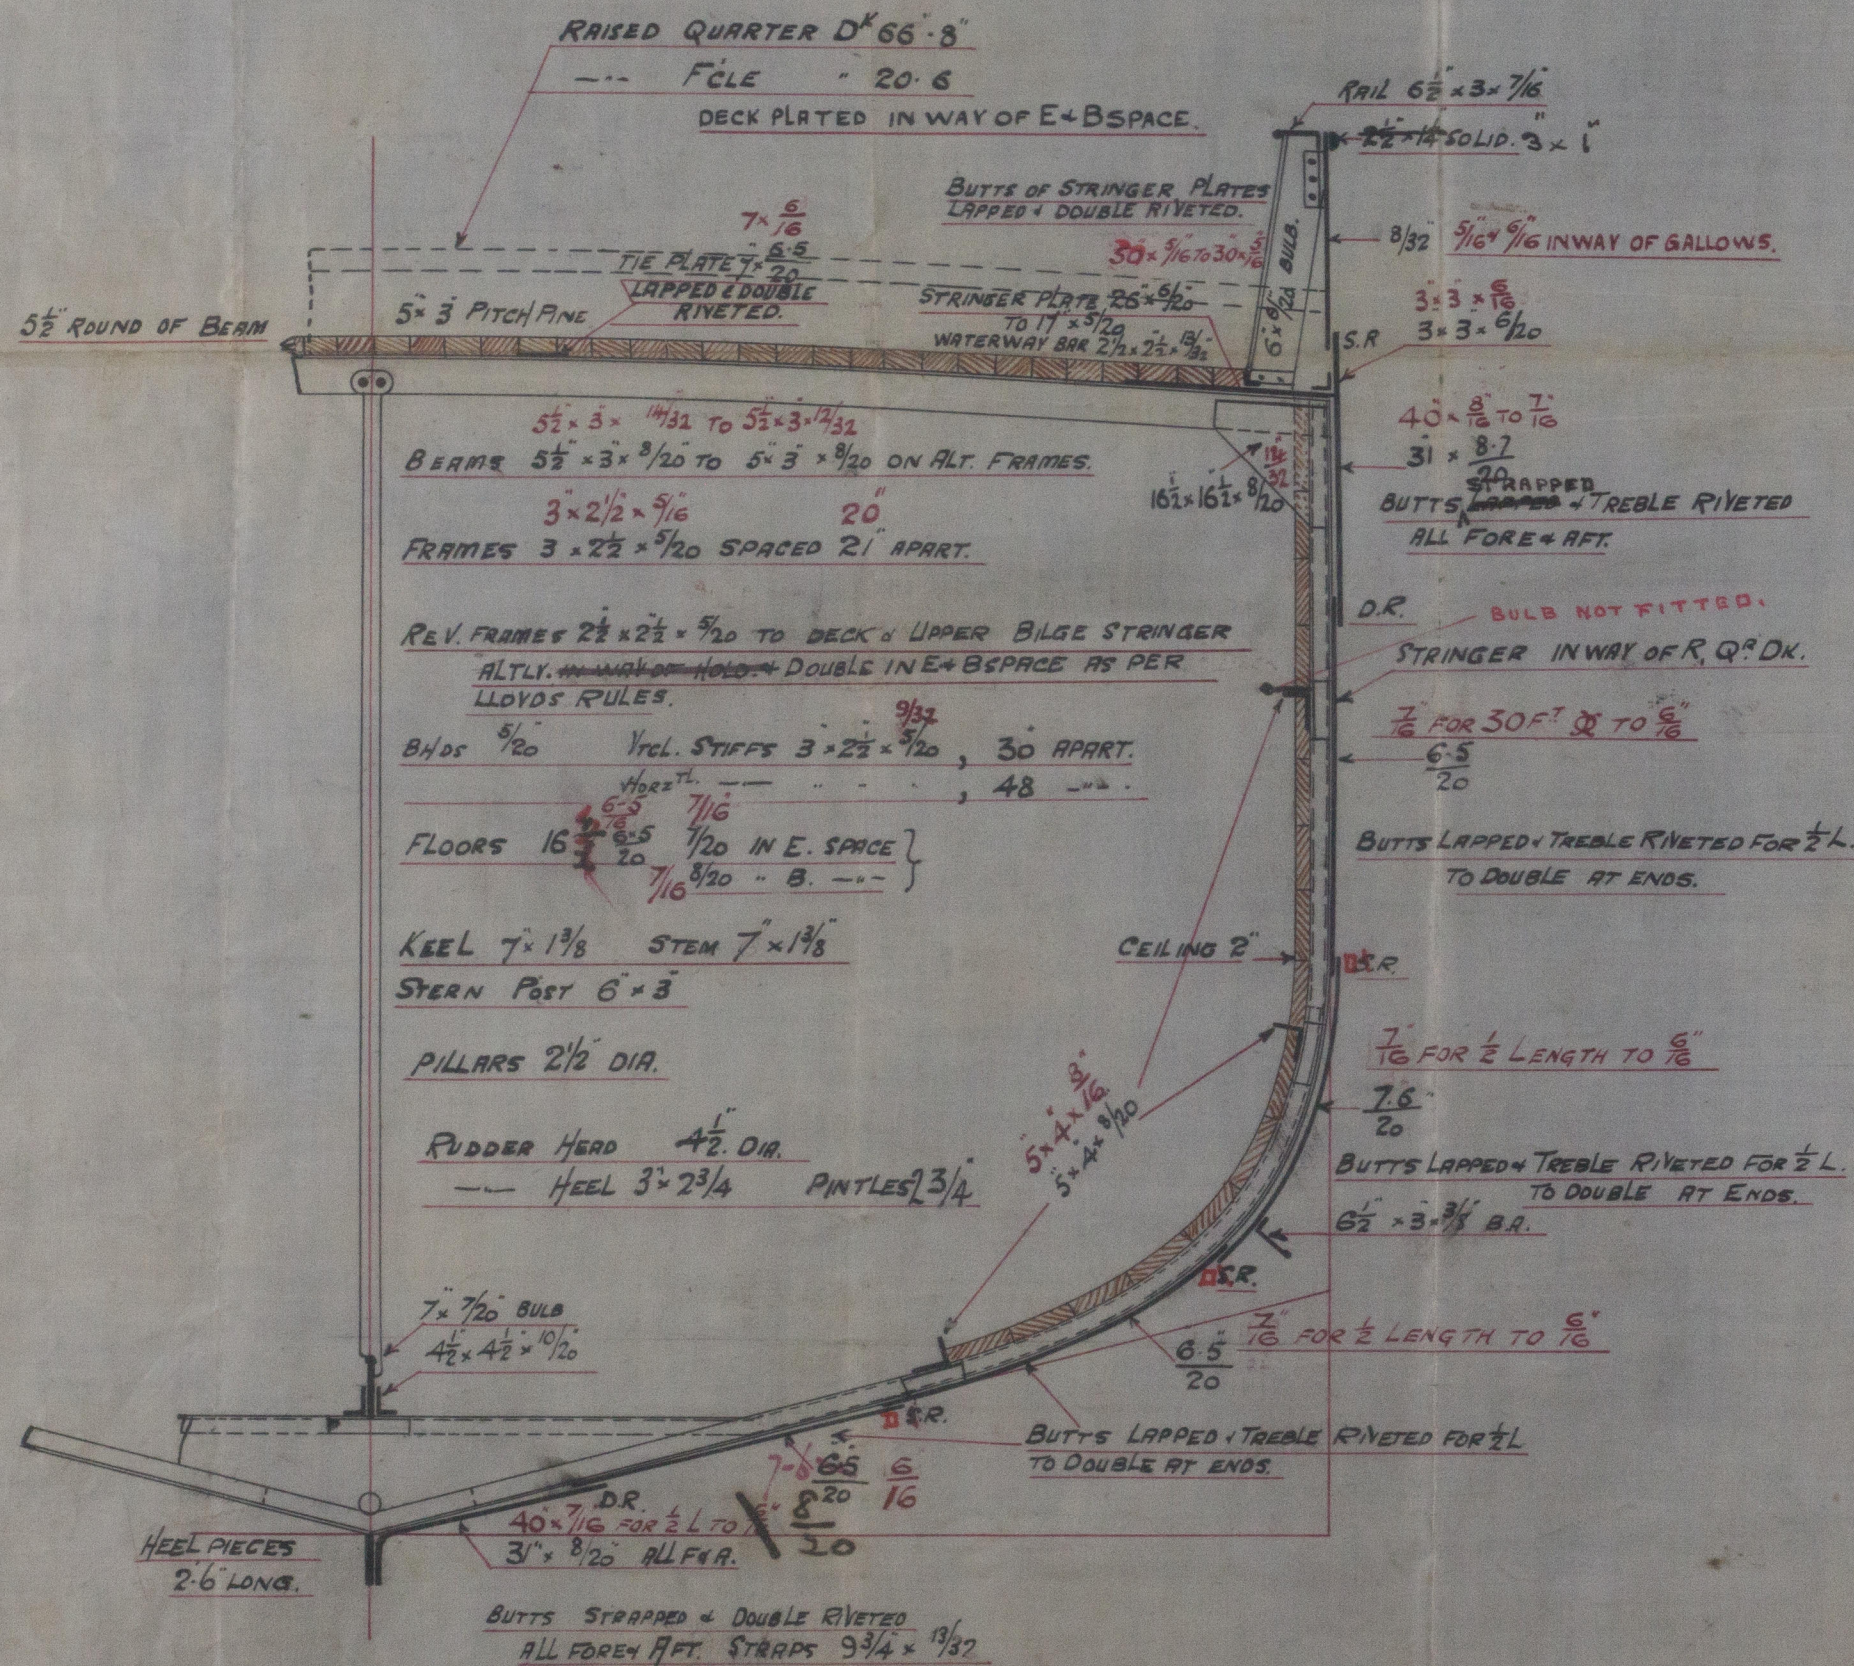

EQUIPMENT.

ANCHORS EX. STOCK	5 3/4, 5 1/4 + 3 CUTS.
105 FTHS	1 1/2 CHAIN CABLE
60	6 HAYSER
60	5 WARP

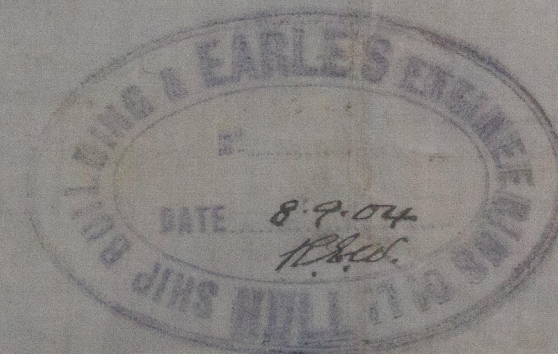

c.B.
17.9.04
14/9/04

© 2020

Lloyd's Register
Foundation

Earle S+E.C.

N^o 490 + 491


Amended •

Midship Section

Sp Lucy Hull R/L No. 16583

Sp Laura " " 16611

RETAIN

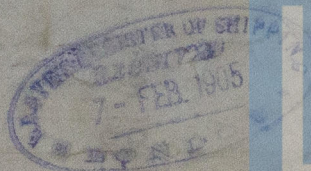

© 2020

Lloyd's Register
Foundation

W832-0114