

17.2.11
18.3.11

MIDSHIP SECTION

STEEL SCREW TRAWLERS

N^{OS} 489-90-1

DIM^{NS} LEN 133'-4" x 23'-0" EX. x 12'-9" DEPTH MOULDED

SCALE 1/2" = ONE FOOT

TO CLASS 100.A1 FOR FISHING PURPOSES. DECK PLATED OVER IN WAY OF MACHINERY SPACE. ENGINE & BOILER CASING AS PREVIOUSLY APPROVED

PLAN No 10072


FOR ENCLOSURE TO
Messrs Lloyds Surveyors
Hull FROM

COCHRANE & SONS

SHIPBUILDERS SELBY

DATE 15/2/11

RL

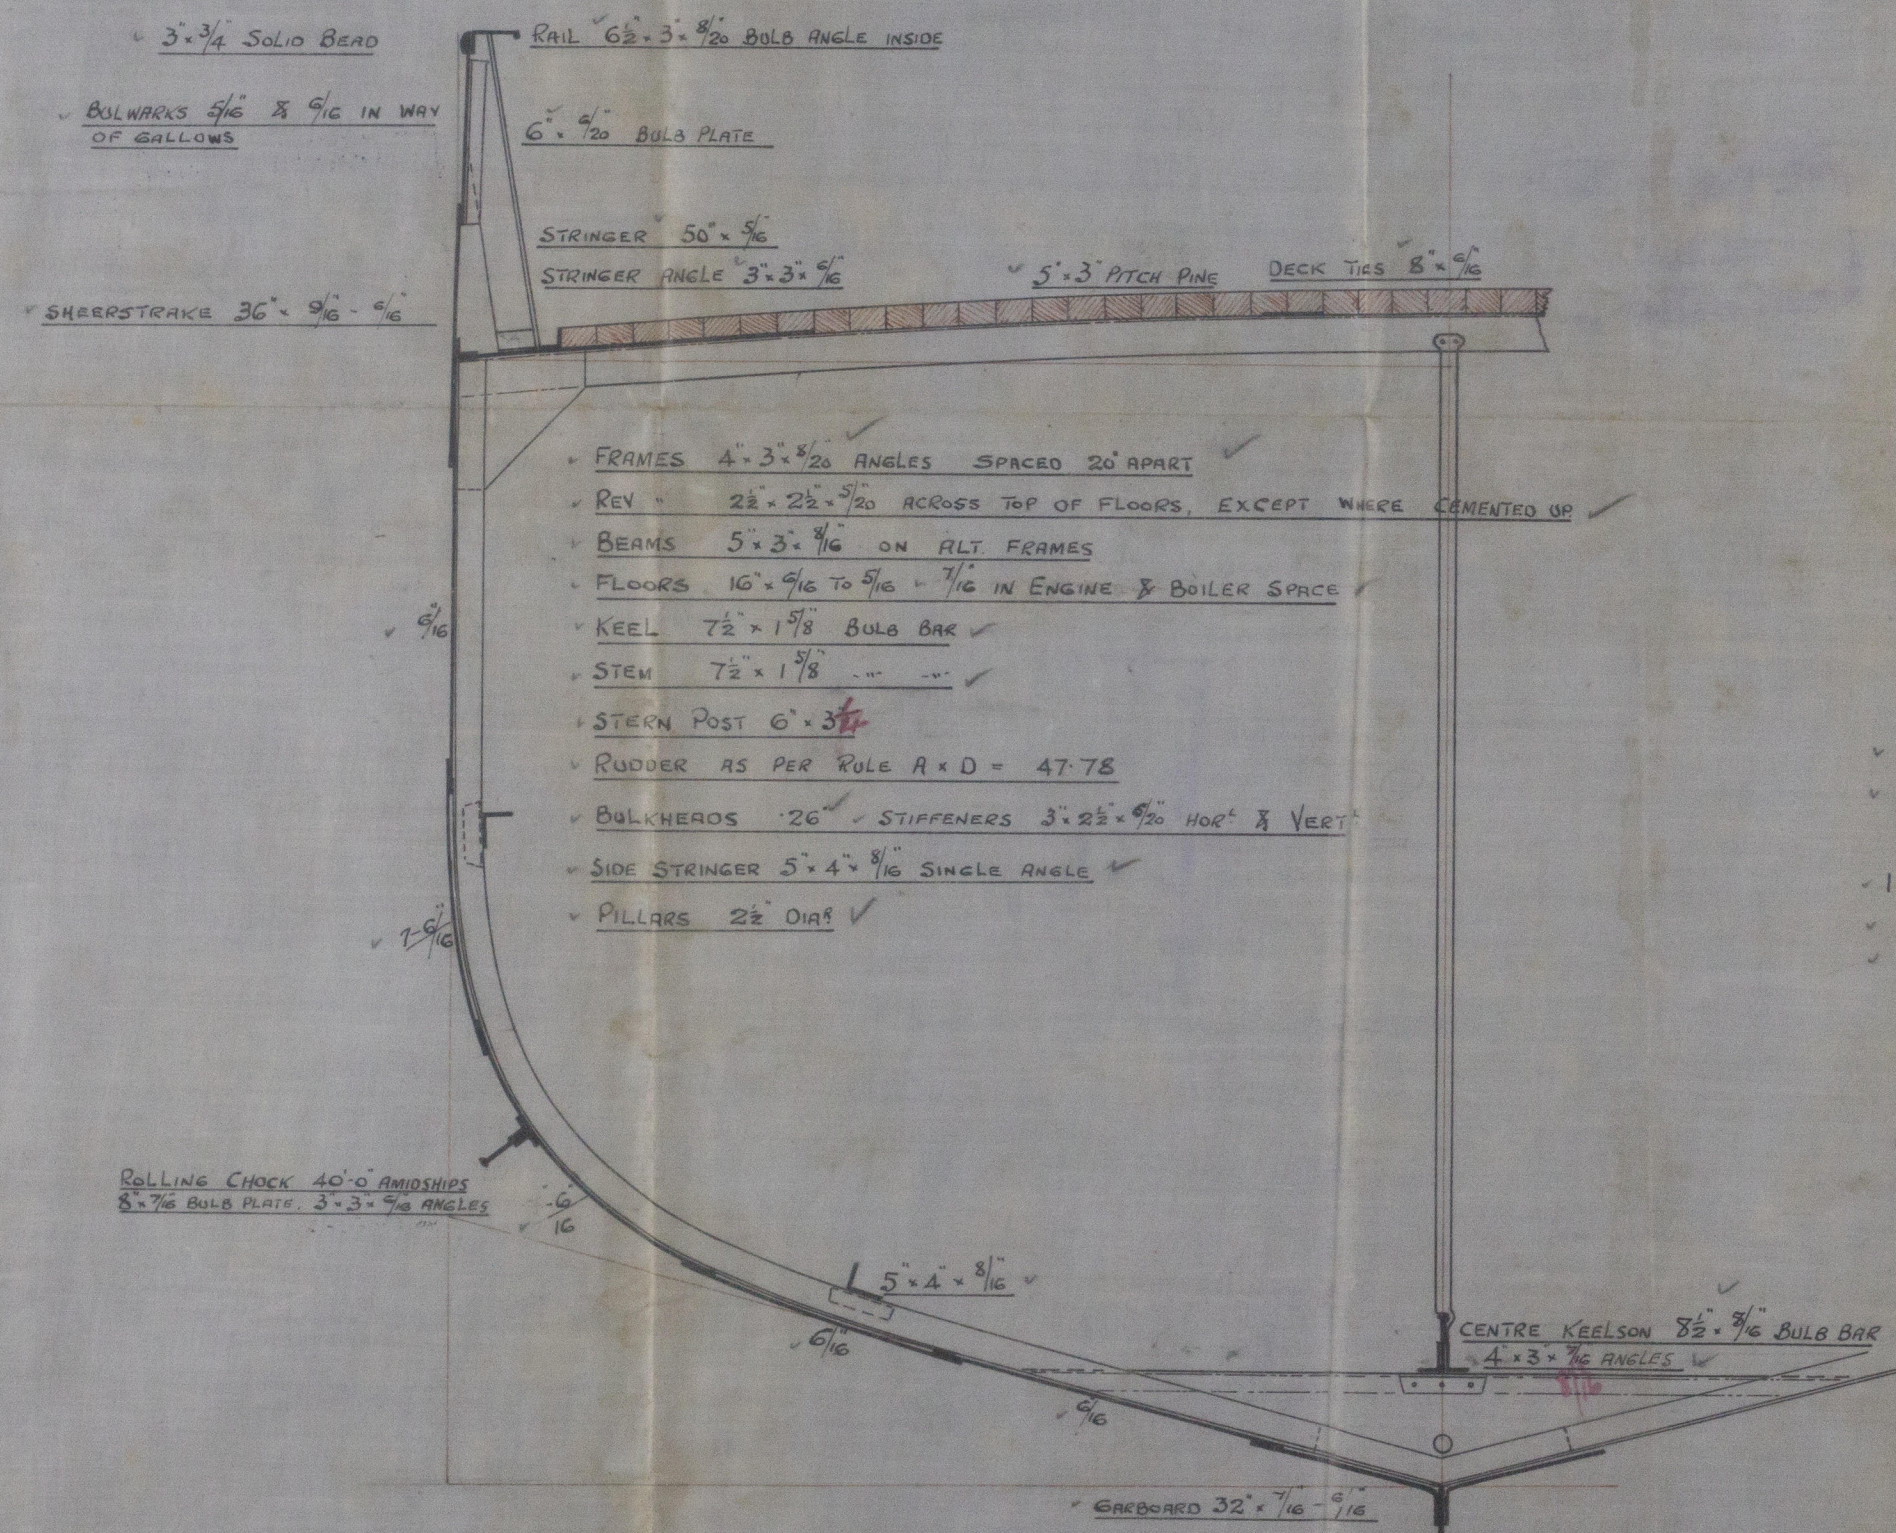

NUMERALS

| | | |
|-------------|---|---------|
| B + D | = | 35 63 |
| L x (B + D) | = | 4750.54 |

PROPORTIONS

| | | | |
|-----|---|-------|--------|
| B/D | = | 10.33 | 10.45. |
| | = | 8.75 | 5.82. |

EQUIPMENT

| | | | |
|------------------------------|-------|--------|----------|
| 1 ST BOWER ANCHOR | 5 3/4 | CWTS | EX STOCK |
| 2 ND " " | 5 1/4 | " " | " " |
| KEDGE " " | 3 | " " | " " |
| 105 FATHOMS | 1 1/2 | CABLE | |
| 60 " " | 6 | HAWSER | |
| 60 " " | 5 | WARP | |

RIVETING

- BUTTS OF SHELL PLATING LAPPED & DOUBLE RIVETED
- EXCEPT GARBOARD & SHEERSTRAKE WHICH ARE TO BE
- STRAPPED & DOUBLE RIVETED LANDINGS DOUBLE RIVETED
- BULKHEADS SINGLE RIVETED

C.B.
17.2.11.
18.3.11.



© 2020

Lloyd's Register
Foundation

Cochran & Sons.
No. 489. 490. & 491.
Midship Section.
Amended.

1/2 Lord Salisbury
Hull Rpt No-24208.


1/2 Michael Angelo

Hull Rpt No-24222.

1/2 Lord Knolly's
Hull Rpt No.

RETAIN

W832-0148

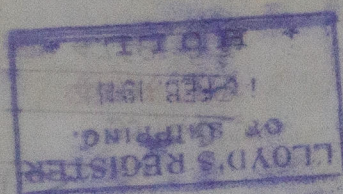

SECTION
1-00-08
DECK
ONE FLOOR
DECK MOUNTED
100/5

