

17-2-11
18-3-11

Handwritten notes in red ink at the top of the page, including "17-2-11" and "18-3-11".



PROFILE & DECK PLAN

STEEL SCREW TRAWLERS

N^{os} 489-90-1

DIMNS LEN 133'-4" x 23'-0" EX. x 12'-9" DEPTH MOULDED
SCALE 1/4" = ONE FOOT

PLAN NO. 10073
Messrs. Elford & Son
Hull
10/11/11 R.R.

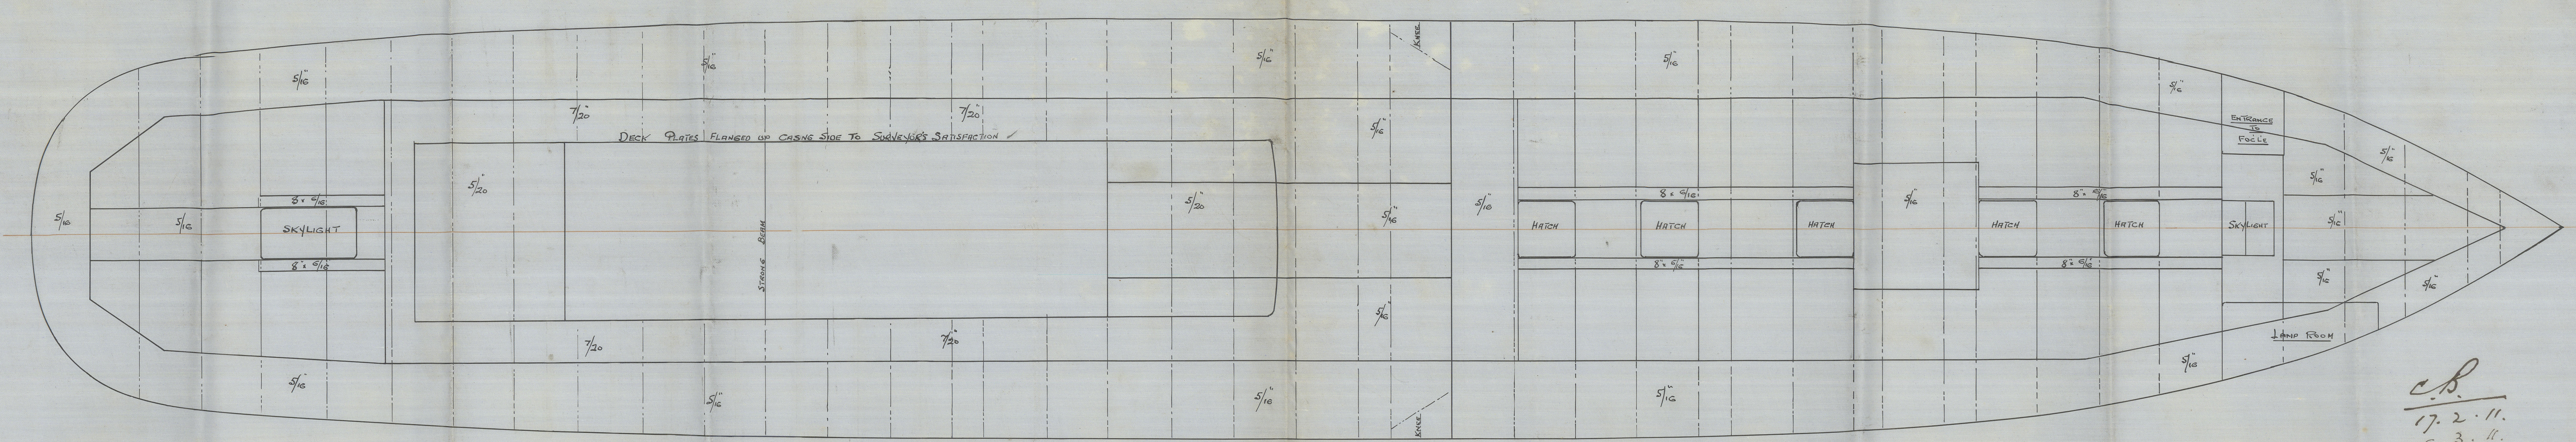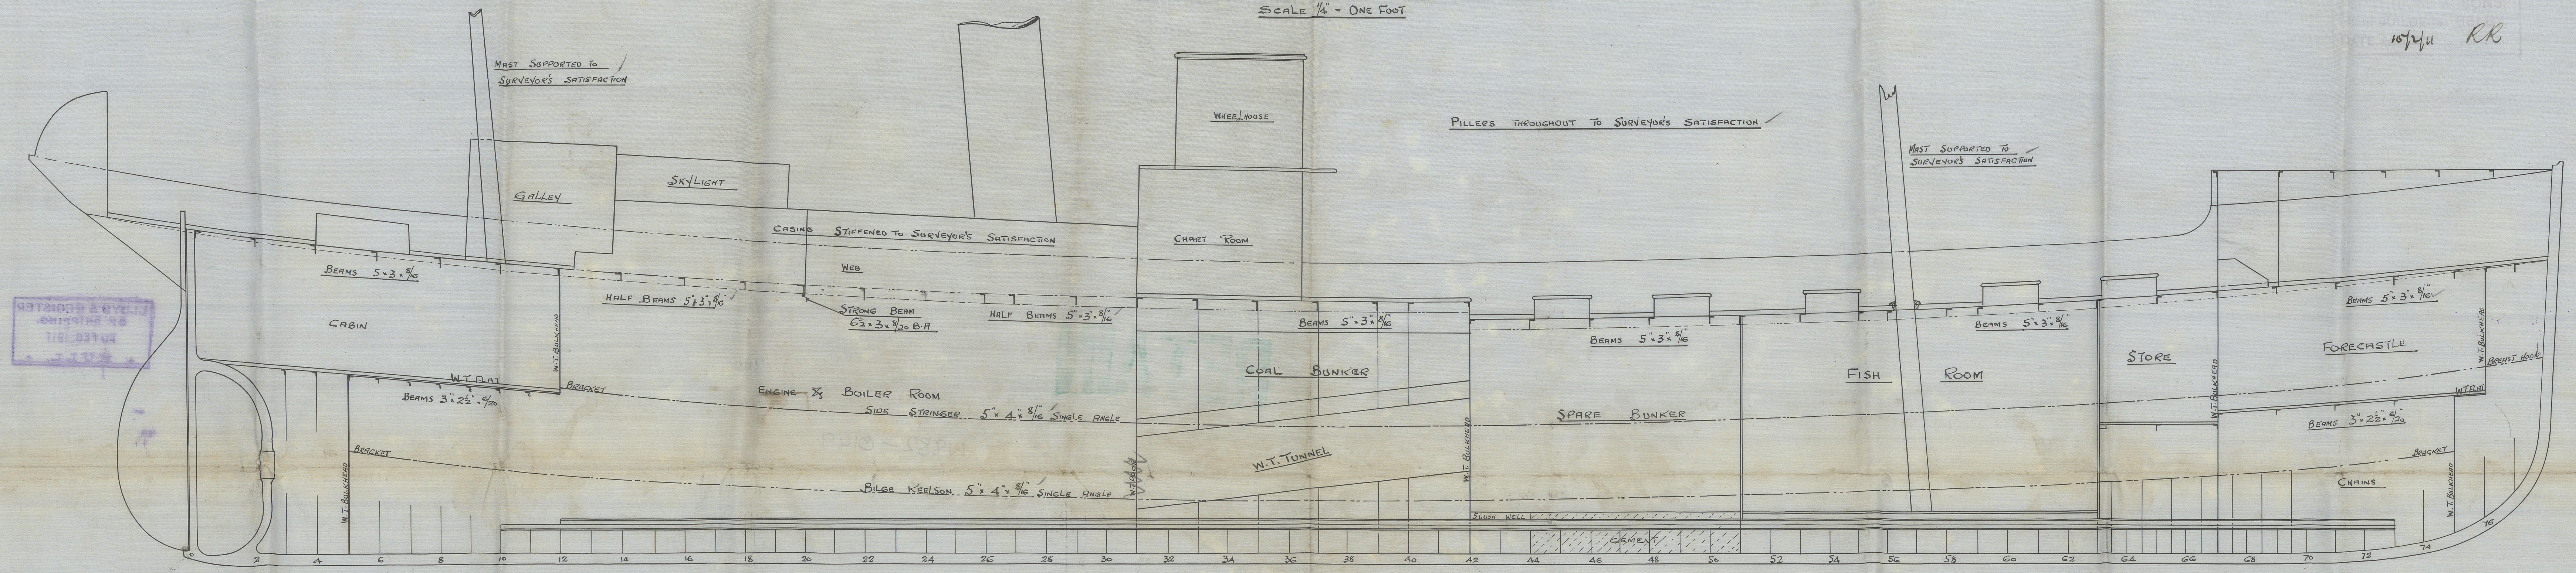

Handwritten signature and date: 17-2-11, 18-3-11.


Cochran & Sons
Nos 489, 490, & 491.

Profile & Deck Plan.
Amended

Lord Salisbury Hull Rpl 24208

Michael Angelo . . . 24222

Lord Dudley's . . . 24266

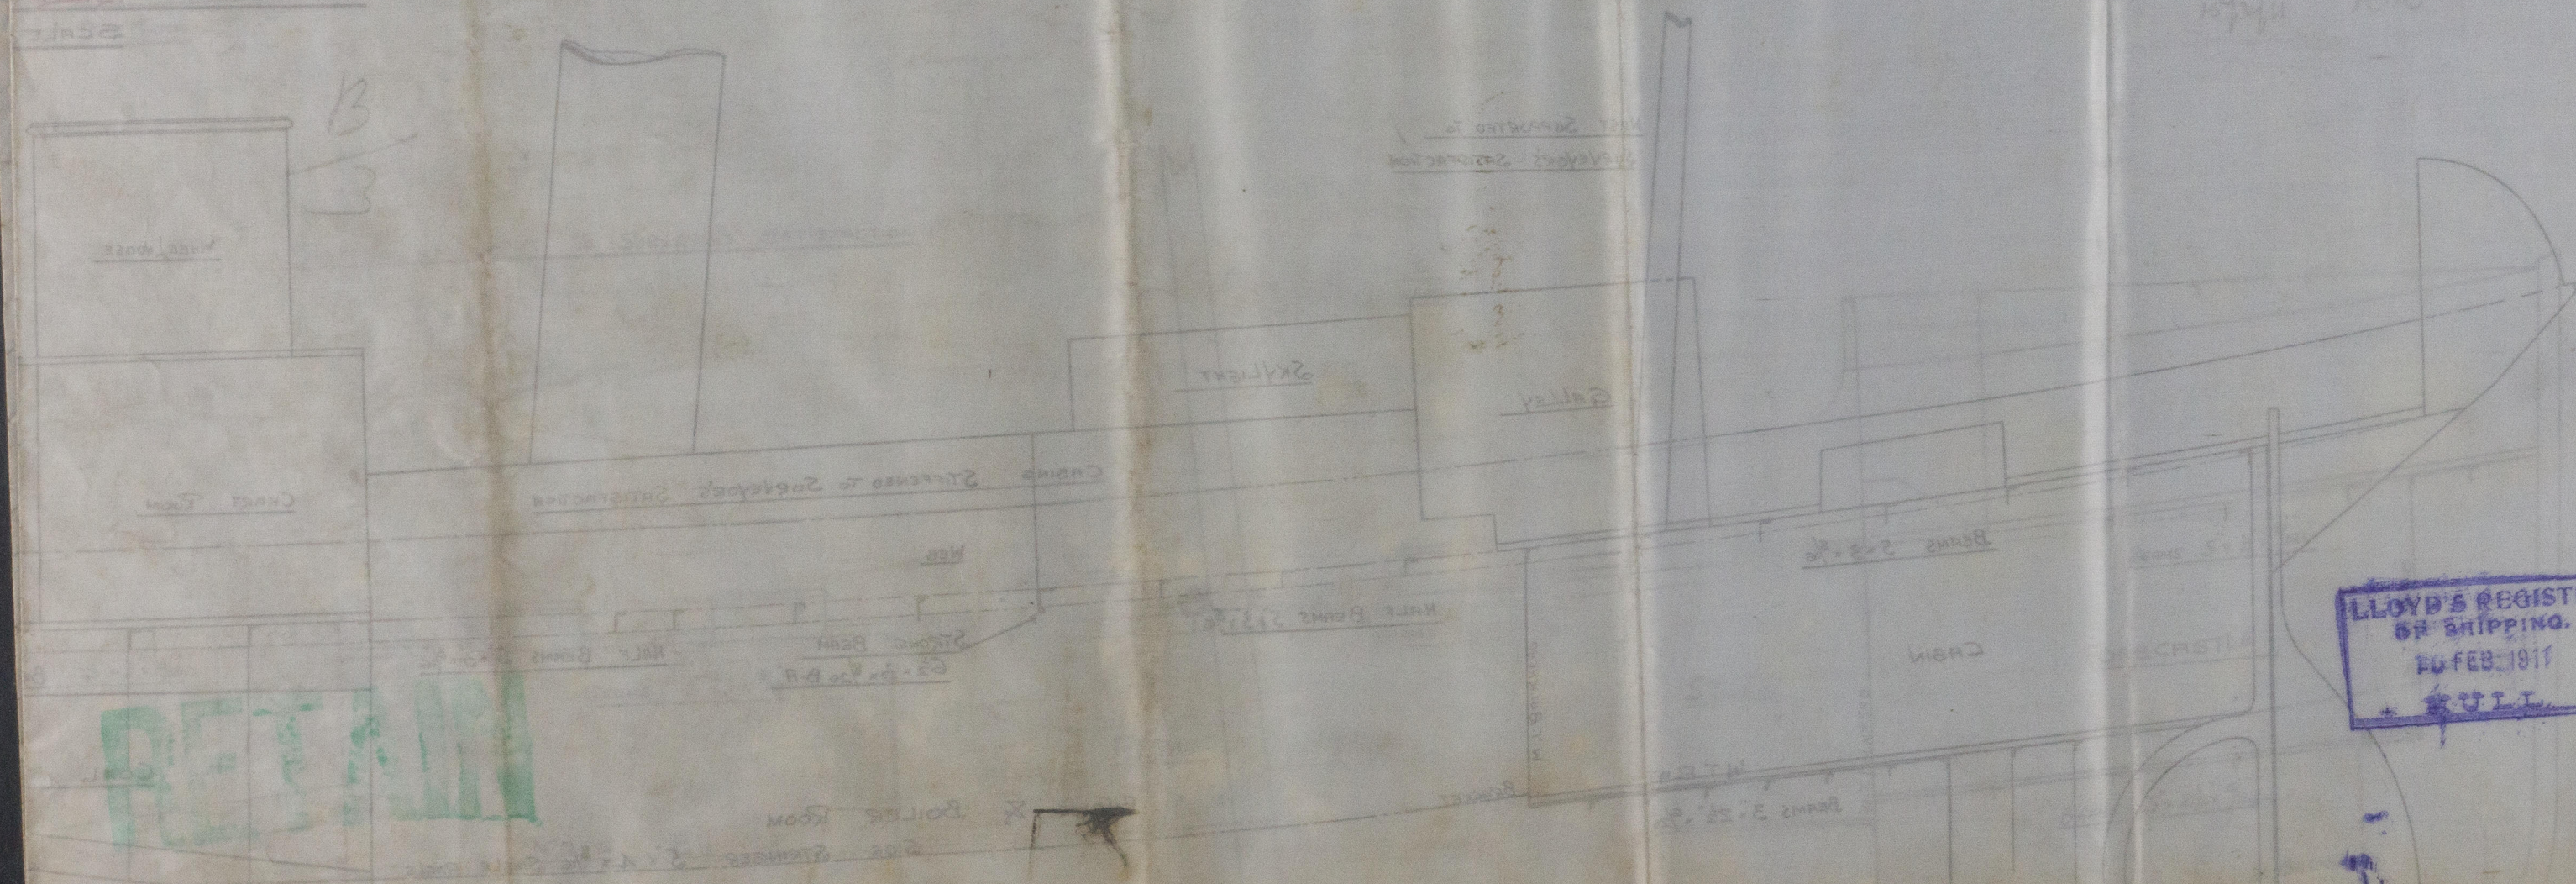

W932-0149

LLOYD'S REGISTER
OF SHIPPING.
FO FEB 1911
HULL

