



4/4/11

# PUMPING PLAN

N<sup>OS</sup> 489-491

25 SCALE 1/4" = ONE FOOT

PLAN No. 172  
FOR ENCLOSURE TO  
Messrs. Lloyd's Surveyors  
Hull FROM  
COCHRANE & SONS,  
SHIPBUILDERS, SELBY  
DATE 1/4/11 R.R.

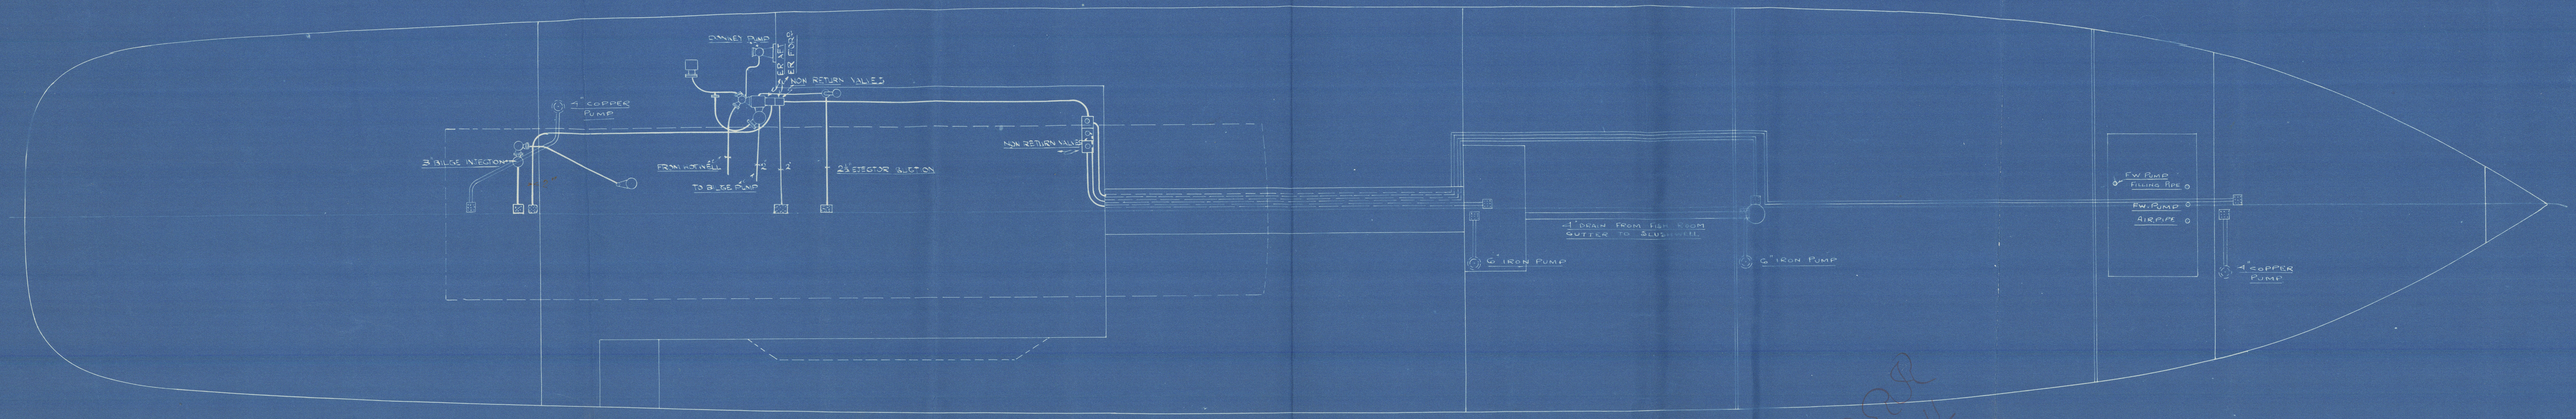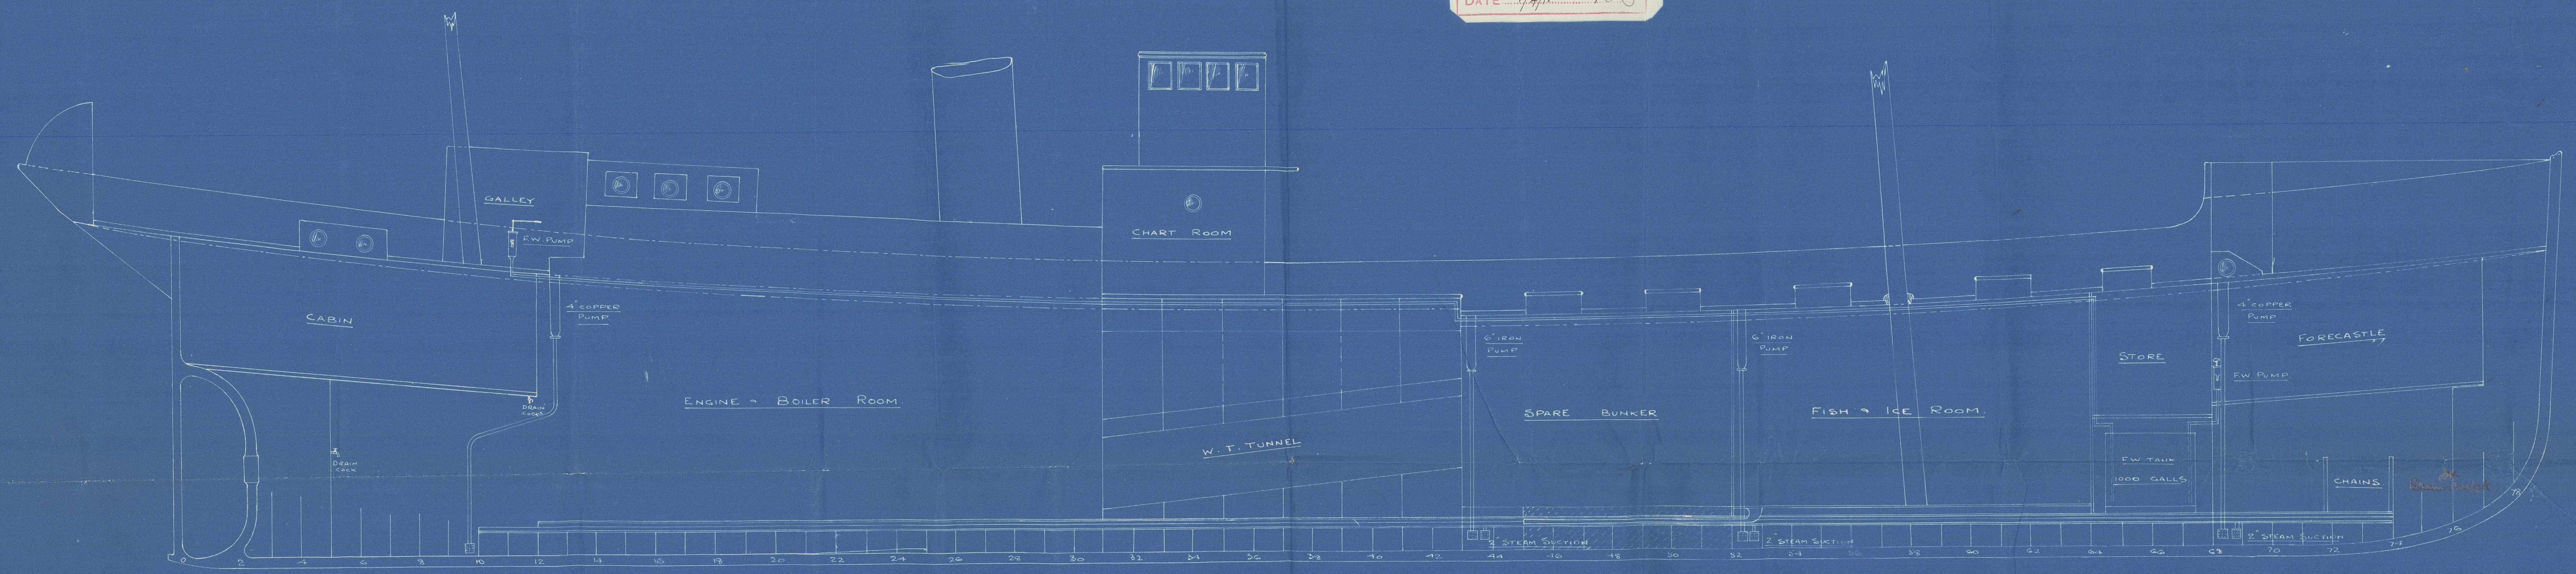


RR  
4/4/11



- Pumping Plan - A

Lochrane & Sons 3

- Nos 489-90-91 -

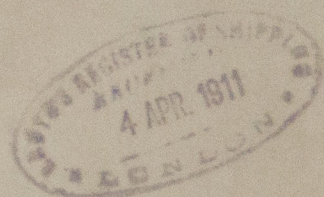

of Lord Salisbury  
Hull Rpt No. 24208

Michael Angelo  
Hull Rpt No. 24222

Lord Knollys  
Hull Rpt No. 24266

W832 - 0151

RETAIN



© 2020

Lloyd's Register  
Foundation