
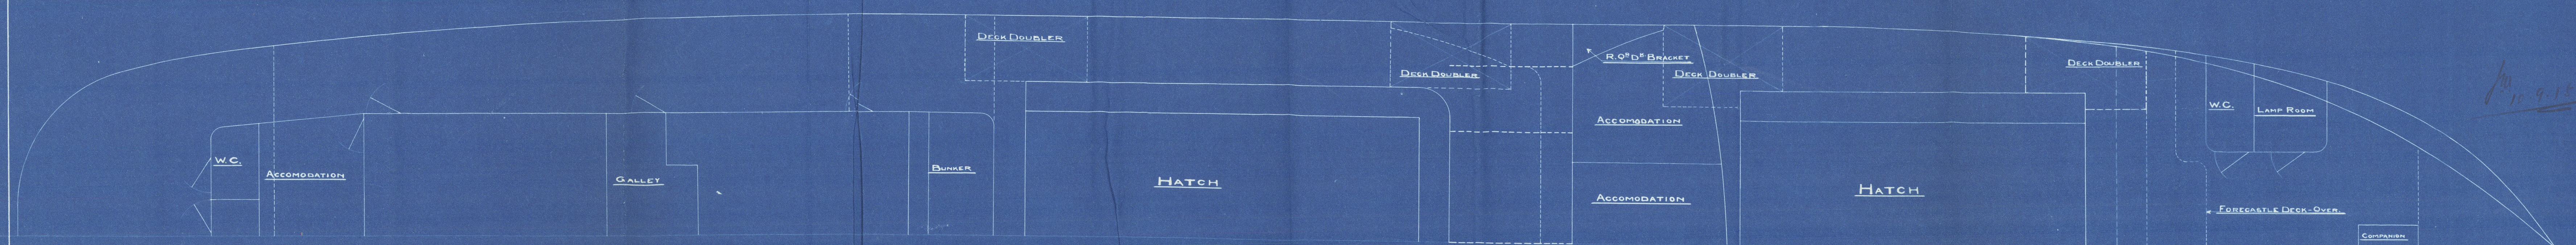


PROFILE OF STEELWORK
VESSEL N^o 508-142-0*25-10*12'-6" & V.518 ALTER^{ED} IN RED.
SCALE - 1/4" = 1 FOOT

TRACING N^o 782.

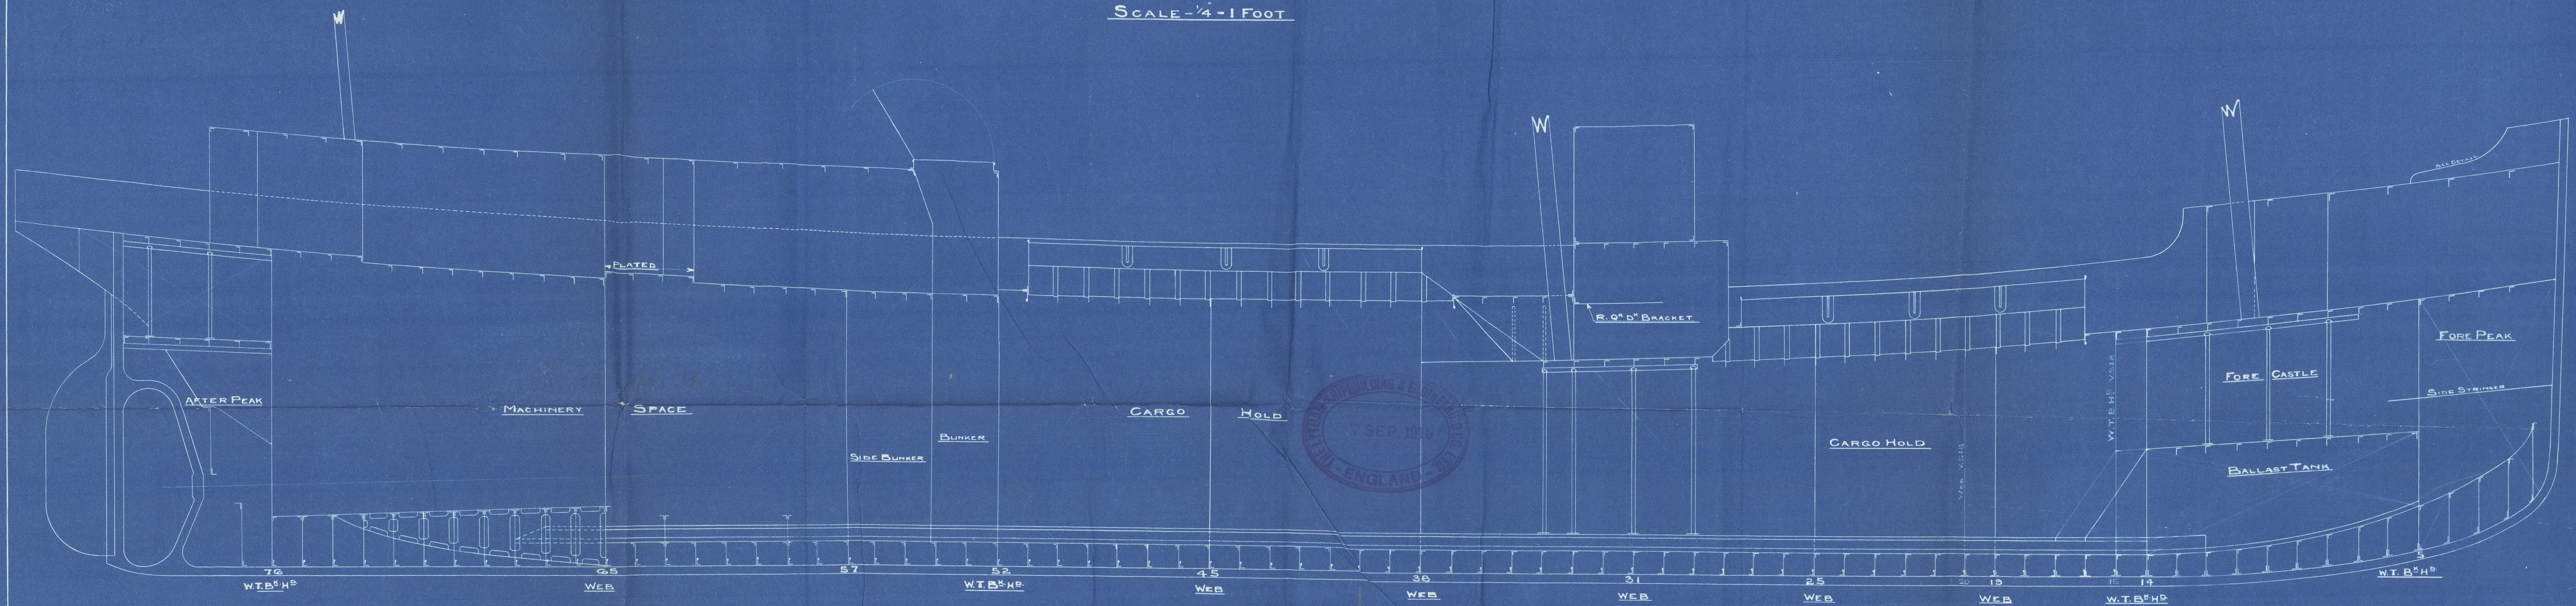

HALF PLAN OF MAIN & QUARTER DECKS.

APPROVED BY LLOYDS 15-5-14.


Lyncham C B Co
518

Profile

S.S. "Limesfield"
Liv. 75674.



RETAIN

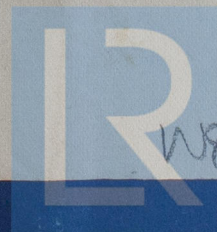

© 2020

W83400052 Register

Foundation