



Nº 330.

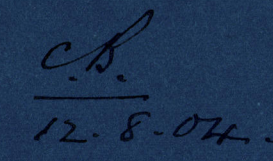


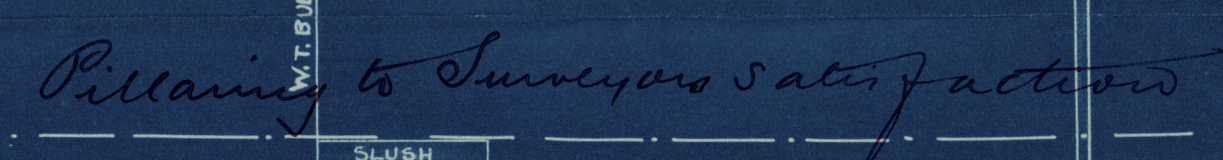

Profile & Deck plan

Cochrane & Sons

No 330/s

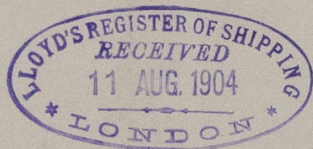

s/s 'Mantman'

Hull Report No. 16439

RETAIN



© 2020

Lloyd's Register  
Foundation

W835-0151.2