



12.8.04

MIDSHIP SECTION

Nº 330.


DIMENSIONS.

Length 115'-6"
Breadth 21'-6"
Depth 12'-3 mld.

Scale 1/2" = 1 FOOT.

CLASS 100.A.1. AT LLOYD'S FOR FISHING PURPOSES.

E & B. CASING AS PREVIOUSLY APPROVED.

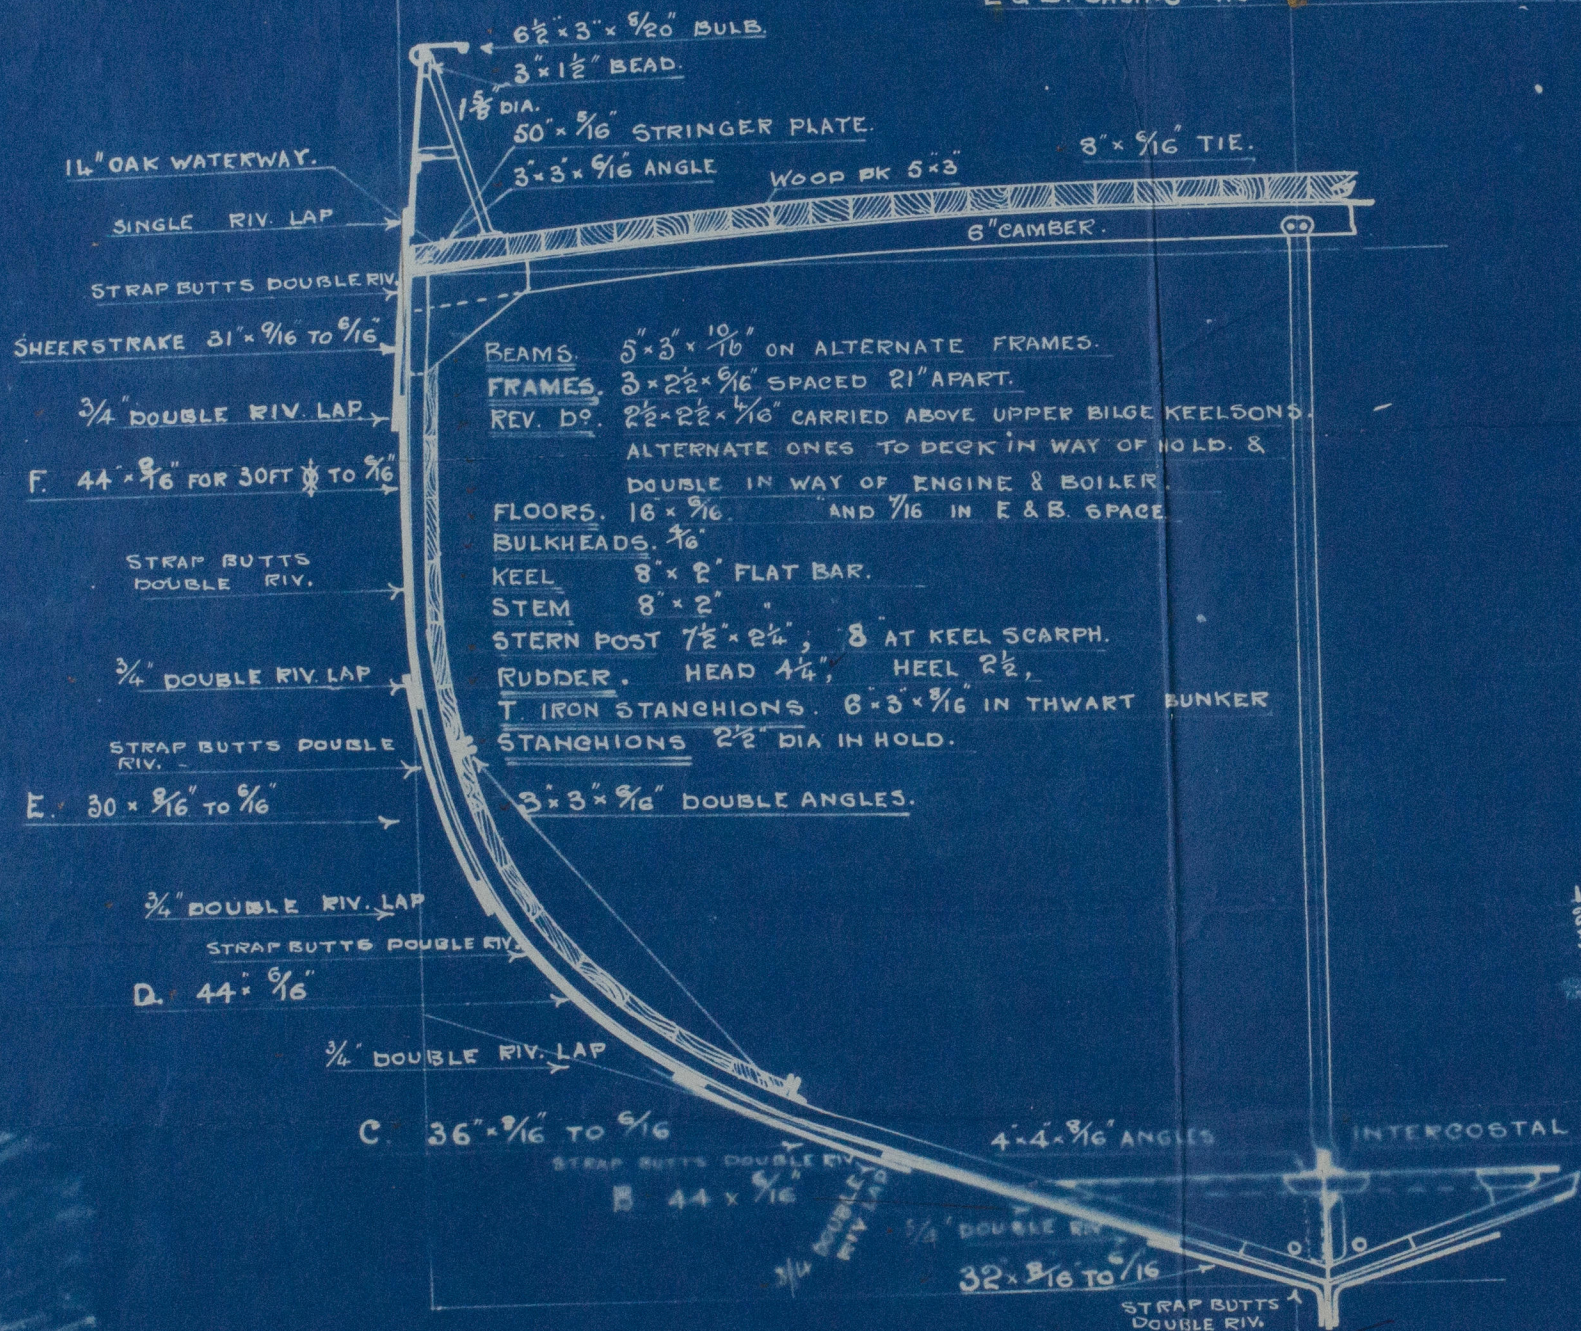

NUMERALS.

1/2 GIRTH	18.70
1/2 BREADTH	10.70
DEPTH	12.7
	42.10
	114.21
	4210
	8420
	16840
	4210
	4210
	48082410

PROPORTIONS

DEPTHS TO LENGTH 5.3
BREADTHS TO LENGTH 8.9.

RAISED QUARTER DECK 50'-0" x 15"
" FORECASTLE " 18'-8" x 15"

EQUIPMENT.

1 ST	BOWER	5 CWTs	EX STOCK
2 ND	"	4 1/2 "	"
3 RD	"	2 1/2 "	"
40	FATH ^{MS}	1 "	CABLE
60	"	5 1/2 "	HAWSER
60	"	4 "	WARP

12.8.04



W/333-0403


Midship Section

Cochrane & Sons

— No 330 ^s —

^s 'Manxman'

Hull Report No. 16439

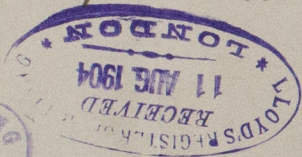

Refined Oils Resin

Grease

RETAIN

W835-0153



© 2020

Lloyd's Register
Foundation