



14.10.14

MIDSHIP SECTION

STEEL SCREW TRAWLER

N° 633

DIMS 120'-0" B.P. * 22'-0" MLD * 12'-6" MLD

SCALE 1/2 INCH.

TO CLASS 100 A.I. LLOYDS STEAM TRAWLER.

DECK PLATED OVER IN WAY OF MACHINERY SPACE.

E. & B. CASING AS PREVIOUSLY APPROVED.

PLAN No. 4820

FOR ENCLOSURE TO


MESSRS LLOYDS SURVEYOR

HULL FROM

COCKING & SONS, LTD.

SHIPBUILDERS, SELBY.

DATE 8/10/14

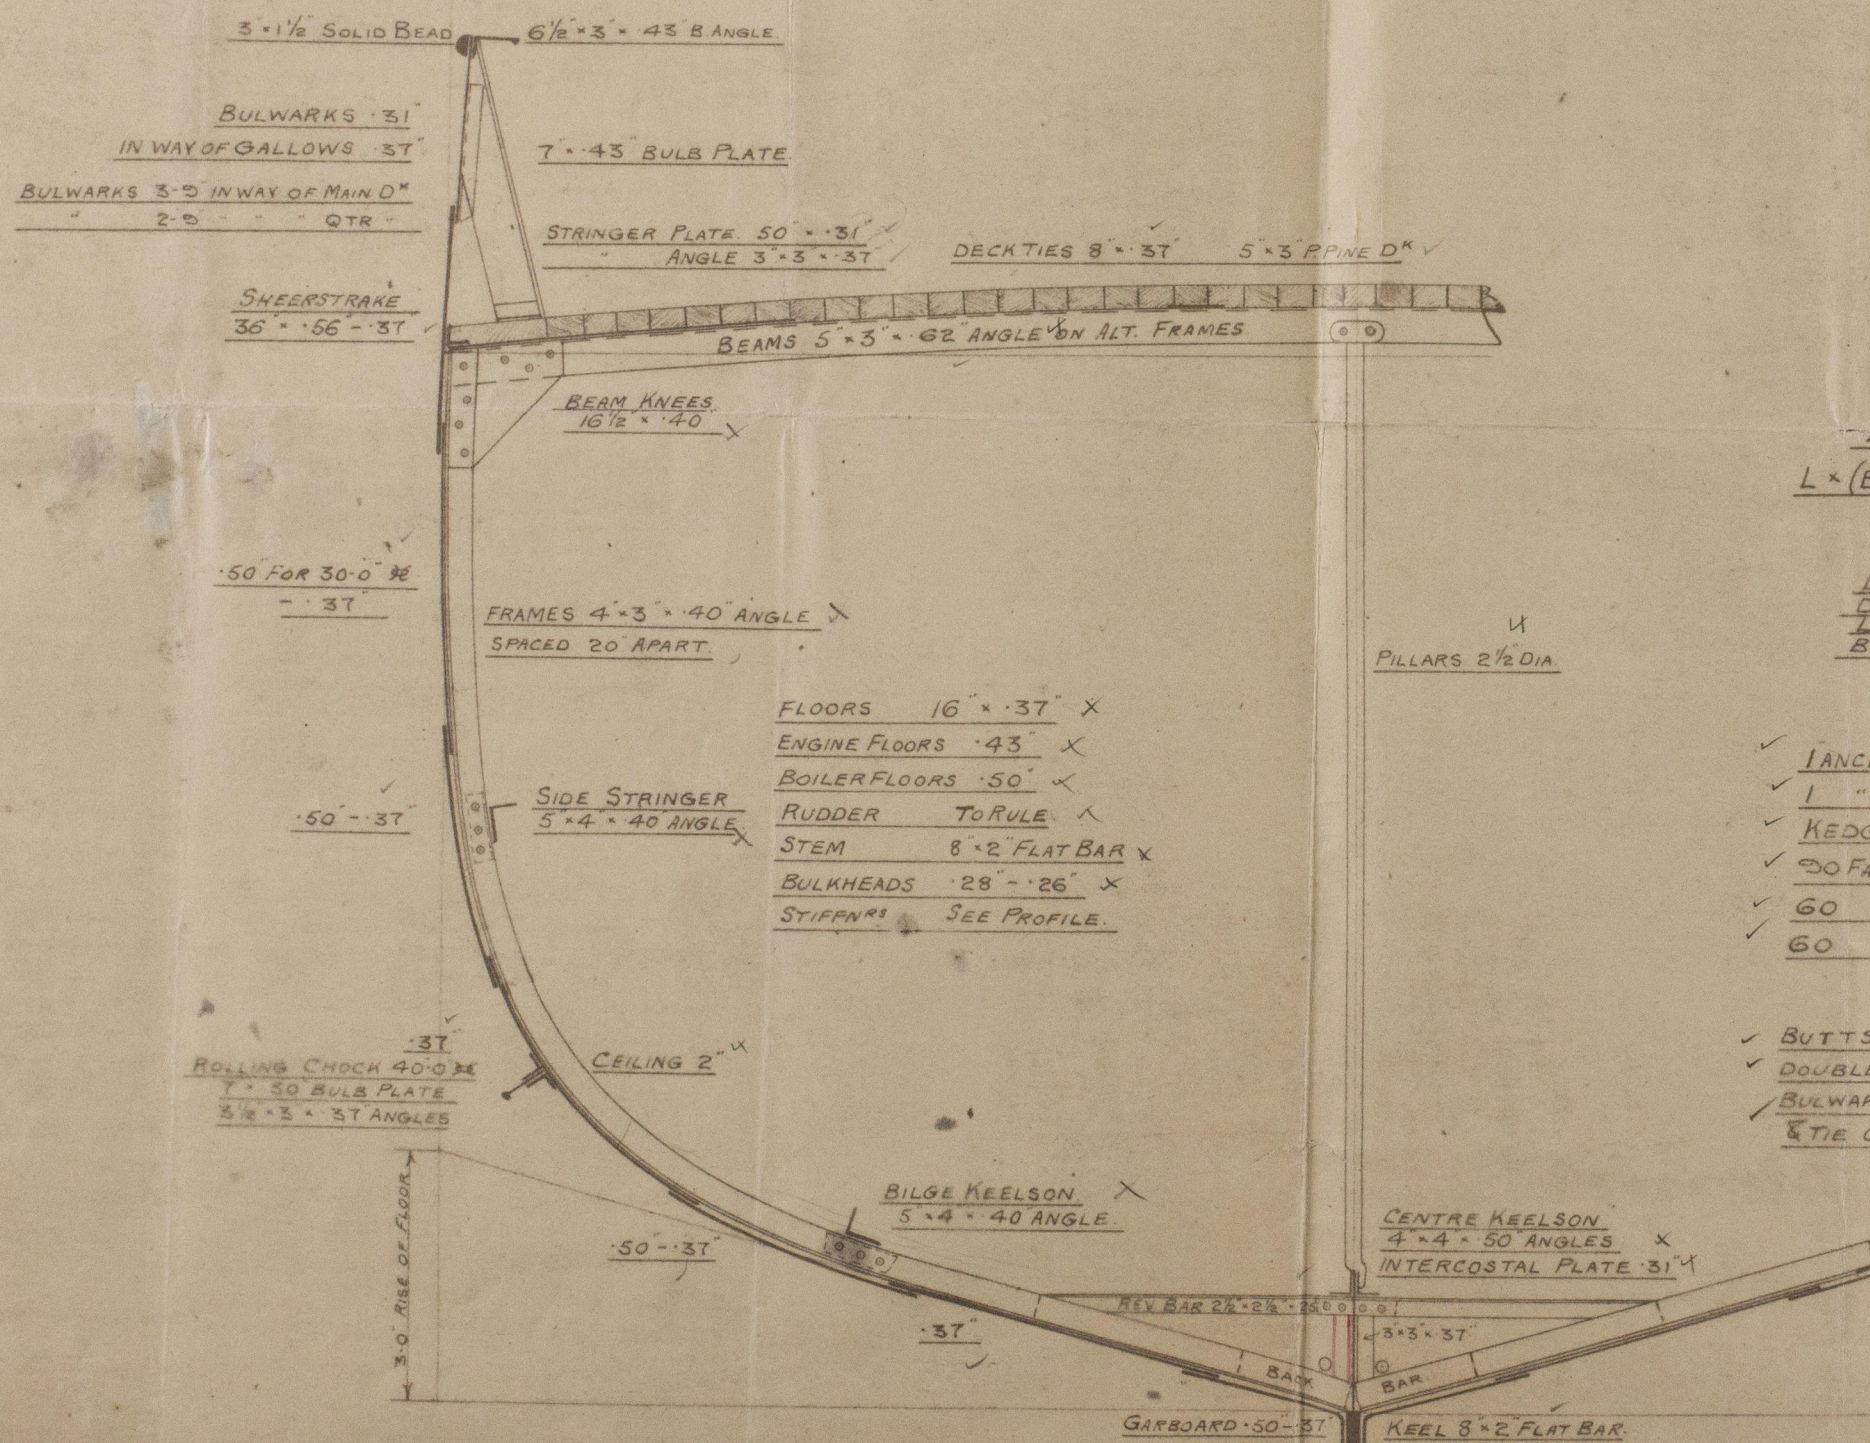

NUMERALS

B+D 34.50
L x (B+D) 4140.00

PROPORTIONS

L/D 9.6
L/B 5.45

EQUIPMENT

- ANCHOR 5 1/4 CWTs EX STOCK OR 6 1/2 CWTs STOCK
- 1 " 4 3/4 " " " 6 "
- KEDGE 2 1/2 "
- 50 FATHOMS 1" STUD LINK CABLE.
- 60 " 6" HAWSER
- 60 " 4 1/2" WARP

RIVETING

- BUTTS OF SHELL PLATING TO BE STRAPPED & DOUBLE RIVETED. LANDINGS DOUBLE RIVETED.
- BULWARKS SINGLE RIVETED. BUTTS OF STRINGER & TIE OVERLAPPED & DOUBLE RIVETED.

14.10.14



© 2020

Lloyd's Register Foundation

W835-0171

Cochran's
Midship Section

S.J. Manna Queen Hull Rpt. 1879
28679

W835-0171

RETAIN



© 2020

Lloyd's Register
Foundation