

# MIDSHIP SECTION. S.S. N° 325.

DIMENSIONS: 128'-4" X 22'-0" X 12'-0" DEPTH OF HOLD

SCALE 1" = ONE FT.

STEEL

CLASS 100A1

FOR FISHING PURPOSES.

Cook, Melton & Semmell,

Shipbuilders.

HULL,

21-3-02

LLOYDS N° 5

1/2 GIRTH 20.25

1/2 BREADTH 10.33

DEPTH 13.33

44.51 157 N°

LLOYDS LENGTH 127.17

5660.33 2° N°

1/8 5.8

1/8 9.5

ANCHORS & CHAINS	
ONE ANCHOR	5 1/4 CWT EX STOCK
"	5 1/4 "
"	3 "
105 FATHOMS	1 1/8 CHAIN
60 "	6 " HAWSER
60 "	5 " WARP

RAISED QUARTER DECK 51'0" LONG X 12'  
SCANTLINGS SAME AS MAIN DECK.

HOLLOW BEAM  
3 x 1 1/2

BULB ANGLE  
6 1/2 x 3 x 7/16  
1 3/8 DIAR

1/8 IN WAY OF RQD

SINGLE LAP  
3 x 5/8 RIVETS

3 x 3 = 3/8

34 x 10-1/16

DOUBLE LAP  
3/4 RIVETS

47 x 6/16

DOUBLE LAP  
3/4 RIVETS

39 x 7-6/16

DOUBLE LAP  
3/4 RIVETS

BULB 7-6/16

ANGLES 3 x 3 x 3/8

39 x 6/16

DOUBLE LAP  
3/4 RIVETS

39 x 7-6/16

DOUBLE LAP  
3/4 RIVETS

47 x 6/16

DOUBLE LAP  
3/4 RIVETS

34 x 2

BULB 8 1/2 x 3  
ANGLES 5 x 3 x 7/16

CONCRETE BALLAST

WOOD DECK 5 x 3

BEAMS 5 x 3 x 1/2

ON ALTERNATE FRAMES

STRINGER PLATE  
26 x 3/8 TO 17 x 5/16

3 x 3 = 3/8 IN WAY OF RQD ONLY

FRAMES 3 x 2 1/2 x 5/16 SPACED 20' APART  
REV FRAMES 2 1/2 x 2 1/2 x 5/16 TOPPER TURN OF BILGE  
" " TO BILGE & QUARTER DECK  
ALTERNATELY IN WAY OF R.Q.D.  
REV FRAMES DOUBLE IN E & B SPACE.  
KEEL 4 x 1 3/8 STEM 8 x 2  
STERNFRAME 6 x 3  
RUDDER HEAD 4 1/2, KEEL 3 x 2 1/2  
BULKHEADS 1/4 STIFFENED AS PER RULE  
FLOORS 16 x 5/16 & 1/16 IN E & B SPACE.  
HOLD STANCHIONS 2 1/2 DIAR & AS PER RULE.

IN LIEU OF PLATE STRINGER 12 x 1  
5 x 3 x 9/16

BUTTSTRAPS OF SHEERSTRAKE  
AND ONE STRAKE AT BILGE 1/8  
THICKER THAN PLATES THEY  
CONNECT & DOUBLE RIVETTED.  
STRINGERS DOUBLE BUTT LAPS  
4/4 WIDE.

BUTTSTRAPS 3/4 RIVETS

3 3/4 x 11-8/16

BUTTSTRAPS 5/8 RIVETS

8 x 9/16

END OF REVERSE FRAME  
IN WAY OF MAIN DECK

5 x 3 x 3/8

BUTTSTRAPS 6-5/8 RIVETS

3 3/4 x 16 TO 8 x 16

BUTTSTRAPS 5/8 RIVETS

8 x 7/16

BUTTSTRAPS 6-5/8 RIVETS

3 3/4 x 16 TO 8 x 16

BUTTSTRAPS 5/8 RIVETS

8 x 9/16

BUTTSTRAPS 3/4 RIVETS

3 3/4 x 10


LR

REGISTERED  
2 MAR 1902

N 836 - 0087






Will Cooks

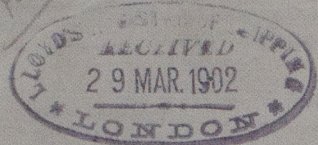

325

s/s Mackenzie  
Hull Report No. 14957

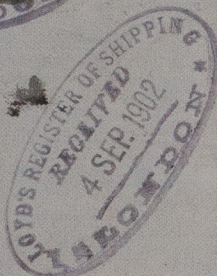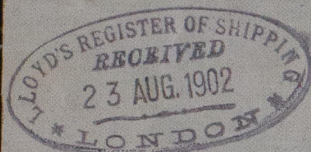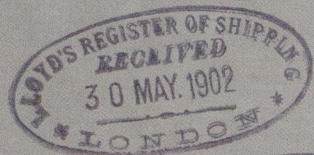

RETAIN

W836-0037



© 2021

Lloyd's Register  
Foundation