

9.5.06.

MIDSHIP SECTION.

— STEEL SCREW TRAWLER. —

— N^o 376. —

Dim. 117'-6" x 21'-6" x 11'-6" HOLD, 12'-3" DEPTH MOULDED.

SCALE $\frac{1}{2}$ " = 1. FOOT.

To CLASS 100.A.1. AT LLOYDS FOR FISHING PURPOSES.

DECK PLATED AT SIDES OF ENGINE & BOILER CASING.
CASING (E & B) AS PREVIOUSLY APPROVED.



LLOYDS NUMBERS.

1 st GIRTH	18.91.
2 nd BREADTH	10.70.
DEPTH	12.69.
	42.30 1 st N ^o
LENGTH AS PER RULE	116.20
	4915.26 2 nd N ^o


D to L ----- 9.15.
B " L ----- 5.5

EQUIPMENT.

1 st BOWER	5	CWTS EX STOCK.
2 nd "	4 1/2	" "
3 rd "	2 1/2	" "
90 FATH ^s	1	CABLE
60 "	5 1/2	HAWSER
60 "	4	WARP.

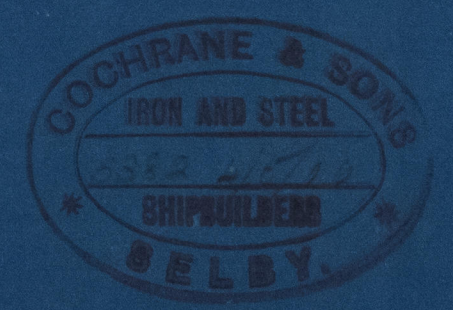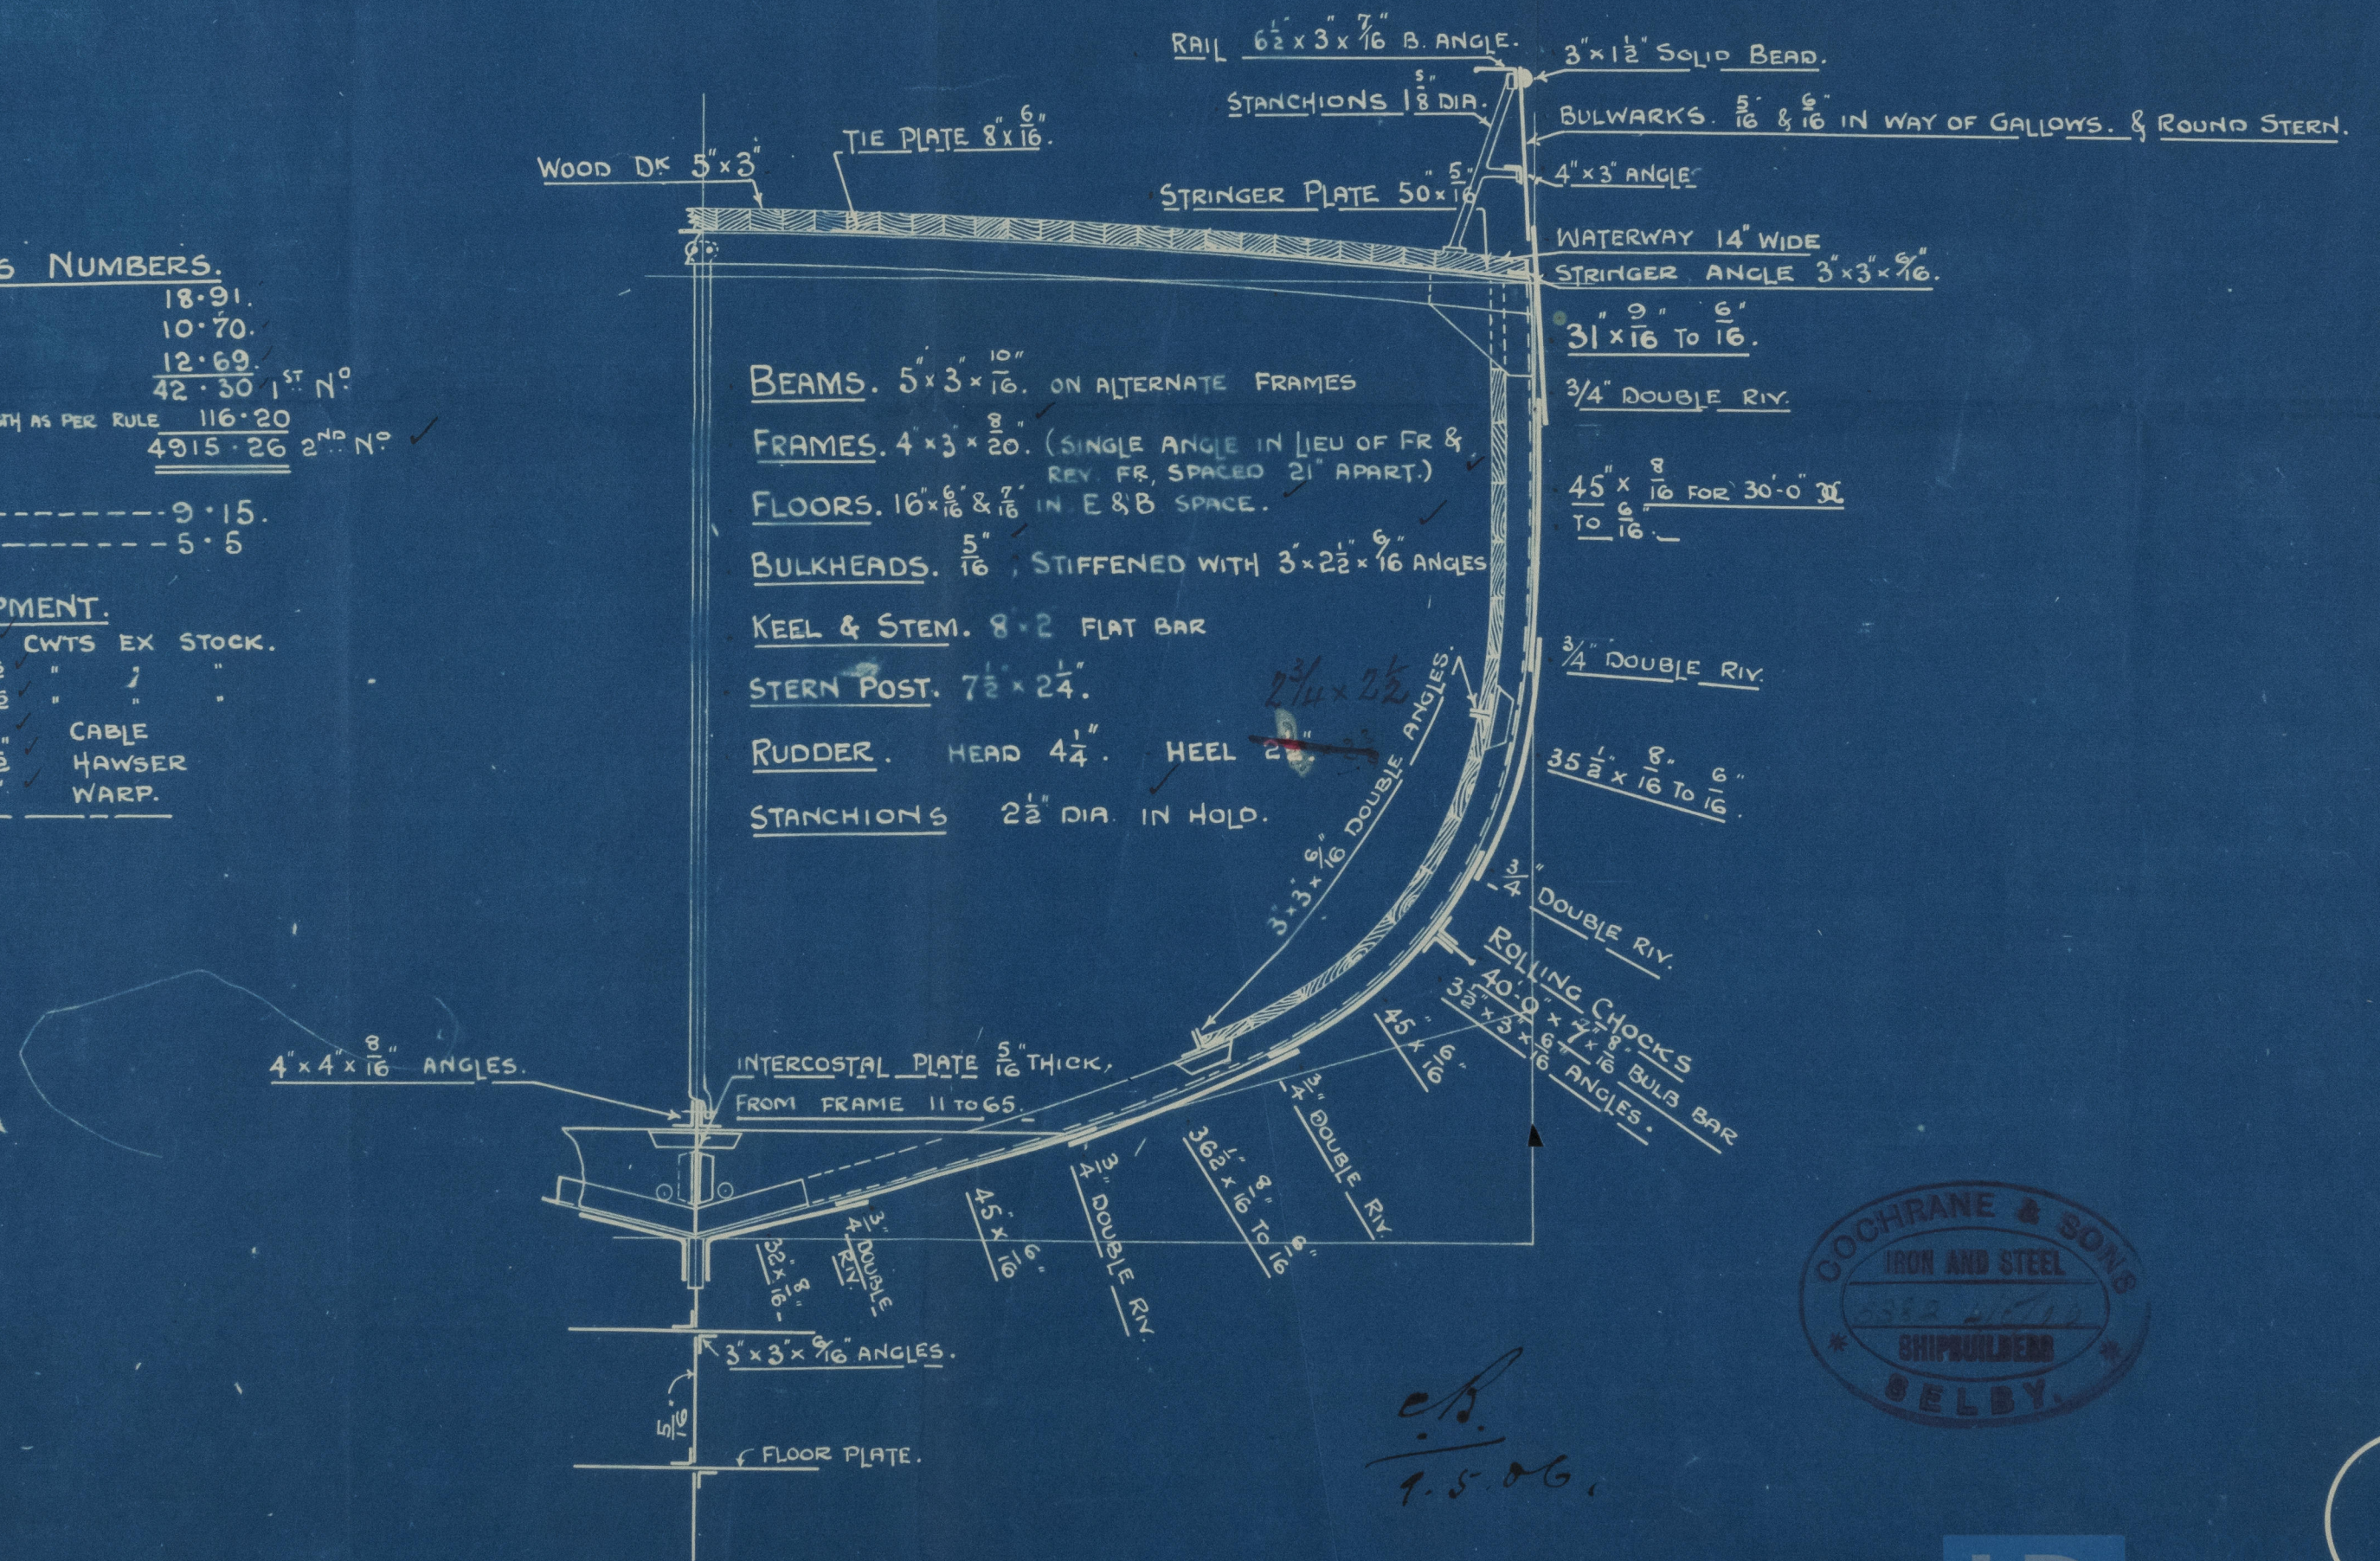


ch.
9.5.06.

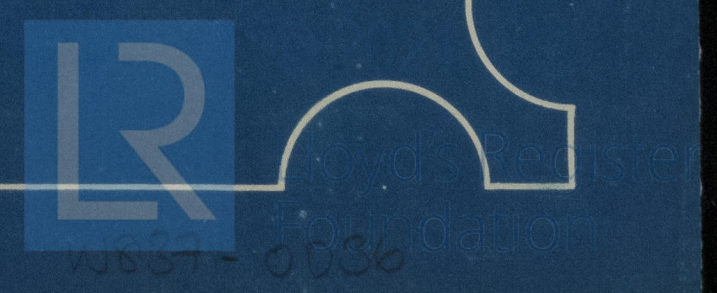

Cochran & Son

No 346

Midship Section.

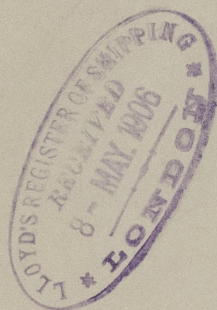

s/s " Many Lucca "
Hull Report No. 18357.



RETAIN



© 2021

Lloyd's Register
Foundation

W837-0036