

21-4-10

9183

Mr. Lloyd's Surveyors
Hall

17/4/10. Rk.


MIDSHIP SECTION

STEEL SCREW TRAWLER

N^{OS} 466-7

DIM^{NS} LENGTH 120'-0" B.P. x 21'-6" EX. x 12'-3" DEPTH MOULDED
SCALE 1/2" = ONE FOOT

TO CLASS 100 A1 AT LLOYDS FOR FISHING PURPOSES
DECK PLATED OVER IN WAY OF MACHINERY SPACE
ENGINE & BOILER CASING AS PREVIOUSLY APPROVED

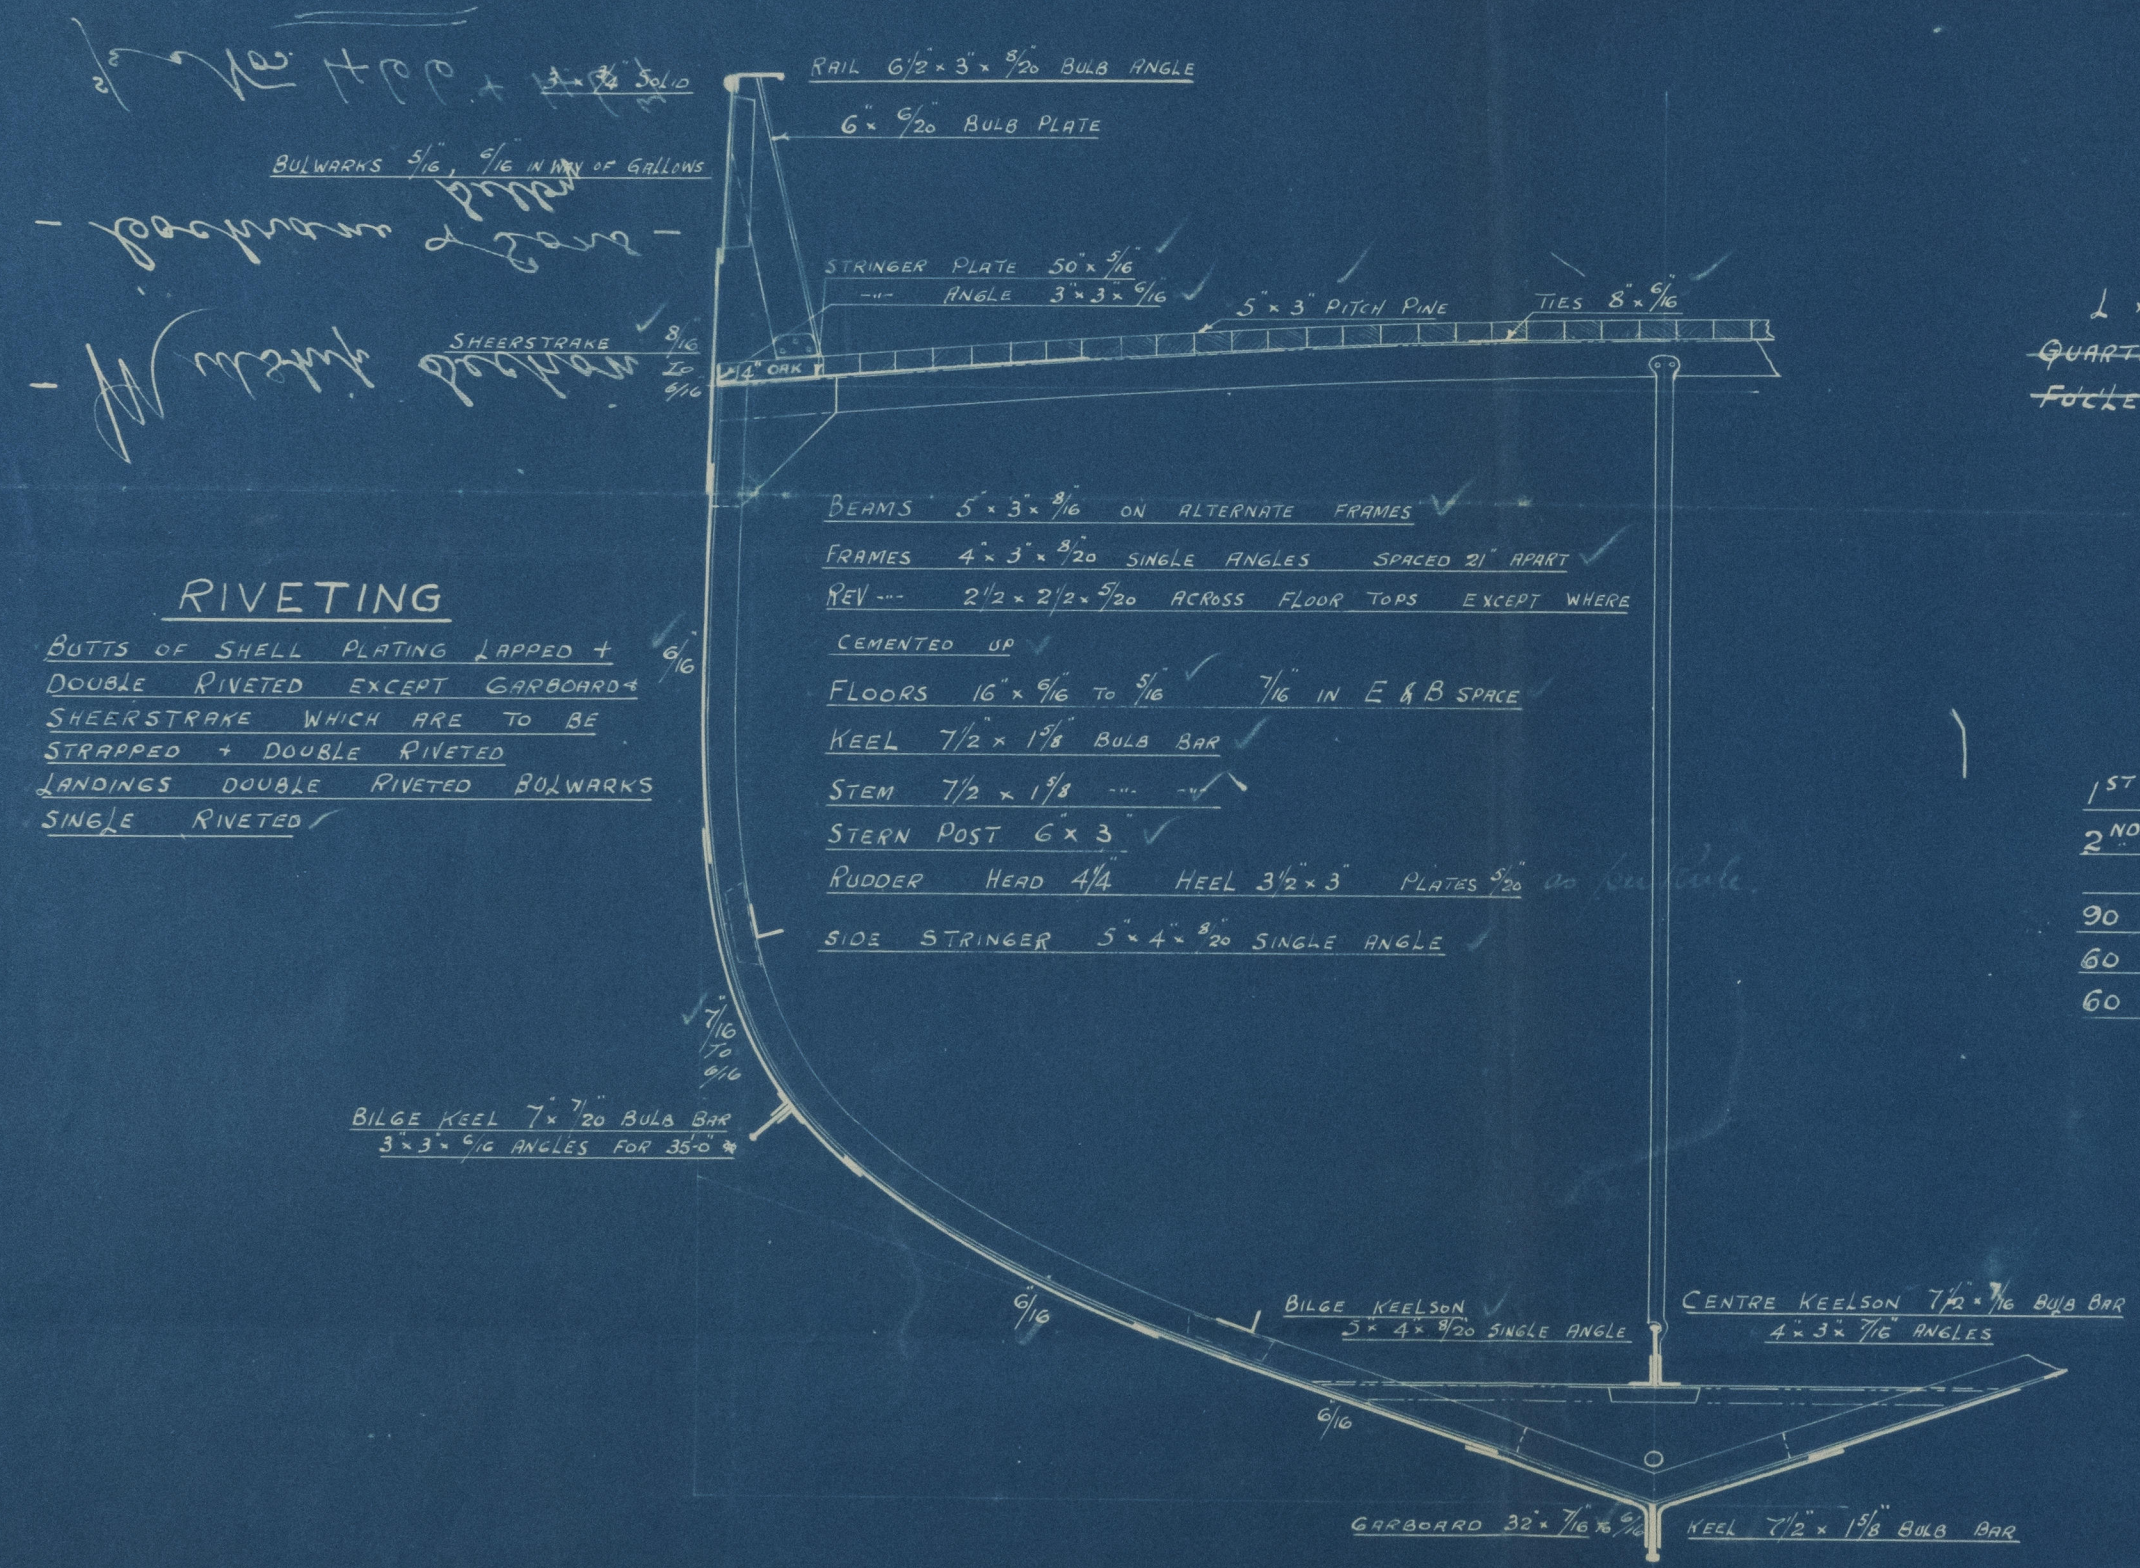

RIVETING

BUTTS OF SHELL PLATING LAPPED +
DOUBLE RIVETED EXCEPT GARBOARD +
SHEER STRAKE WHICH ARE TO BE
STRAPPED + DOUBLE RIVETED
LANDINGS DOUBLE RIVETED BULWARKS
SINGLE RIVETED

NUMERALS

B + D = 33.625
L x (B + D) = 4035
QUARTER D^K 68 x 1 = 68
FOUR D^K 185 x 375 x 75 = 52.03
EQUIPMENT N^O ~~4188-655~~ 4035

PROPORTIONS

L/D = 9.75
L/B = 5.61

EQUIPMENT

1 ST	BOWER ANCHOR	5 5/16 CWTs	EX STOCK
2 ND	"	4 3/4	"
	KEEDGE ANCHOR	2 1/2	"
30	FATHOMS	1" CABLE	
60	"	5 1/2 HAWSER	
60	"	4 1/4 WARP	



Lloyd's Register
Foundation

Cochrane & Sons

No 4664 Y

Duplicate.

Midship Section.

of Bureau

Hull Rpt No. 22971

RETAIN

W837-0051



© 2021

Lloyd's Register
Foundation