


1. 12.05

DECK PLAN OF CARGO STEAMER

YARD N^o 265

SCALE 1/4" = 1 FOOT.

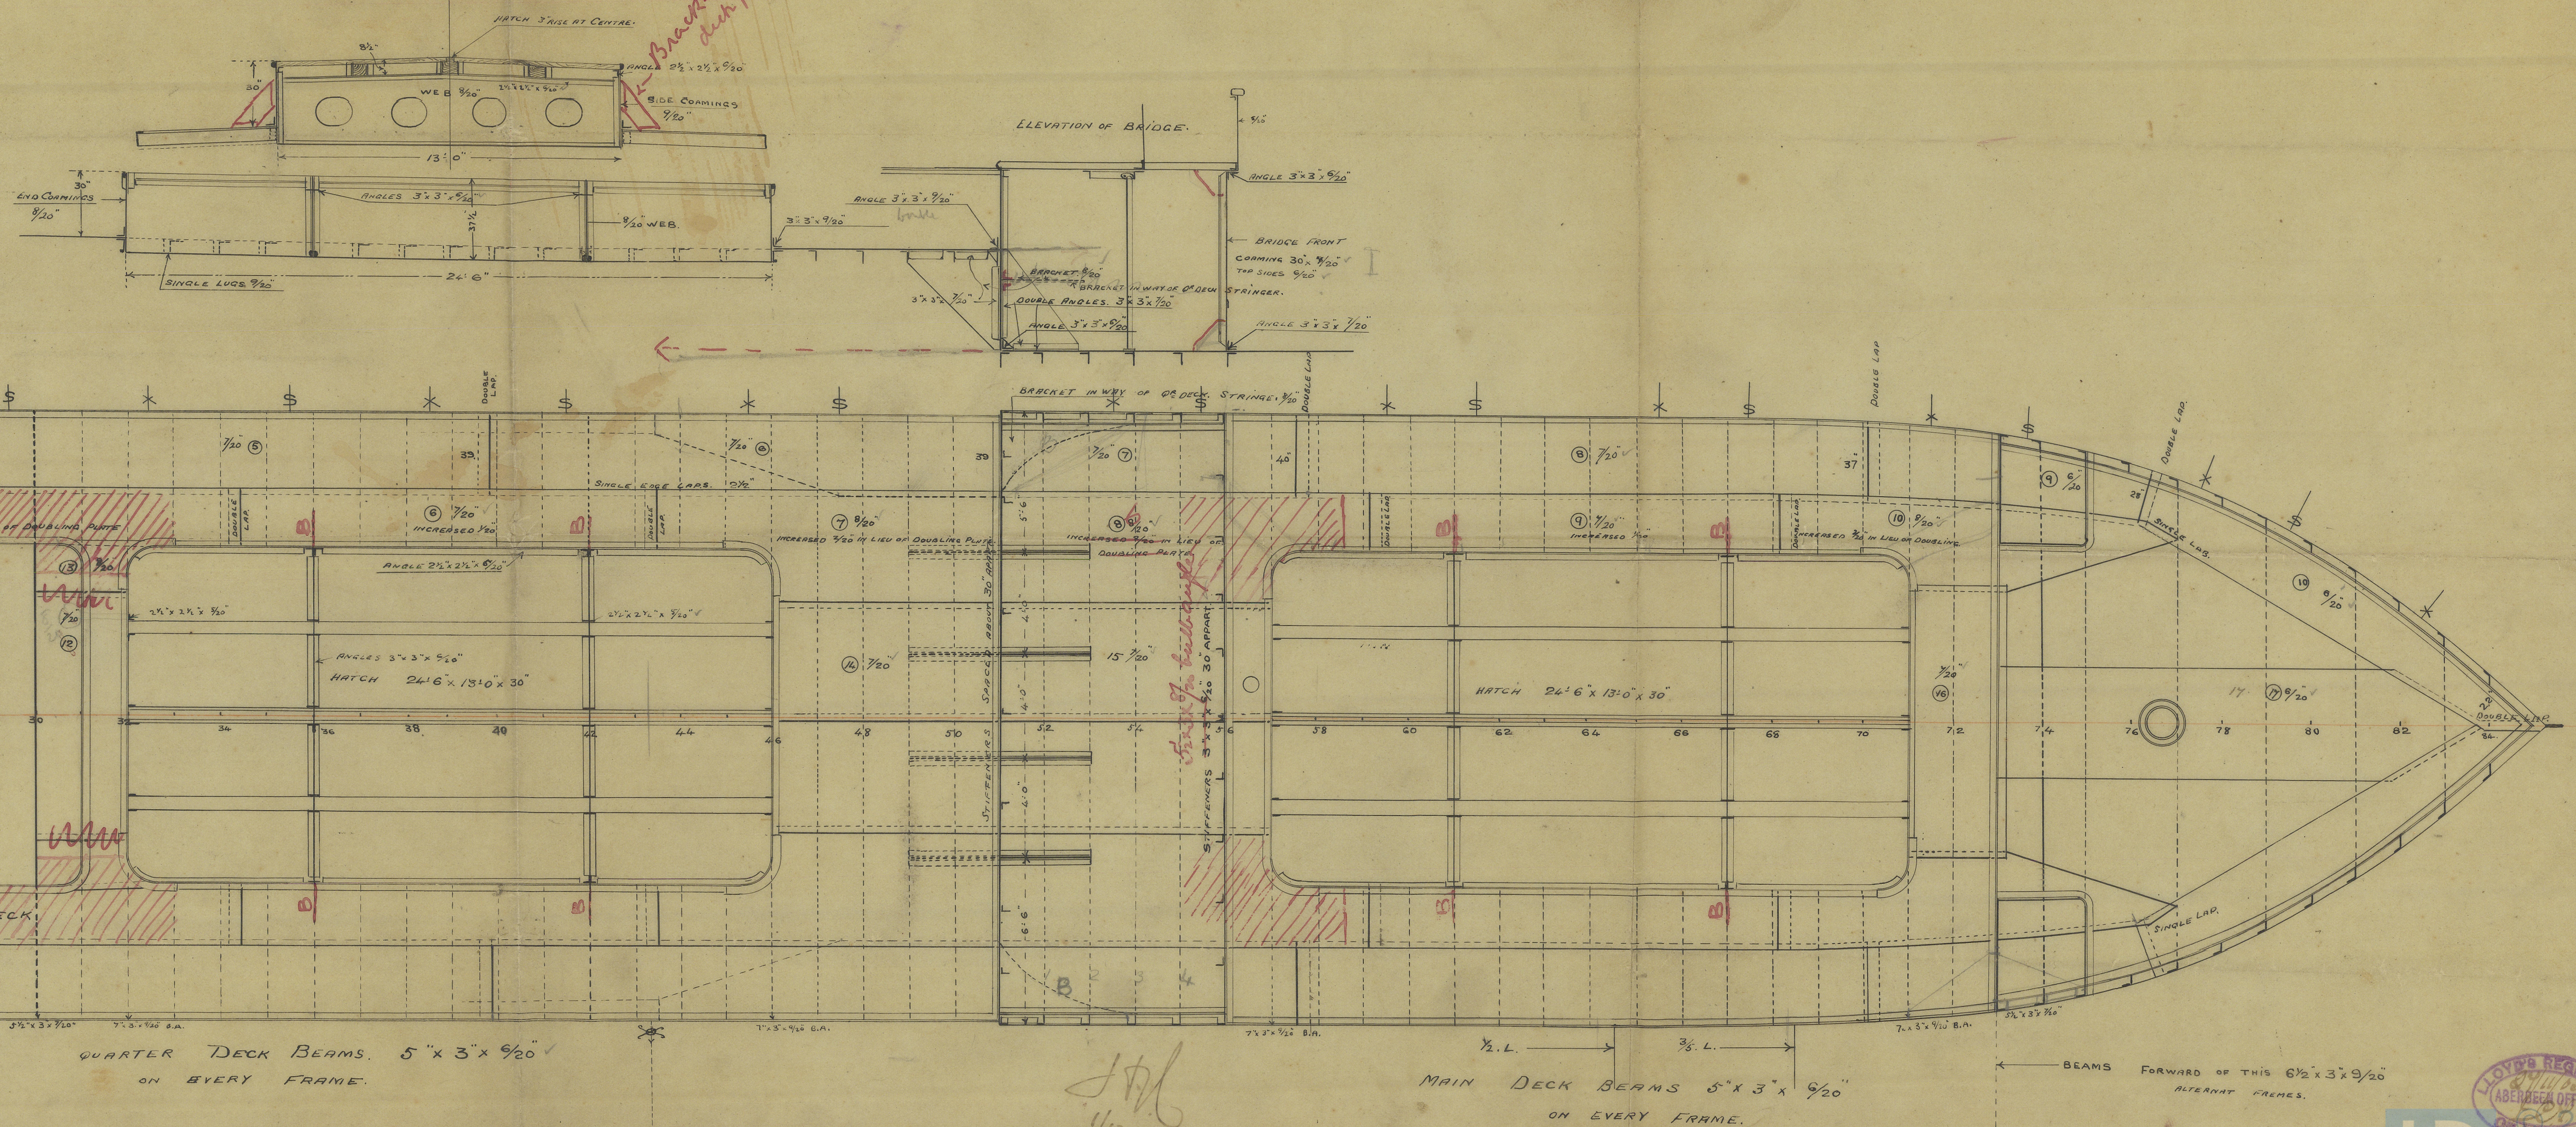


J. Guthrie & Co. Ld.

S.S. R-265

Deck plan

S.S. "Marion"

Abt. Rpt. 8929

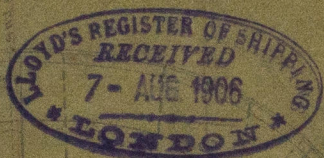

© 2020

Lloyd's Register
Foundation

W839-0102