

MIDSHIP SECTION

DIMENSIONS.

LENGTH B.P. 190'0" BREADTH EX 30'0" DEPTH M¹⁵ 15'0"

TO CLASS 100.A. AT LLOYDS. RAISED QUARTER DECK.

1/2" SCALE.

4.3.04
12.3.04

LLOYDS DIMENSIONS

LENGTH FROM FORE SIDE OF POST TO AFT SIDE OF STEM	188'0"
BREADTH MOULDED	29'9 1/2"
DEPTH, ASSUMING 1/2" ROUND UP OF BEAM	15'8"
DEPTH TO LENGTH	11.99


NUMERALS.

1/2 BREADTH	14.89
DEPTH	15.67
1/2 GIRTH	27.41
57.97 1/4 N°	
188 LENGTH	
10898 1/2 N°	




EQUIPMENT.


ERECTIONS. QUARTER DK 37'2". BRIDGE 16'6". FORE 21'2".
EQUIPMENT N° 11875. GRADES. 11600-12700. LETTER K.

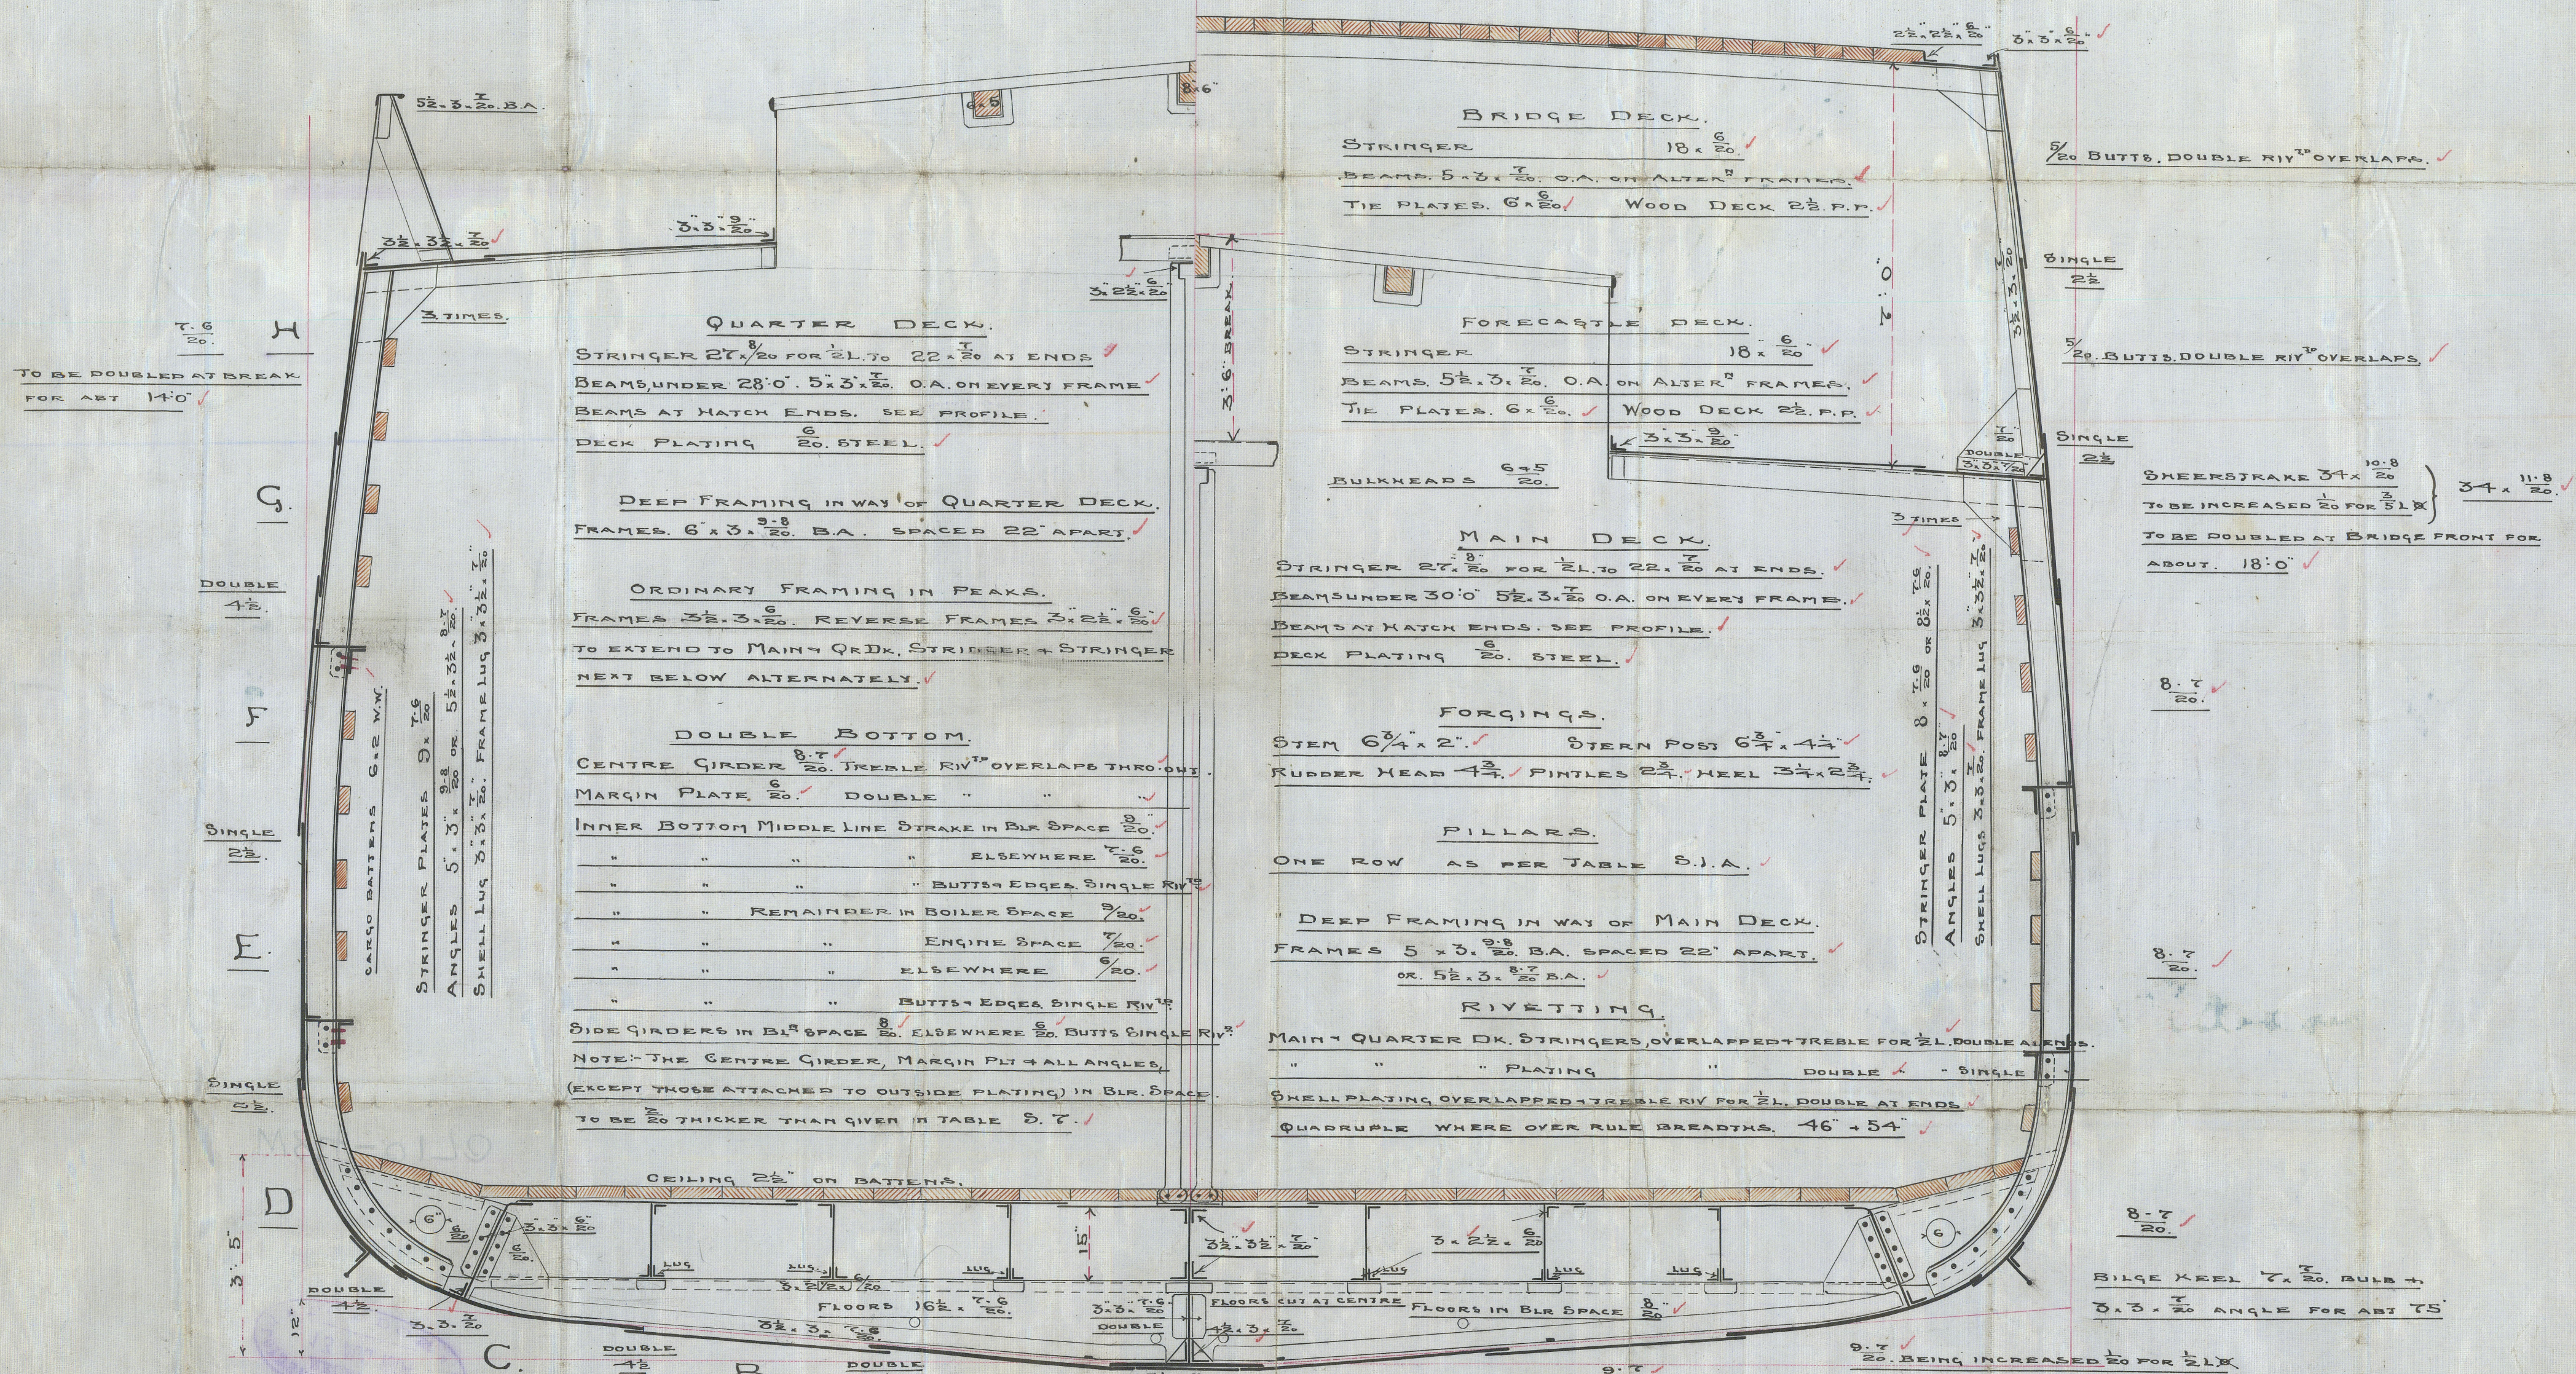

Butts of tank top, don't rivet in engine boiler space

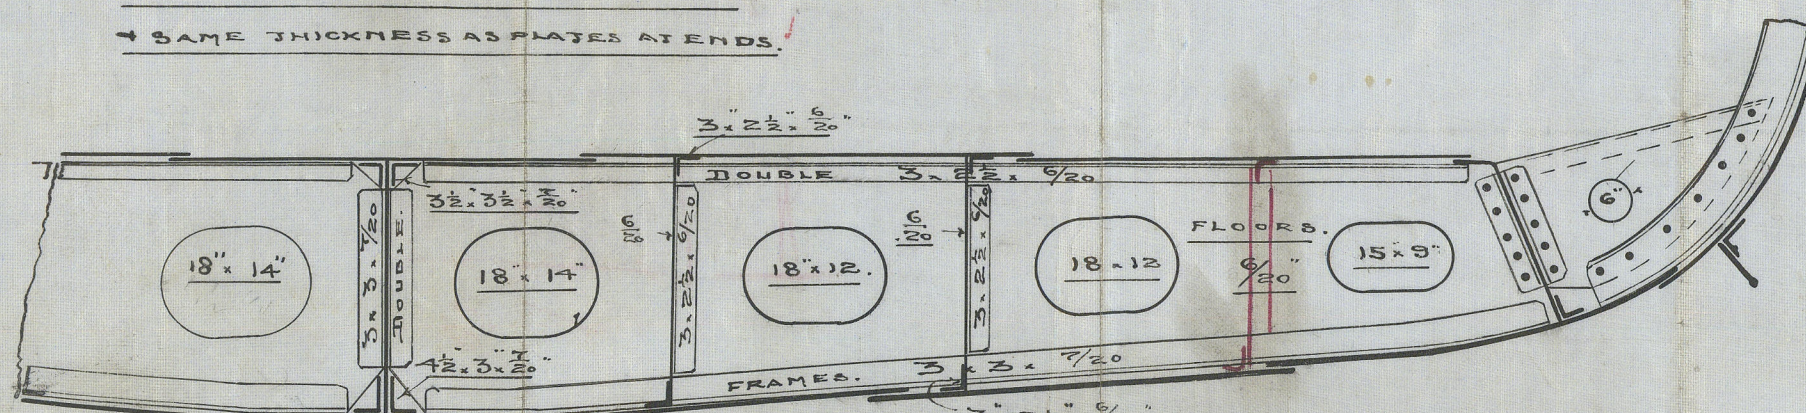

W¹⁰ HARKNESS & SON LTD
SHIPBUILDERS & REPAIRERS,
EAST SLIPWAY,
MIDDLESBROUGH-ON-TEES.

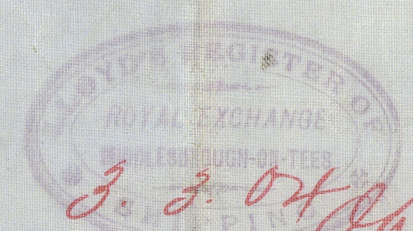

C. 7
H. 3. 04

N° 15



Midship Section

W. Starkes & Son

Nº 161

Cherrybrook

Mdd. Rpt. No.

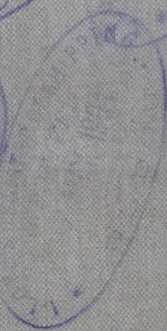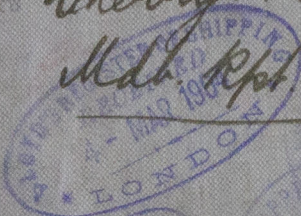

© 2020

Lloyd's Register
Foundation
W84-0170