


# PROFILE AND DECK PLANS

DIMENSIONS- LENGTH B.P. 190'-0" BREADTH EX. 30'-0" DEPTH MOULDED 15'-0"


TO CLASS 100A1 AT LLOYDS "RAISED QUARTER DECK"

SCALE 1/8" = ONE FOOT.



4.3.04  
12.3.04

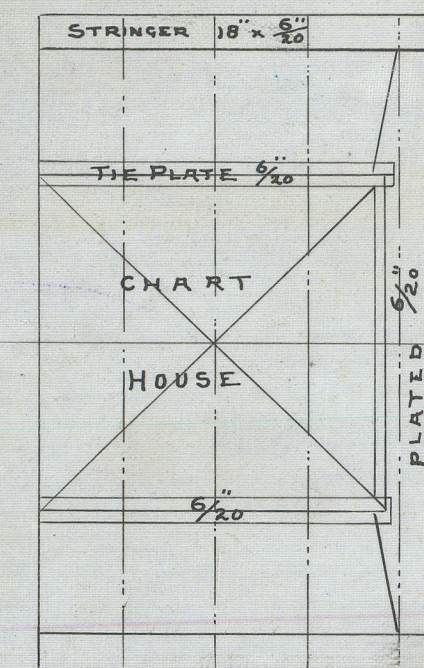


BRIDGE DECK

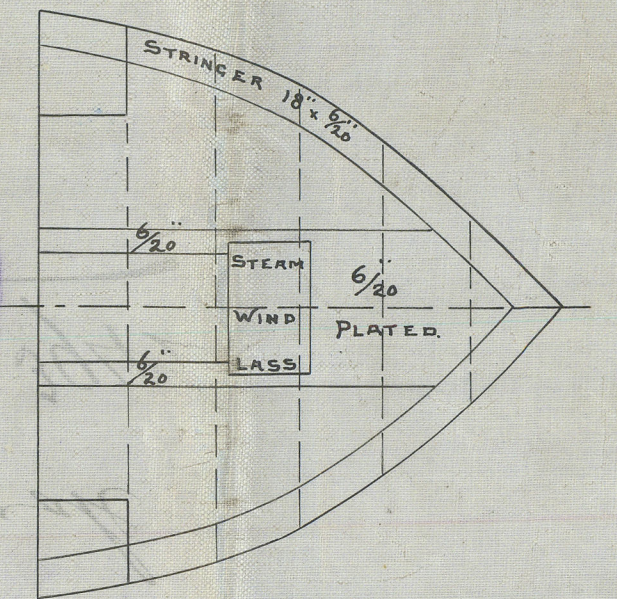

FORECASTLE DECK.

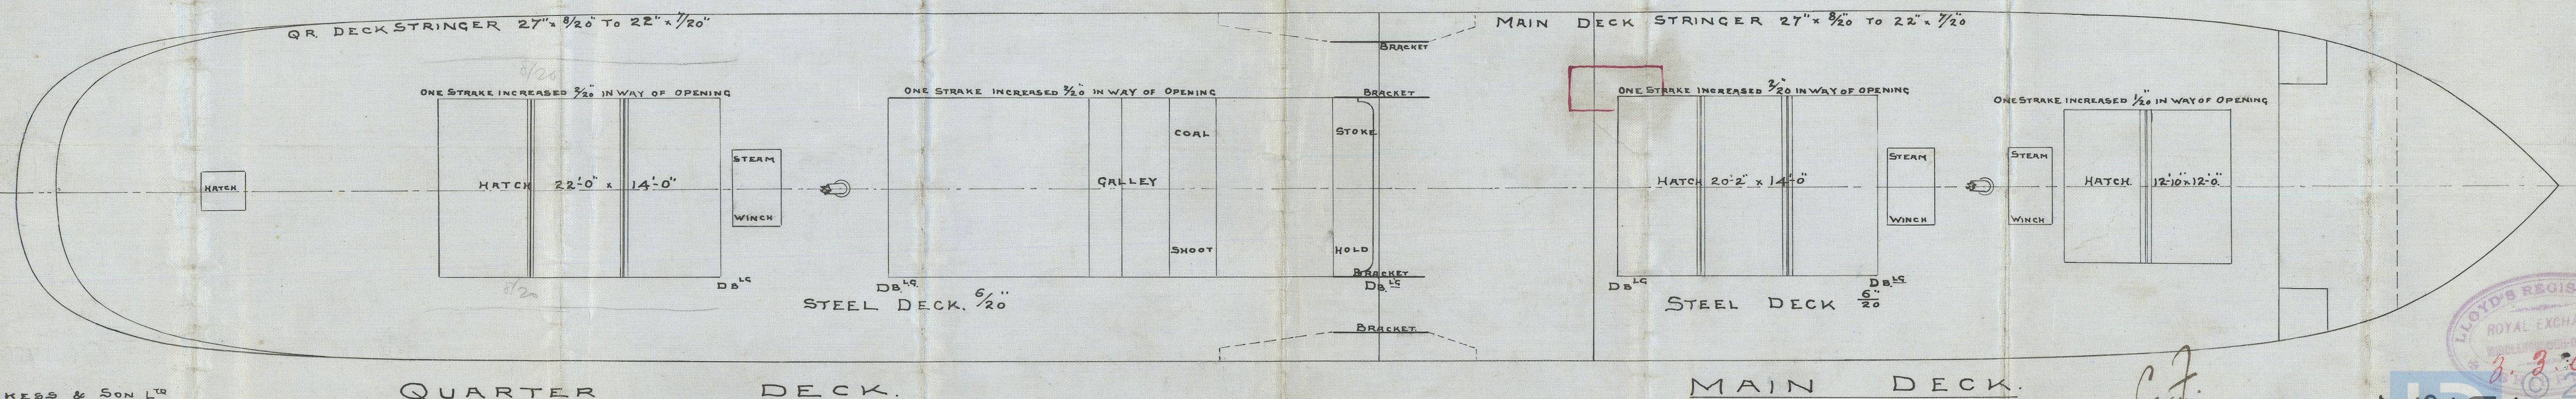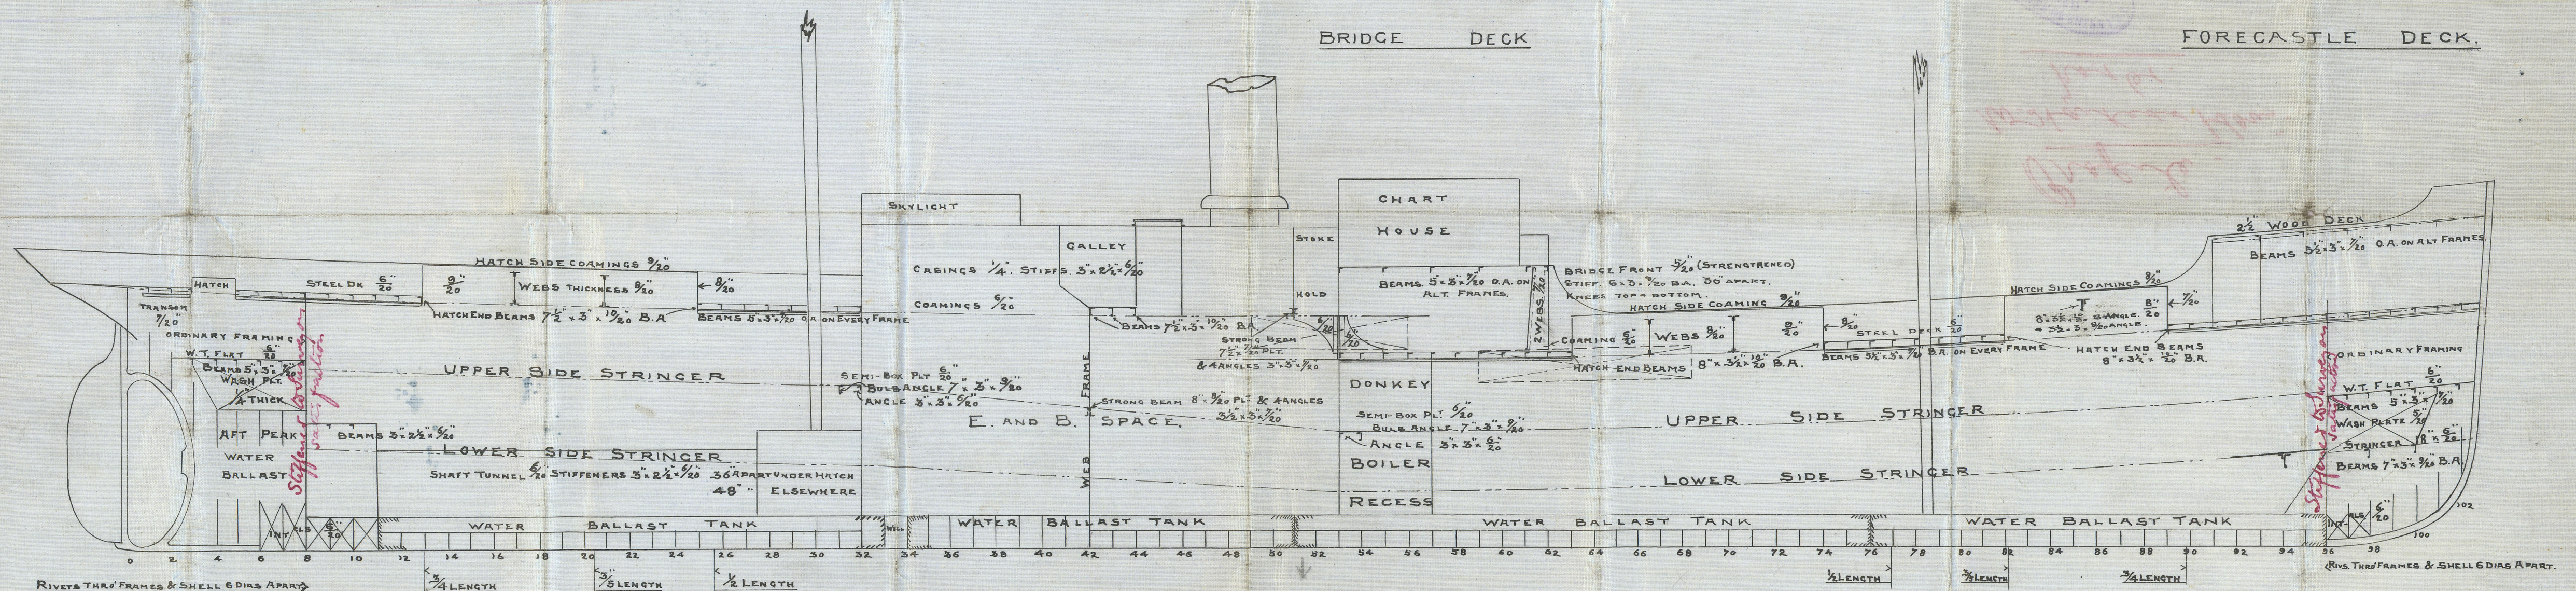

W. HARKNESS & SON LTD  
SHIPBUILDERS & REPAIRERS  
EAST SLIPWAY  
MIDDLESBROUGH-ON-TEES.

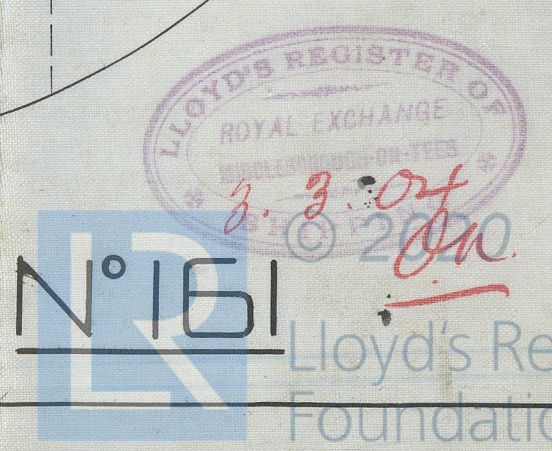

W84-0171



Profile






© 2020

Lloyd's Register

W84 Foundation